


21706222000

U. S. PUBLIC LAND SURVEY MONUMENT RECORD

SECTION 22 T 17 N, R 6 W, TOWN OF HAMILTON

LA CROSSE COUNTY

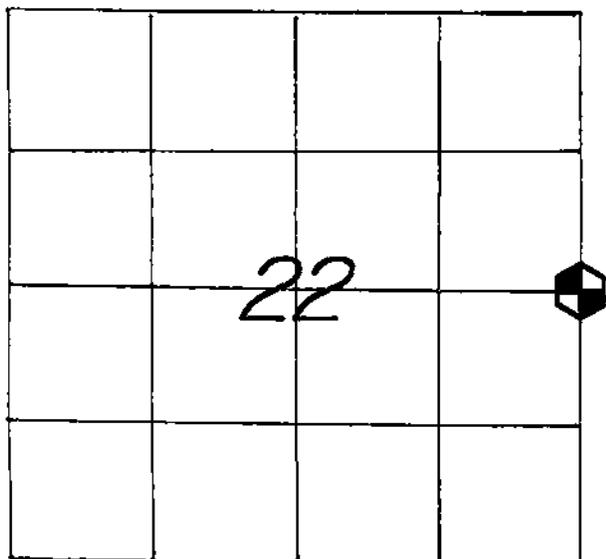

WISCONSIN COORDINATE SYSTEM

North *707,148.348*East *1,686,201.826*

Theta Angle

Horiz. Order

Vert. Order

DATUM: *1983('91)*

TYPE OF LANDMARK

BRASS CAP LUNDE MARKER.

BEARINGS ARE REFERENCED TO

GRID NORTH AS PER SECTION DATA.

LOCATION OF LANDMARK

CREW: *WILLIAM C. JUNG*
PETER F. FOLLANSBEE
 DATE: *4/05/2006*

Describe any record evidence, monument evidence, testimonial evidence or any other material evidence you considered and whether the monument was found or restored through acceptance of an obliterated evidence location.


We found a bent unrecorded pipe at this corner North of a fence post where the wire tied off East-West. This location falls about 6.8 feet South and about 2.5 feet East of the single proportionate position. I accepted this location as the best available evidence of the original government corner position and replaced the pipe with a brass capped Lunde.

Describe or show any material discrepancy between the location of the restored corner and that of the corner previously restored or reestablished.

NONE KNOWN.


RECORD OF DURABLE WITNESS MONUMENTS

NO	DESCRIPTION	BEARING	DISTANCE
1	SET A 1-5/8" (O.D.) x 4' IRON PIPE UNDER THE FENCE	WEST ±	16.41 FT.
2	SET A 3/4" x 30" IRON BAR WITH A RED PLASTIC CAP	NORTH ±	16.53 FT.
3	SET A 3/4" x 30" IRON BAR WITH A RED PLASTIC CAP	EAST ±	16.63 FT.
4	SET A 3/4" x 30" IRON BAR WITH A RED PLASTIC CAP	SOUTH ±	16.44 FT.

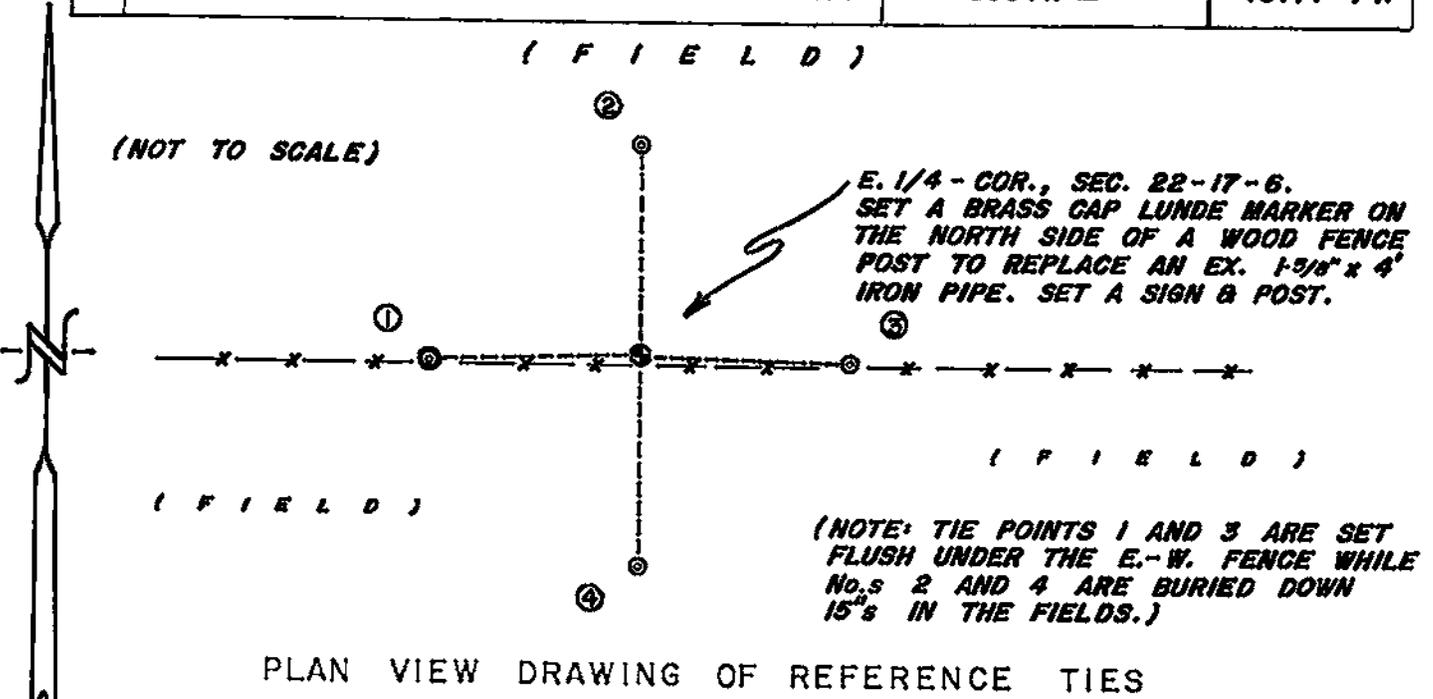

MAP SHOWING DISTANCE AND DIRECTION TO OTHER PUBLIC LAND SURVEY CORNERS USED FOR REESTABLISHING THE CORNER

(GRID BEARINGS AND DISTANCES)
(GRID FACTOR: 0.999938)
(NOT TO SCALE)

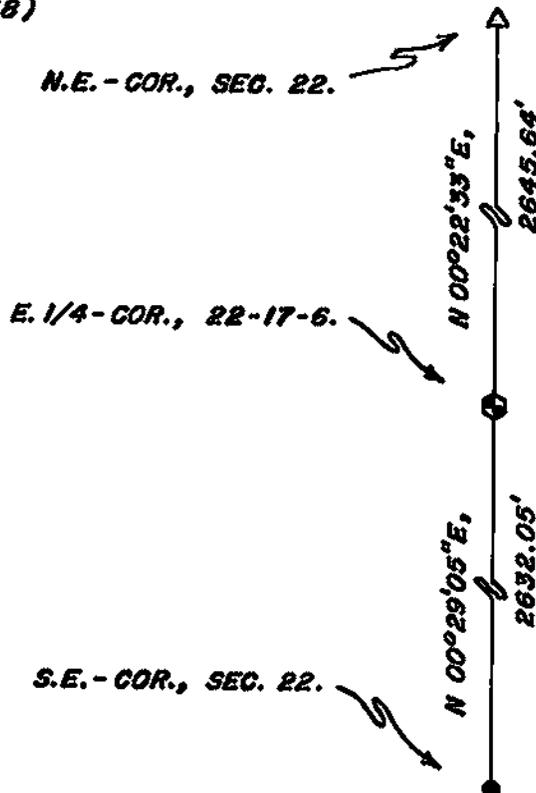

I, WILLIAM C. JUNG, COUNTY SURVEYOR
HEREBY CERTIFY THAT THE CORNER LOCATION SHOWN ON THIS RECORD WAS DETERMINED BY ME OR UNDER MY DIRECTION AND CONTROL AND THAT THIS U. S. PUBLIC LAND SURVEY MONUMENT RECORD IS CORRECT AND COMPLETE TO THE BEST OF MY KNOWLEDGE AND BELIEF.

William C. Jung 5/1/06
Signature Date



Seal