


U. S. PUBLIC LAND SURVEY MONUMENT RECORD

SECTION 23 T 17 N, R 6 W, TOWN OF HAMILTON

LA CROSSE COUNTY

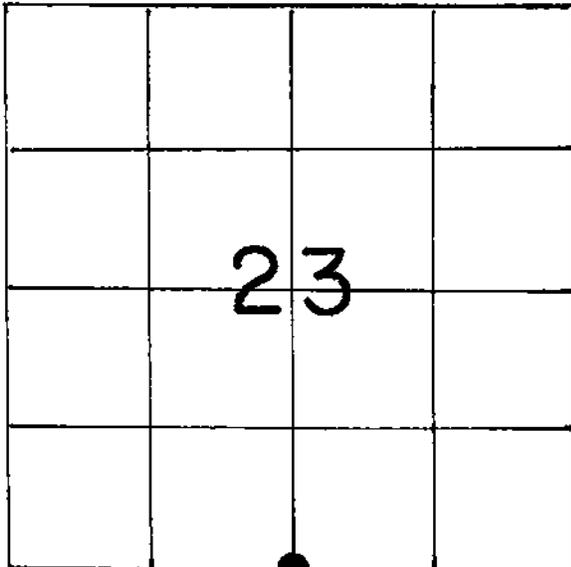

LOCATION OF LANDMARK

Crew: William Jung
Perry Dahl
11/12/84

WISCONSIN COORDINATE SYSTEM
North
East
Theta Angle
Horiz. Order
Vert. Order
TYPE OF LANDMARK
1/2" IRON ROD
BEARINGS ARE REFERENCED TO

Describe any record evidence, monument evidence, testimonial evidence or any other material evidence you considered and whether the monument was found or restored through acceptance of an obliterated evidence location.

This location has been used as the corner in previous surveys including highway surveys, a survey done by Berg in Section 23 in January of 1983, and a survey by Lampman in Section 26 in July of 1985. I accepted the position of the iron rod as the best available evidence of the original government corner.


Describe or show any material discrepancy between the location of the restored corner and that of the corner previously restored or reestablished.

None known.

RECORD OF DURABLE WITNESS MONUMENTS

NO	DESCRIPTION	BEARING	DISTANCE
1	Set 1 1/4" Iron Pipe	S89°02'00"W	33.03'
2	Existing P.K. Nail	N00°01'00"E	458.90'
3	Nail In 32" Unblazed White Pine	N67°08'00"E	99.37'
4	Set 1 1/4" Iron Pipe	N88°54'00"E	33.16'

(Bearings are referenced to Berg's 1/22/83 survey.)

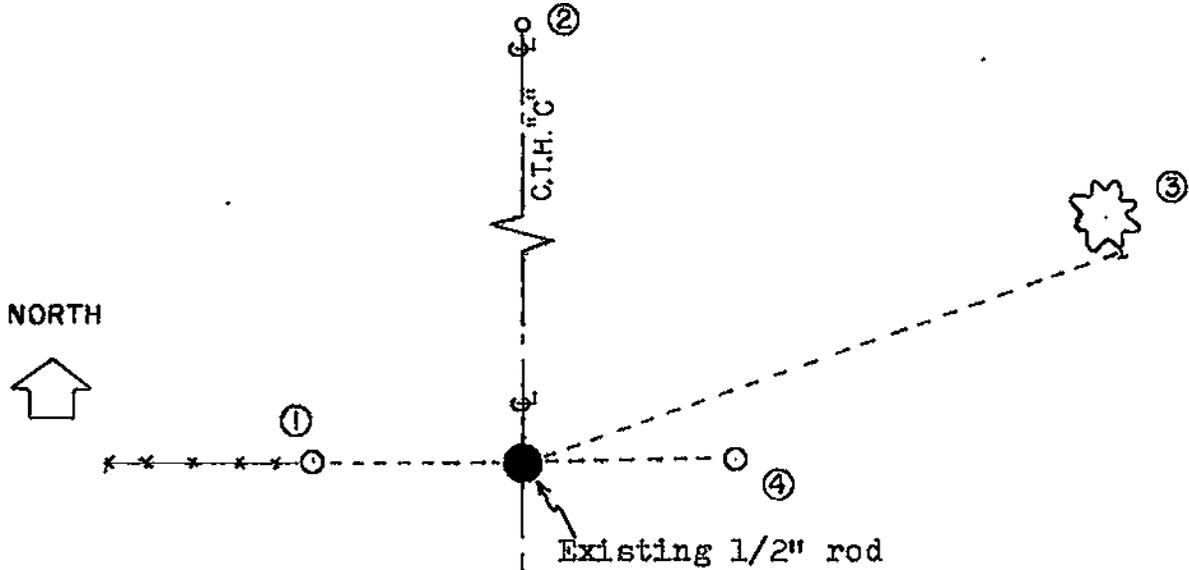


PLAN VIEW DRAWING OF REFERENCE TIES

MAP SHOWING DISTANCE AND DIRECTION TO OTHER PUBLIC LAND SURVEY CORNERS USED FOR REESTABLISHING THE CORNER
 No measurements made by me at this time.

I, William C. Jung, Deputy County Surveyor,
 HEREBY CERTIFY THAT THE CORNER LOCATION SHOWN ON THIS RECORD
 WAS DETERMINED BY ME OR UNDER MY DIRECTION AND CONTROL AND
 THAT THIS U. S. PUBLIC LAND SURVEY MONUMENT RECORD IS CORRECT
 AND COMPLETE TO THE BEST OF MY KNOWLEDGE AND BELIEF.

William C. Jung 2/10/86
 Signature Date

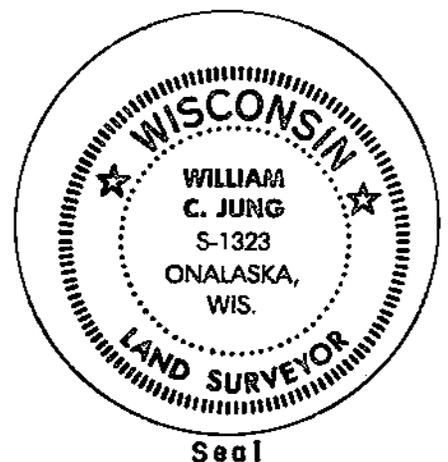

Seal