


U. S. PUBLIC LAND SURVEY MONUMENT RECORD

SECTION 24 T 17 N, R 6 W, TOWN OF HAMILTON
 LA CROSSE COUNTY

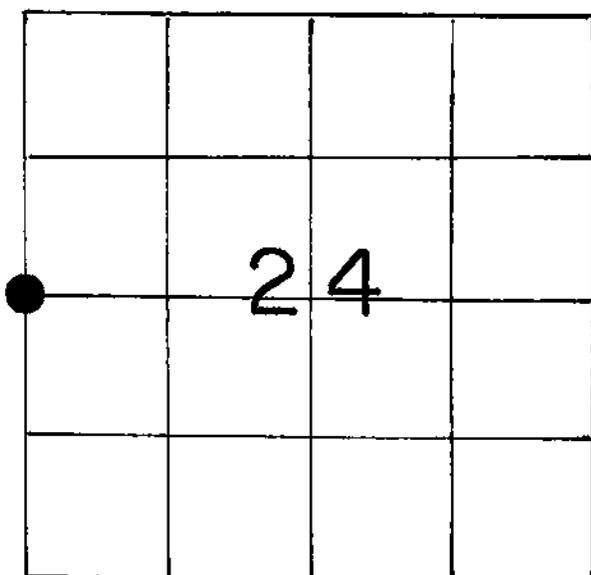

LOCATION OF LANDMARK

WISCONSIN COORDINATE SYSTEM
North
East
Theta Angle
Horiz. Order
Vert. Order
TYPE OF LANDMARK
Brass capped Lunde marker
BEARINGS ARE REFERENCED TO
True

Crew: William C. Jung

Peter F. Follansbee

Date: 12/9/92

Describe any record evidence, monument evidence, testimonial evidence or any other material evidence you considered and whether the monument was found or restored through acceptance of an obliterated evidence location.


I set the corner by single proportionate measurement and monumented it with a brass capped Lunde marker, down 6". The Lunde is a "breakaway". A wine bottle with a shell casing is buried on the Southwest side of the marker.

Describe or show any material discrepancy between the location of the restored corner and that of the corner previously restored or reestablished.

None known.

RECORD OF DURABLE WITNESS MONUMENTS

NO	DESCRIPTION	BEARING	DISTANCE
1	P.K. nail in utility pole	-----	55.12
2	To the center of a telephone pedestal at the end of an electric lane fence.	-----	56.82
3	To the foundation at the NW corner of house	-----	136.59
4	P.K. nail in utility pole	-----	46.35

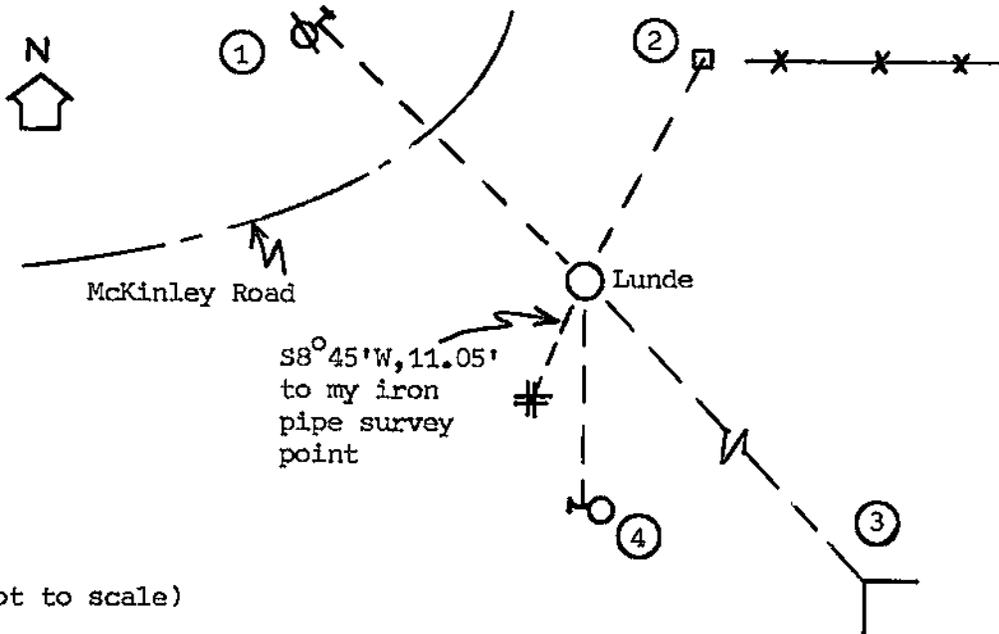


(not to scale)

PLAN VIEW DRAWING OF REFERENCE TIES


MAP SHOWING DISTANCE AND DIRECTION TO OTHER PUBLIC LAND SURVEY CORNERS USED FOR REESTABLISHING THE CORNER

(not to scale)

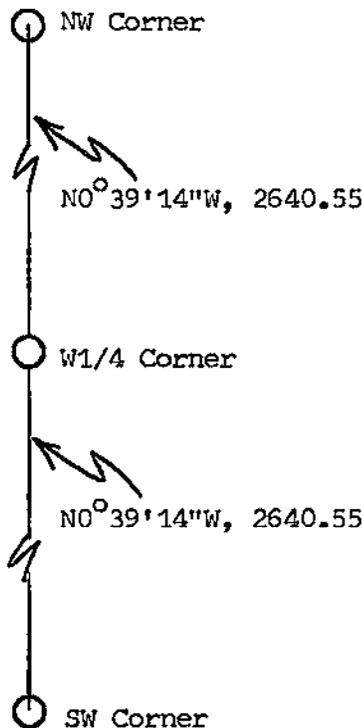

I, William C. Jung, Deputy County Surveyor,
 HEREBY CERTIFY THAT THE CORNER LOCATION SHOWN ON THIS RECORD
 WAS DETERMINED BY ME OR UNDER MY DIRECTION AND CONTROL AND
 THAT THIS U. S. PUBLIC LAND SURVEY MONUMENT RECORD IS CORRECT
 AND COMPLETE TO THE BEST OF MY KNOWLEDGE AND BELIEF.

William C. Jung December 15, 1992
 Signature Date

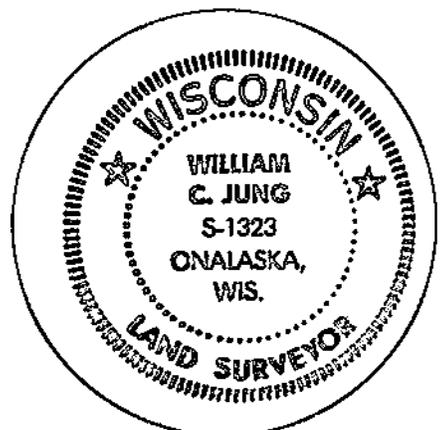

Seal