


U. S. PUBLIC LAND SURVEY MONUMENT RECORD

SECTION 24 T 17 N, R 6 W, TOWN OF HAMILTON

LA CROSSE COUNTY

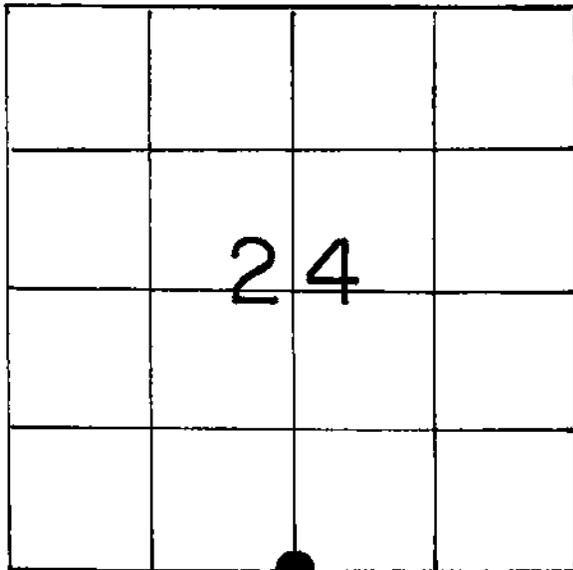

LOCATION OF LANDMARK

Crew: William C. Jung
Peter F. Follansbee

Date: December 18, 1992

Describe any record evidence, monument evidence, testimonial evidence or any other material evidence you considered and whether the monument was found or restored through acceptance of an obliterated evidence location.

I accepted a fence corner as the best available evidence of the original government corner position and monumented it with an iron pipe on the Southeast side of the corner post. South of the post I set ^a post(steel) with a sign.

Describe or show any material discrepancy between the location of the restored corner and that of the corner previously restored or reestablished.

None known.

WISCONSIN COORDINATE SYSTEM

North

East

Theta Angle

Horiz. Order

Vert. Order

TYPE OF LANDMARK


1" iron pipe at a fence corner

BEARINGS ARE REFERENCED TO

True


RECORD OF DURABLE WITNESS MONUMENTS

NO	DESCRIPTION	BEARING	DISTANCE
1	P.K. in double blazed 6" box elder 9' S. of fence	-----	30.84
2	" 6" elm 8.2' S. of fence	-----	21.64
3	" 7½" box elder 13.5' S. of fence	-----	18.17
4	" 4" basswood 21.4' S. of fence	-----	24.77

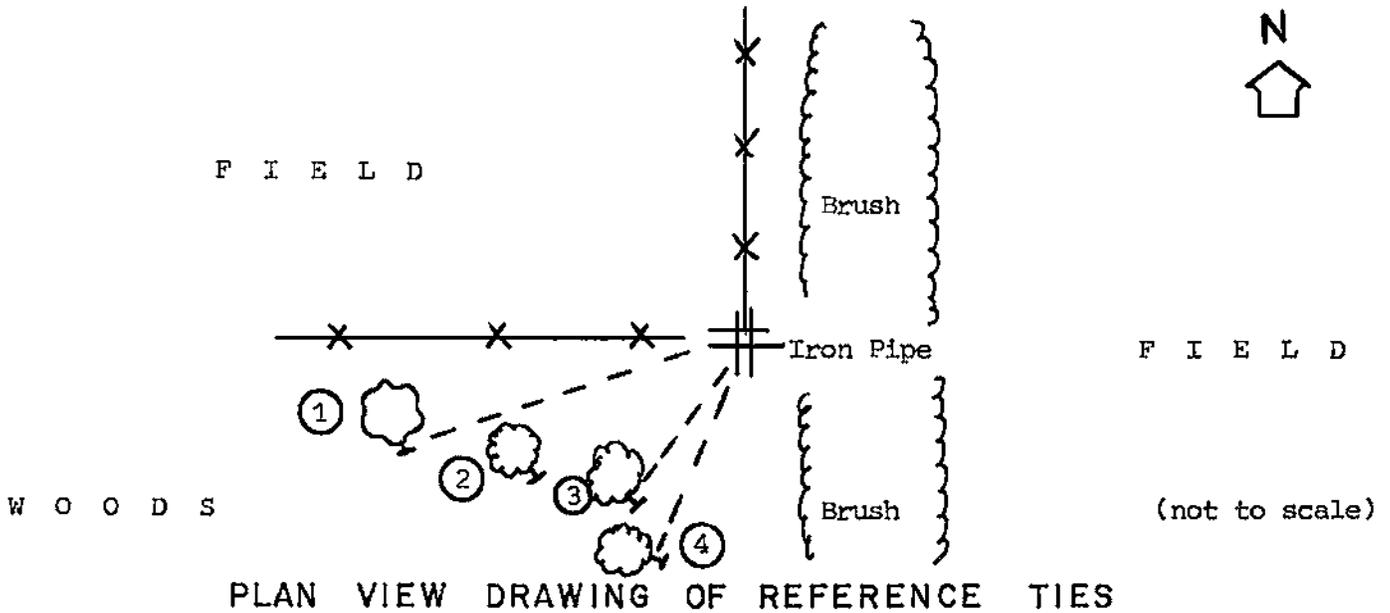

MAP SHOWING DISTANCE AND DIRECTION TO OTHER PUBLIC LAND SURVEY CORNERS USED FOR REESTABLISHING THE CORNER


(not to scale)

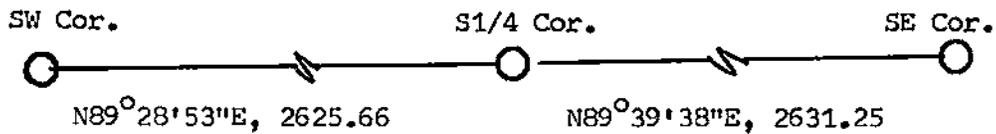

I, William C. Jung, Deputy County Surveyor,
 HEREBY CERTIFY THAT THE CORNER LOCATION SHOWN ON THIS RECORD
 WAS DETERMINED BY ME OR UNDER MY DIRECTION AND CONTROL AND
 THAT THIS U. S. PUBLIC LAND SURVEY MONUMENT RECORD IS CORRECT
 AND COMPLETE TO THE BEST OF MY KNOWLEDGE AND BELIEF.

William C. Jung
 Signature

December 21, 1992
 Date

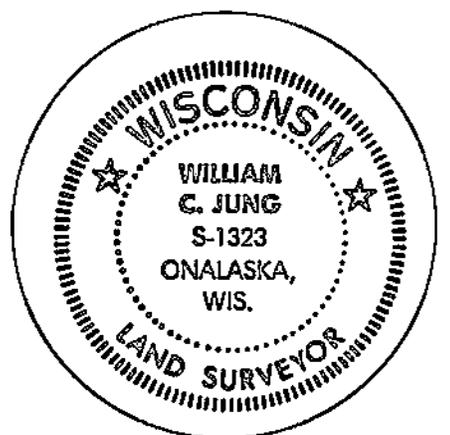

Seal