


U. S. PUBLIC LAND SURVEY MONUMENT RECORD

SECTION 36 T 17 N, R 6 W, TOWN OF HAMILTON

LA CROSSE COUNTY

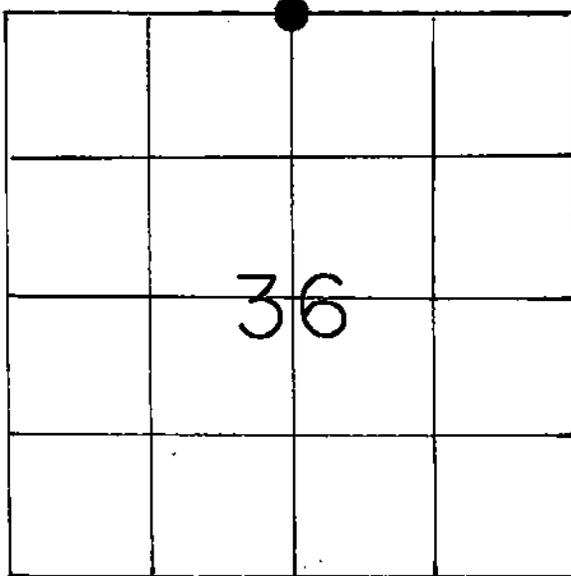

LOCATION OF LANDMARK

Crew: William Jung
Perry Dahl
11/8/84

Crew: William C. Jung
Peter Follansbee
4/5/06 *****

WISCONSIN COORDINATE SYSTEM

North

East

Theta Angle

Horiz. Order

Vert. Order

TYPE OF LANDMARK

BERNTSEN

BEARINGS ARE REFERENCED TO

True

Describe any record evidence, monument evidence, testimonial evidence or any other material evidence you considered and whether the monument was found or restored through acceptance of an obliterated evidence location.

I found a 3/4" iron bar at the occupied fence corner. Apparently it had been set by Joe Murphy. Pederson used it as the corner at a later date. I removed the iron bar and replaced it with a Berntsen marker. I accepted this position at the occupied corner as the best available evidence of the original government corner.


***** 4/5/06 We found the marker in good condition and checked the ties.

Describe or show any material discrepancy between the location of the restored corner and that of the corner previously restored or reestablished.

None known.


RECORD OF DURABLE WITNESS MONUMENTS

NO	DESCRIPTION	BEARING	DISTANCE
1	^{Fd.} SET 1 1/4" IRON PIPE	—————	14.92'
2	^{Fd.} SET 1 1/4" IRON PIPE	SOUTH ±	14.82'
3	SET 1 1/4" IRON PIPE	—————	14.78'
4	Set a 3/4"x30" iron bar with a red plastic cap with a "machine knife" to the NE	—————	11.90'

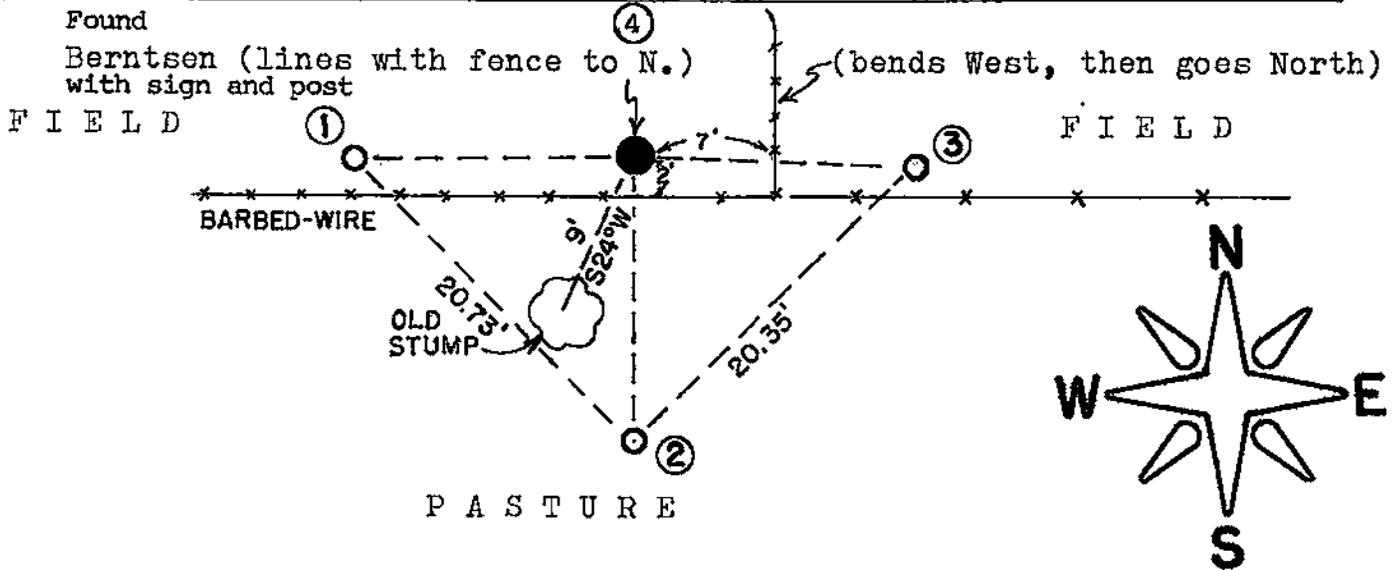

PLAN VIEW DRAWING OF REFERENCE TIES

MAP SHOWING DISTANCE AND DIRECTION TO OTHER PUBLIC LAND SURVEY CORNERS USED FOR REESTABLISHING THE CORNER
(not to scale)

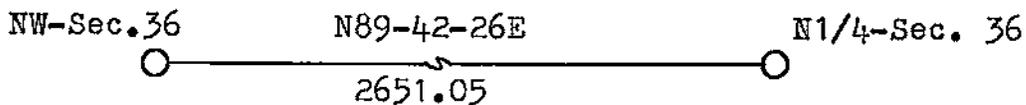


I, William C. Jung, Deputy County Surveyor,
HEREBY CERTIFY THAT THE CORNER LOCATION SHOWN ON THIS RECORD
WAS DETERMINED BY ME OR UNDER MY DIRECTION AND CONTROL AND
THAT THIS U. S. PUBLIC LAND SURVEY MONUMENT RECORD IS CORRECT
AND COMPLETE TO THE BEST OF MY KNOWLEDGE AND BELIEF.

William C. Jung
Signature

2/10/86

Date

Revised: 5/9/06 *relj*

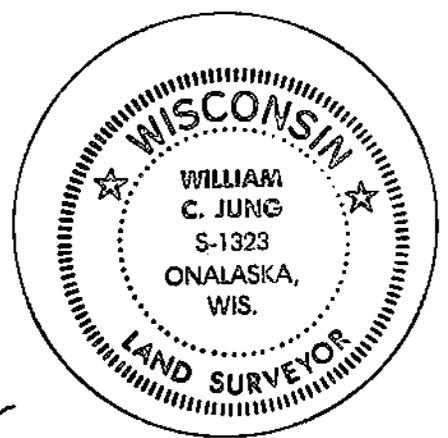

Seal