


21706260000

U. S. PUBLIC LAND SURVEY MONUMENT RECORD

SECTION 26 T 17 N, R 6 W, TOWN OF HAMILTON

LA CROSSE COUNTY

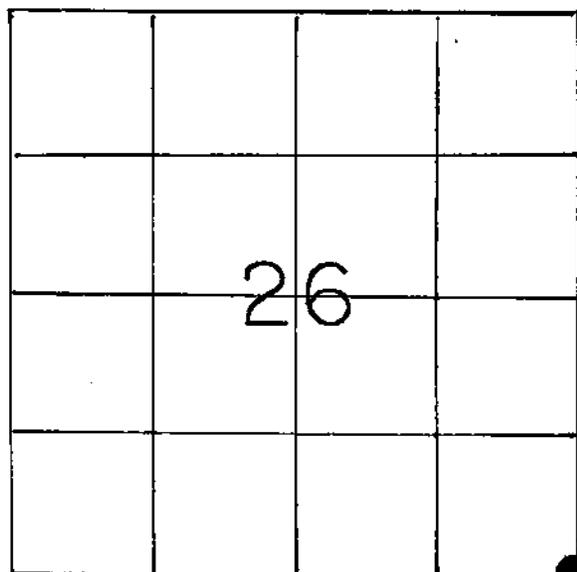

LOCATION OF LANDMARK

Crew: William Jung
Perry Dahl

9/18/84

WISCONSIN COORDINATE SYSTEM

North

East

Theta Angle

Horiz. Order

Vert. Order

TYPE OF LANDMARK

BERNTSEN

BEARINGS ARE REFERENCED TO

True

Describe any record evidence, monument evidence, testimonial evidence or any other material evidence you considered and whether the monument was found or restored through acceptance of an obliterated evidence location.

I found an iron pipe at the corner that had been used in previous surveys by Murphy and Hofmeister. I removed the pipe and replaced it with a Berntsen marker. I accepted this position as the best available evidence of the original government corner.

*(Lampman has since used this corner for a survey in Section 26)


Describe or show any material discrepancy between the location of the restored corner and that of the corner previously restored or reestablished.

None known.

RECORD OF DURABLE WITNESS MONUMENTS


NO	DESCRIPTION	BEARING	DISTANCE
1	NAIL IN UNBLAZED OAK (24")	—————	10.55'
2	EXISTING 1 3/4" IRON PIPE *(Mag.=S2.5°E)	S00°56'30"W	40.16'
3	EXISTING 1 3/4" IRON PIPE	N89°00'15"W	16.65'
4	SET 1 1/4" IRON PIPE	N00°52'30"E	23.7'

(True)

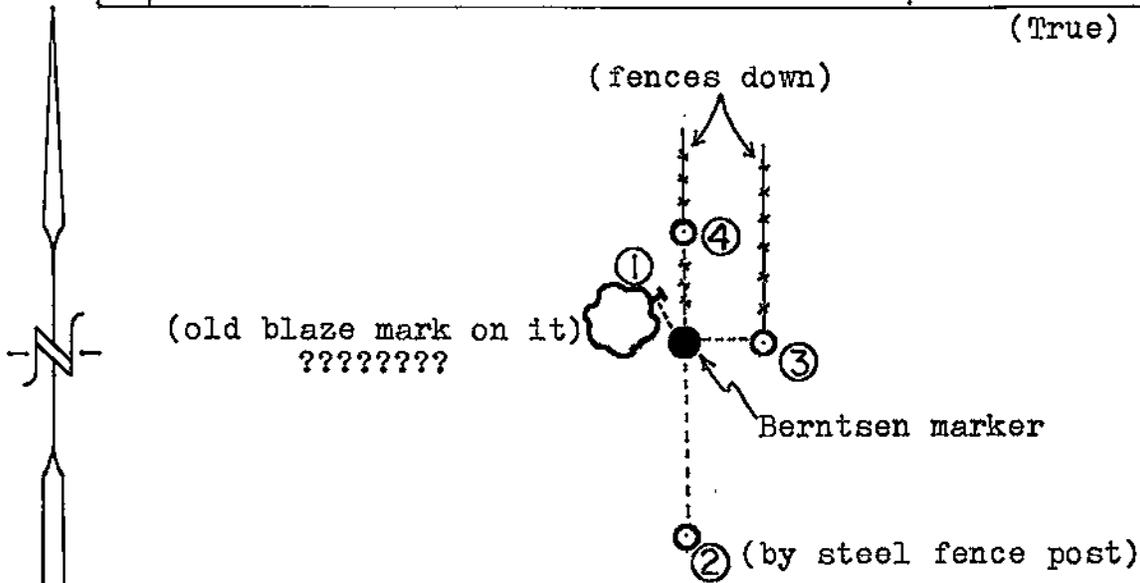

PLAN VIEW DRAWING OF REFERENCE TIES

MAP SHOWING DISTANCE AND DIRECTION TO OTHER PUBLIC LAND SURVEY CORNERS USED FOR REESTABLISHING THE CORNER

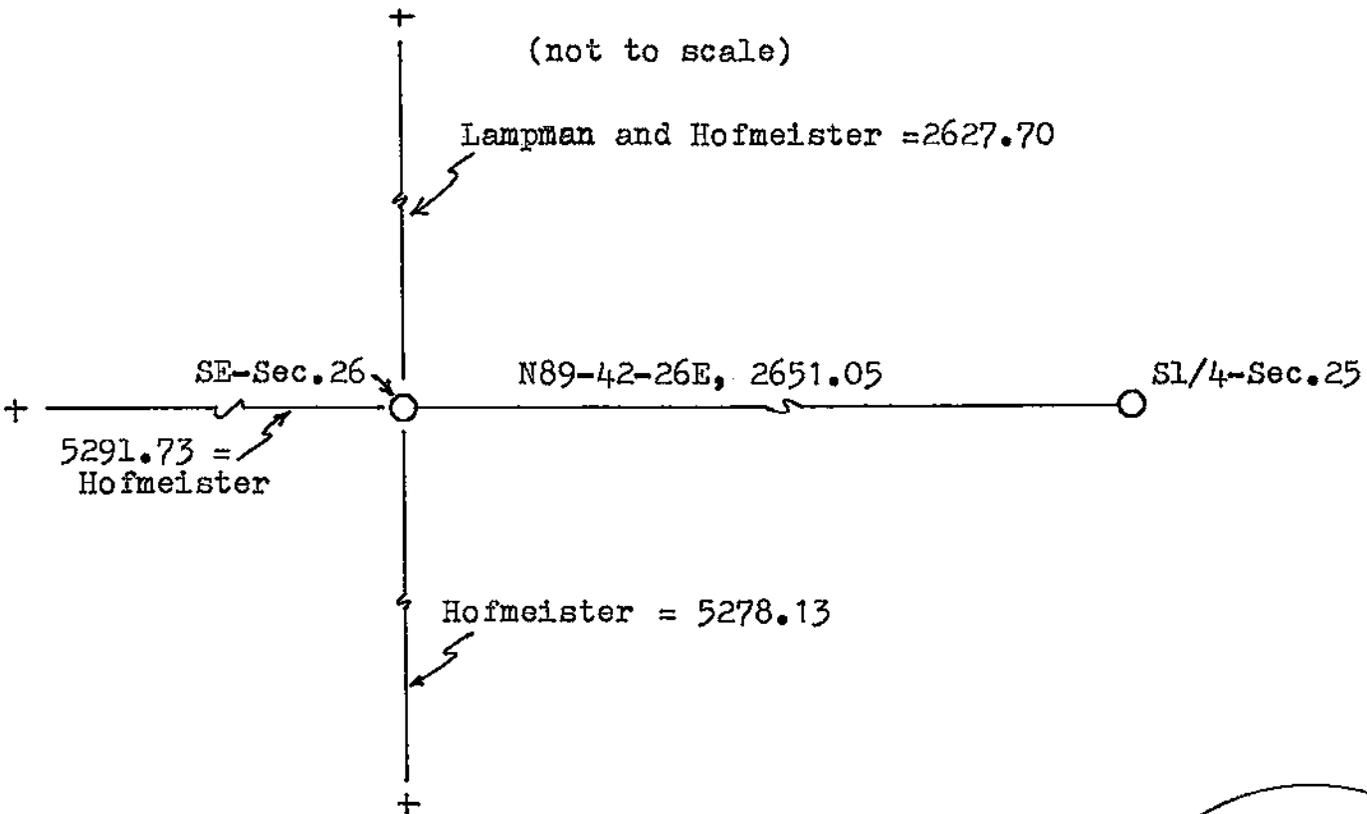

I, William C. Jung, Deputy County Surveyor,
 HEREBY CERTIFY THAT THE CORNER LOCATION SHOWN ON THIS RECORD
 WAS DETERMINED BY ME OR UNDER MY DIRECTION AND CONTROL AND
 THAT THIS U. S. PUBLIC LAND SURVEY MONUMENT RECORD IS CORRECT
 AND COMPLETE TO THE BEST OF MY KNOWLEDGE AND BELIEF.

William C. Jung
 Signature

2/10/86
 Date

