


21706270000

U. S. PUBLIC LAND SURVEY MONUMENT RECORD

SECTION 26 T 17 N, R 6 W, TOWN OF HAMILTON  
 LA CROSSE COUNTY

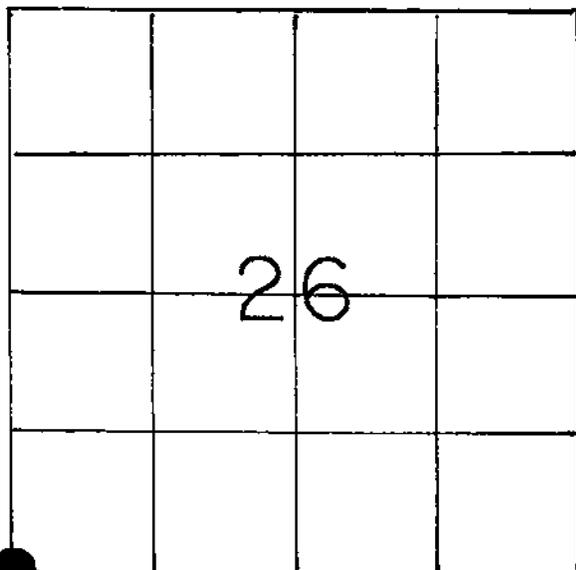

LOCATION OF LANDMARK

Crew: William Jung  
 Perry Dahl  
 9/18/84

WISCONSIN COORDINATE SYSTEM
North
East
Theta Angle
Horiz. Order
Vert. Order
TYPE OF LANDMARK
BERNTSEN
BEARINGS ARE REFERENCED TO

Describe any record evidence, monument evidence, testimonial evidence or any other material evidence you considered and whether the monument was found or restored through acceptance of an obliterated evidence location.


I found a Berntsen marker at the section corner. This corner position has been used in several previous surveys, including surveys by Hofmeister, Pelishek, and probably Hovelerud, Solberg, and Lampman. I accepted this position as the corner of record. It also checks with the highway map.

Describe or show any material discrepancy between the location of the restored corner and that of the corner previously restored or reestablished.

None known.

RECORD OF DURABLE WITNESS MONUMENTS

NO	DESCRIPTION	BEARING	DISTANCE
1	1" IRON PIPE BY STEEL R/W POST, EXIS.	NORTH ±	56.4'
2	VENT PIPE, EXISTING (to center of)	S50°W = Mag.	23.18'
3	1 1/4" IRON PIPE, SET	EAST ±	20.35'
4	NAIL IN 13 IN. OAK TREE, SINGLE-BLAZED	N10°E = Mag.	10.24'

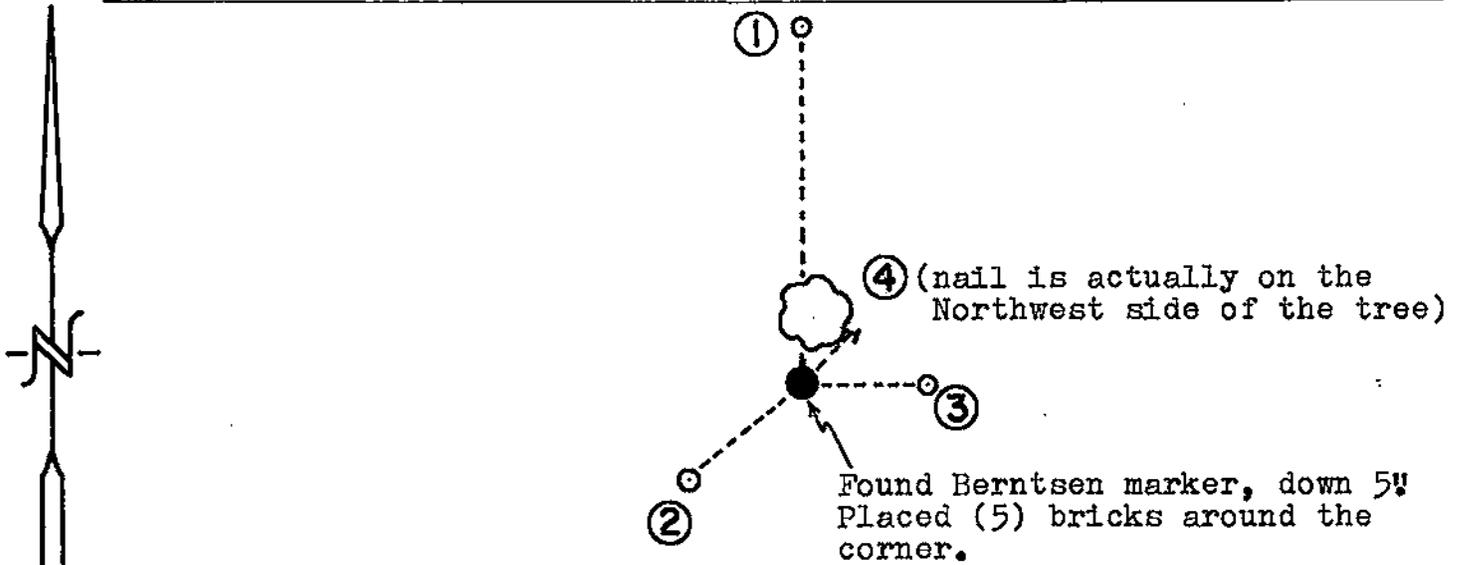

PLAN VIEW DRAWING OF REFERENCE TIES


MAP SHOWING DISTANCE AND DIRECTION TO OTHER PUBLIC LAND SURVEY CORNERS USED FOR REESTABLISHING THE CORNER

None made by me at this time. See maps of record.

I, William C. Jung, Deputy County Surveyor,  
 HEREBY CERTIFY THAT THE CORNER LOCATION SHOWN ON THIS RECORD  
 WAS DETERMINED BY ME OR UNDER MY DIRECTION AND CONTROL AND  
 THAT THIS U. S. PUBLIC LAND SURVEY MONUMENT RECORD IS CORRECT  
 AND COMPLETE TO THE BEST OF MY KNOWLEDGE AND BELIEF.

William C. Jung  
 Signature

2/10/86  
 Date

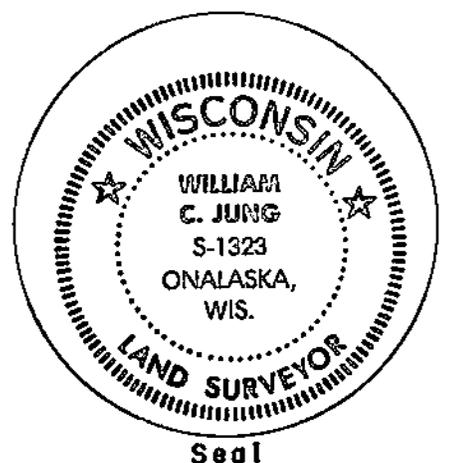

Seal