


21706270020

## U. S. PUBLIC LAND SURVEY MONUMENT RECORD

SECTION 34 T 17 N, R 6 W, TOWN OF HAMILTON

LA CROSSE COUNTY

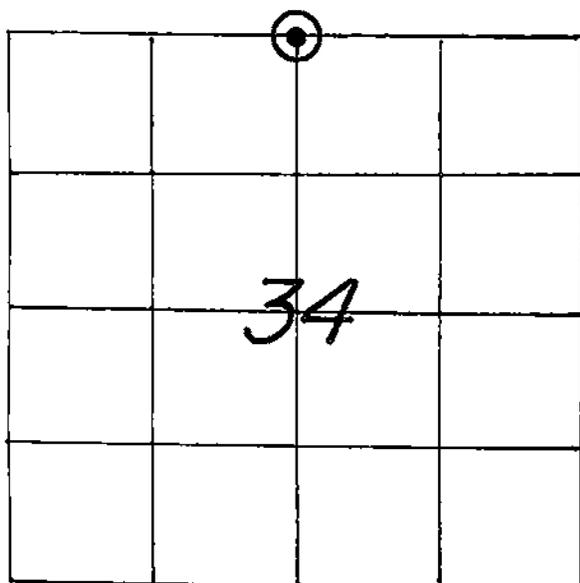

WISCONSIN COORDINATE SYSTEM

North

East

Theta Angle

Horiz. Order

Vert. Order

TYPE OF LANDMARK

*1-3/4" x 49" IRON PIPE OVER AN AXLE.*

BEARINGS ARE REFERENCED TO

*ASSUMED NORTH AS PER SECTION DATA.*

LOCATION OF LANDMARK

CREW: *WILLIAM G. JUNG*  
*PETER F. FOLLANSBEE*  
 DATE: *5/01/2007*

Describe any record evidence, monument evidence, testimonial evidence or any other material evidence you considered and whether the monument was found or restored through acceptance of an obliterated evidence location.


I found the monument of record and set an iron pipe over it. A sign and post were set to the East. Maxwell, Harding, and Berg all agree on this corner. I am not sure if this corner is at Hovelrud's 1974 location. I have no record of him monumenting the corner.

Describe or show any material discrepancy between the location of the restored corner and that of the corner previously restored or reestablished.

*NONE KNOWN.*


RECORD OF DURABLE WITNESS MONUMENTS

NO	DESCRIPTION	MAGNETIC	
		BEARING	DISTANCE
1	EX. SPIKE IN S.W.-SIDE OF A 13" ELM	N 70° W	22.23 FT.
2	EX. SPIKE IN N.W.-SIDE OF A 17" ELM	N 30° E	34.44 FT.
3	SET A NAIL IN N.W.-SIDE OF A 15" ASH	N 65° E	33.67 FT.
4	SET A NAIL IN S.W.-SIDE OF A 7 1/2" ASH	S 65° E	27.36 FT.

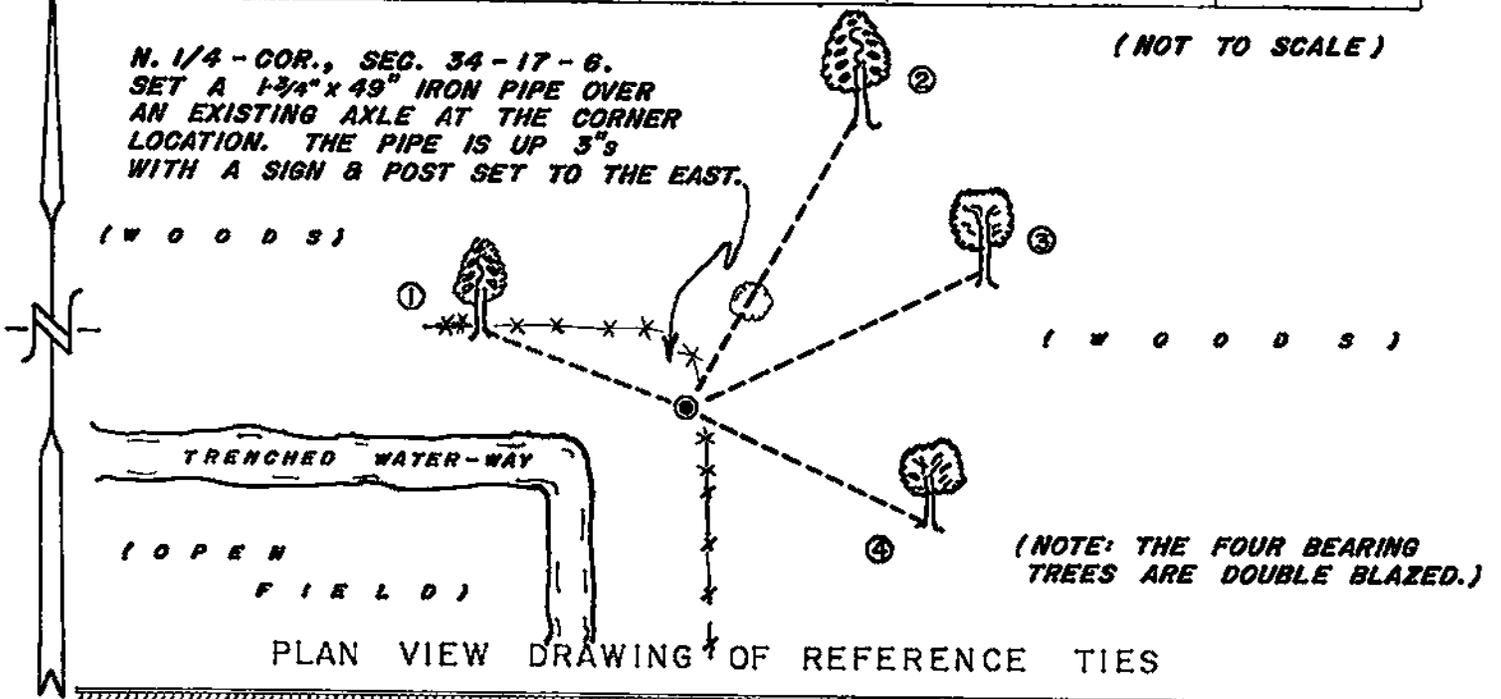

MAP SHOWING DISTANCE AND DIRECTION TO OTHER PUBLIC LAND SURVEY CORNERS USED FOR REESTABLISHING THE CORNER


(ASSUMED BEARINGS)  
 (NOT TO SCALE)

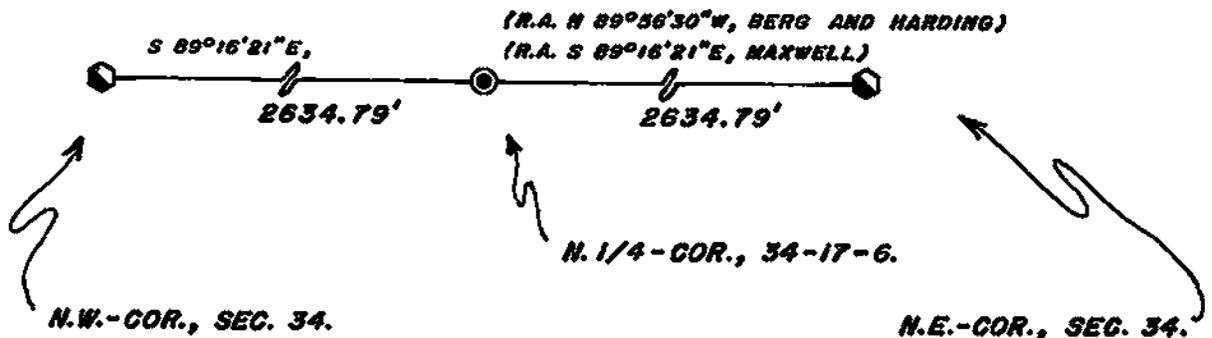

I, WILLIAM C. JUNG, COUNTY SURVEYOR  
 HEREBY CERTIFY THAT THE CORNER LOCATION SHOWN ON THIS RECORD WAS DETERMINED BY ME OR UNDER MY DIRECTION AND CONTROL AND THAT THIS U. S. PUBLIC LAND SURVEY MONUMENT RECORD IS CORRECT AND COMPLETE TO THE BEST OF MY KNOWLEDGE AND BELIEF.

William C. Jung  
 Signature

5/17/07  
 Date

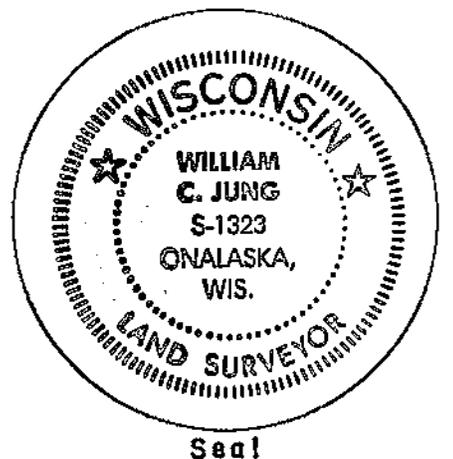

Seal


---

 U. S. PUBLIC LAND SURVEY MOUMENT RECORD
 

---

 SECTION 34, T.17N., R.6W., TOWN OF HAMILTON  
 LACROSSE COUNTY, WISCONSIN
 

---

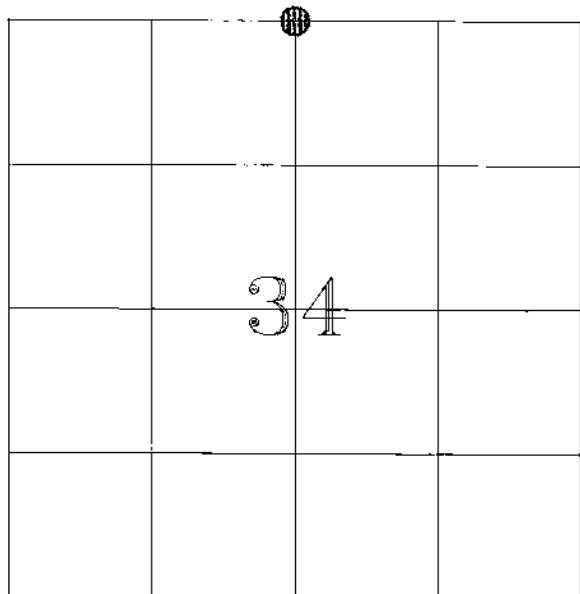

WISCONSIN COORDINATE SYSTEM
North
East
Theta Angle
Horiz. Order
Vert. Order
TYPE OF LANDMARK:
Set 1" x 32" Axle
BEARINGS ARE REFERENCED TO:
Assumed Datum

## LOCATION OF LANDMARK

 Crew: Rodney H. Maxwell  
 Laurence E. Johns III

Date: 7 January 2002

---

 Describe any record evidence, monument evidence, testimonial evidence or any other material evidence you considered and whether the monument was found or restored through acceptance of an obliterated evidence location.

This location was shown as a computed location on Certified Survey Map, Volume 9, Page 146 by Michael Harding. He told me the location was based on single proportion measurement between the N.E. & N.W. Corners of Section 34. I traversed to the location and searched for any evidence of an existing corner. The only evidence I could find was old fencing which seemed to agree with this location.

---


 Describe or show any material discrepancy between the location of the restored corner and that of the corner previously restored or reestablished.

None known.

# RECORD OF DURABLE WITNESS MONUMENTS


NO.	DESCRIPTION	BEARING	DISTANCE
1	14" Elm	N 77°28'42" W	22.11'
2	15" Elm	N 25°31'03" E	34.39'
3	16" Elm	N 61°29'11" E	55.73'
4	18" White Oak	S 09°22'11" W	18.12'

\*\* All trees have a 8" Spike in side.

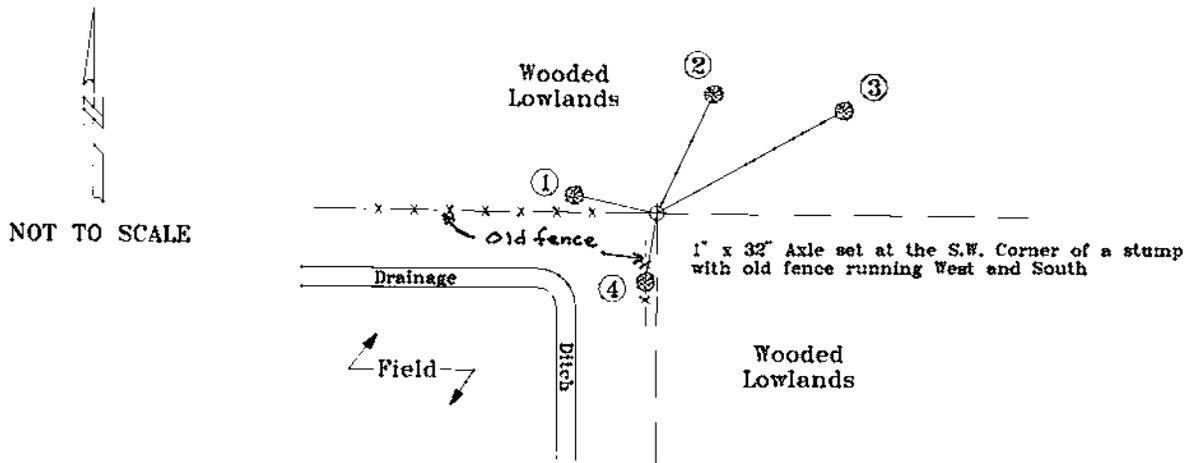


## PLAN VIEW DRAWING OF REFERENCE TIES

Map Showing Distance And Direction To Other Public Land Survey  
Corners Used For Re-Establishing The Corner

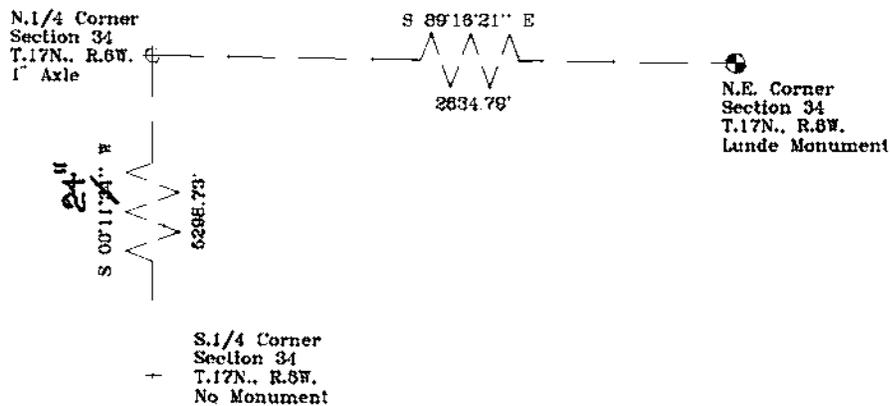

I, Rodney H. Maxwell, Registered Land Surveyor, hereby certify that the corner location shown on this record was determined by me or under my direction and control, and that this U. S. Public Land Survey Monument Record is correct and complete to the best of my knowledge and belief.

*Rodney H. Maxwell*  
Rodney H. Maxwell  
Maxwell Surveying  
7457 Highway 16, Suite C  
Sparta, Wisconsin  
7 January 2002

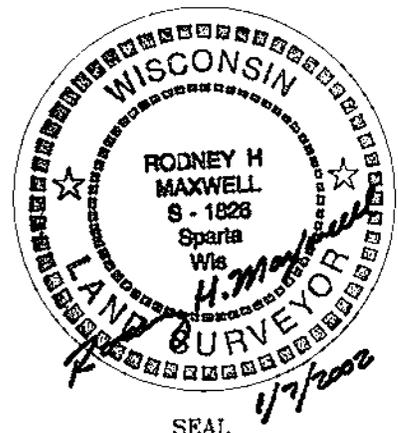

SEAL