


U. S. PUBLIC LAND SURVEY MONUMENT RECORD

SECTION 27 T 17 N, R 6 W, TOWN OF Hamilton

LA CROSSE COUNTY

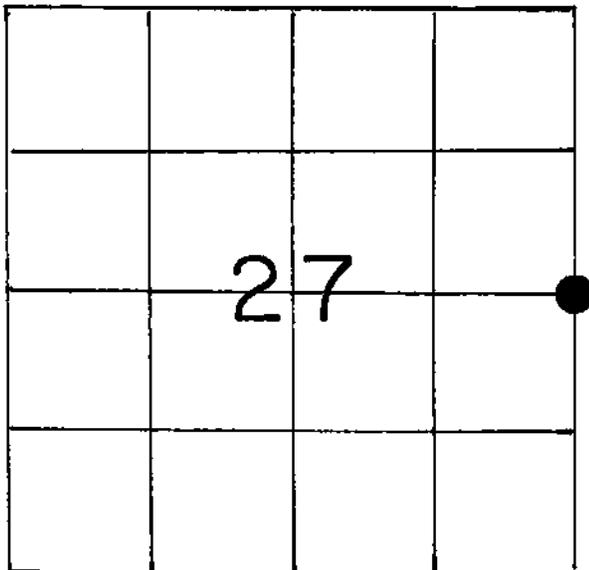

LOCATION OF LANDMARK

Crew: William C. Jung
Peter F. Follansbee

Date: November 5, 1990

Describe any record evidence, monument evidence, testimonial evidence or any other material evidence you considered and whether the monument was found or restored through acceptance of an obliterated evidence location.

I found a 1/2"x9' iron pipe at the corner, about 33' South and 330' East of the Southeast corner of the cemetery. This 1/2" pipe had been used as the corner in previous surveys. I replaced the pipe with a Lunde marker. I also found a bolt while digging out the pipe. The Lunde marker is down 1" or so. A whiskey bottle with an empty shell casing is buried on the Northeast side of the marker.

Describe or show any material discrepancy between the location of the restored corner and that of the corner previously restored or reestablished.

None known.

WISCONSIN COORDINATE SYSTEM

North

East

Theta Angle

Horiz. Order

Vert. Order


TYPE OF LANDMARK

Brass capped Lunde marker

BEARINGS ARE REFERENCED TO

RECORD OF DURABLE WITNESS MONUMENTS

NO	DESCRIPTION	BEARING	DISTANCE
1	P.K. nail on SE side of 10" Norway pine	-----	2.12
2	SE corner of house foundation	-----	71.53
3	P.K. nail on East side of 6" maple	-----	35.82
4	P.K. nail on West side of power pole w/light	-----	93.26

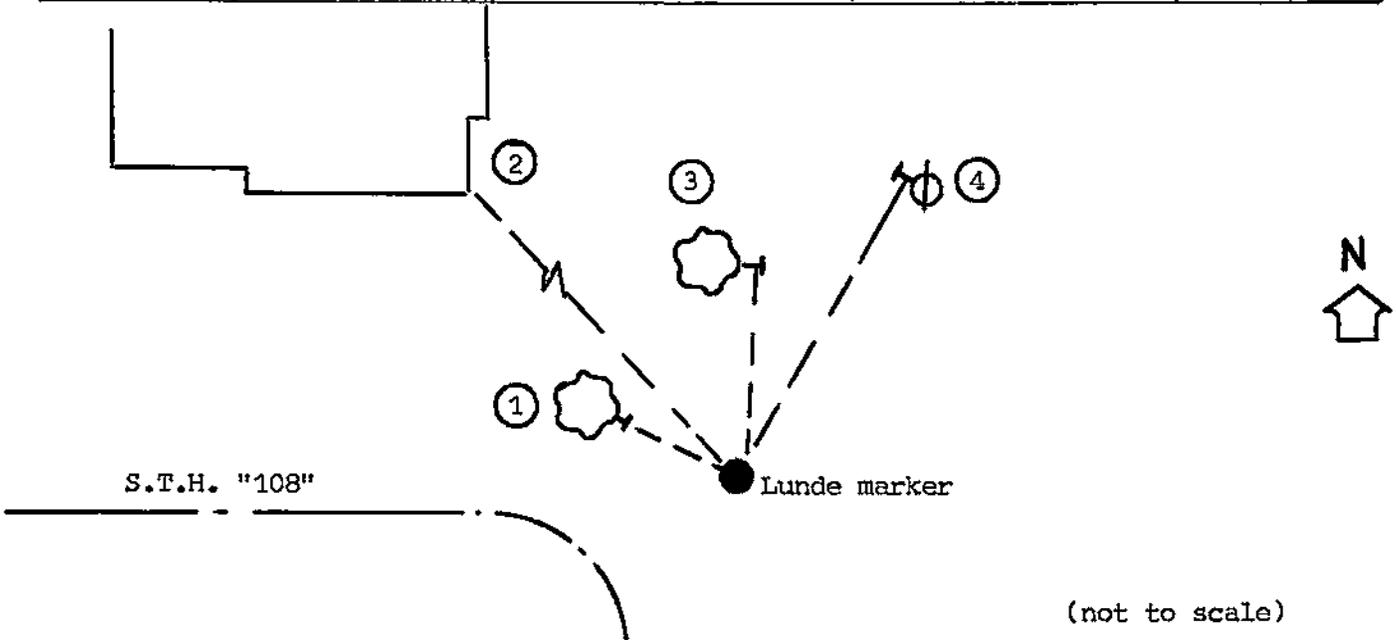

PLAN VIEW DRAWING OF REFERENCE TIES


MAP SHOWING DISTANCE AND DIRECTION TO OTHER PUBLIC LAND SURVEY CORNERS USED FOR REESTABLISHING THE CORNER

Note: No section measurements made by me at this time.

I, William C. Jung, Deputy County Surveyor,
 HEREBY CERTIFY THAT THE CORNER LOCATION SHOWN ON THIS RECORD
 WAS DETERMINED BY ME OR UNDER MY DIRECTION AND CONTROL AND
 THAT THIS U. S. PUBLIC LAND SURVEY MONUMENT RECORD IS CORRECT
 AND COMPLETE TO THE BEST OF MY KNOWLEDGE AND BELIEF.

William C. Jung
 Signature

January 11, 1991
 Date

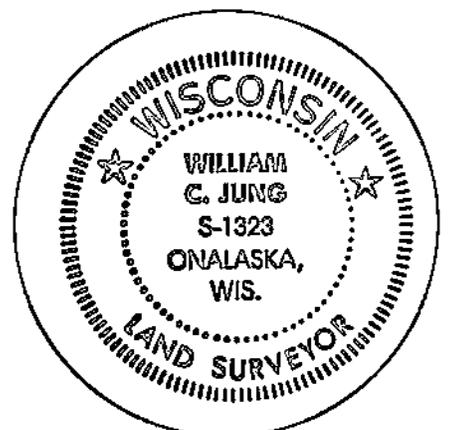

Seal