


U. S. PUBLIC LAND SURVEY MONUMENT RECORD

SECTION 28 T 17 N, R 6 W, TOWN OF Hamilton

LA CROSSE COUNTY

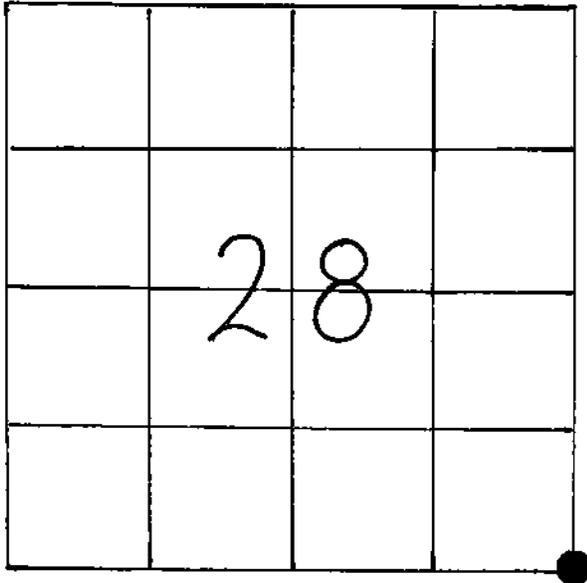

LOCATION OF LANDMARK

WISCONSIN COORDINATE SYSTEM

North

East

Theta Angle

Horiz. Order

Vert. Order

TYPE OF LANDMARK

Berntsen top in existing 2" iron pipe

BEARINGS ARE REFERENCED TO

Crew: William C. Jung
Peter F. Follansbee

Date: March 26, 1992

Describe any record evidence, monument evidence, testimonial evidence or any other material evidence you considered and whether the monument was found or restored through acceptance of an obliterated evidence location.

I found an iron pipe at the corner. The pipe had been used in previous survey work. I accepted it as the best available evidence of the original government corner position. A Berntsen top was put in the pipe. The monument is up 7". A sign and post were put in to the North of the monument. The corner is down in the river bottoms.


Describe or show any material discrepancy between the location of the restored corner and that of the corner previously restored or reestablished.

None known.

RECORD OF DURABLE WITNESS MONUMENTS

Magnetic

NO	DESCRIPTION	BEARING	DISTANCE
1	P.K. nail in double blazed 9" maple (?)	N25°W	41.18
2	" " 6" " "	N40°E	14.64
3	" " 12" " "	S76°E	69.43
4	P.K. nail in unblazed 42" maple (?)	S79°W	18.46

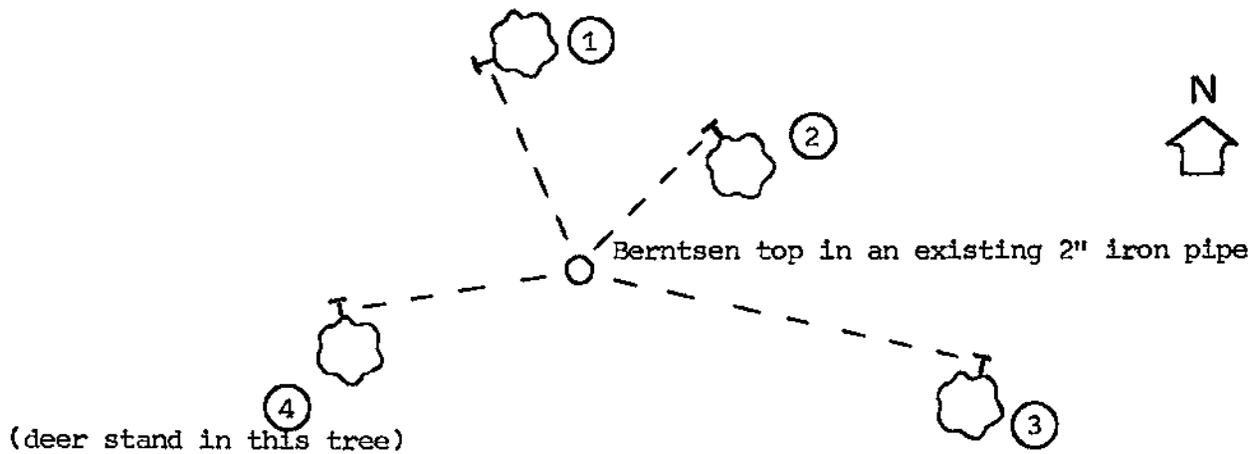

(not to scale)

PLAN VIEW DRAWING OF REFERENCE TIES

MAP SHOWING DISTANCE AND DIRECTION TO OTHER PUBLIC LAND SURVEY CORNERS USED FOR REESTABLISHING THE CORNER

No section measurements made by me at this time.

I, William C. Jung, Deputy County Surveyor,
 HEREBY CERTIFY THAT THE CORNER LOCATION SHOWN ON THIS RECORD
 WAS DETERMINED BY ME OR UNDER MY DIRECTION AND CONTROL AND
 THAT THIS U. S. PUBLIC LAND SURVEY MONUMENT RECORD IS CORRECT
 AND COMPLETE TO THE BEST OF MY KNOWLEDGE AND BELIEF.

William C. Jung June 8, 1992
 Signature Date



Seal