


U. S. PUBLIC LAND SURVEY MONUMENT RECORD

SECTION 33 T 17 N, R 6 W, TOWN OF HAMILTON
 LA CROSSE COUNTY

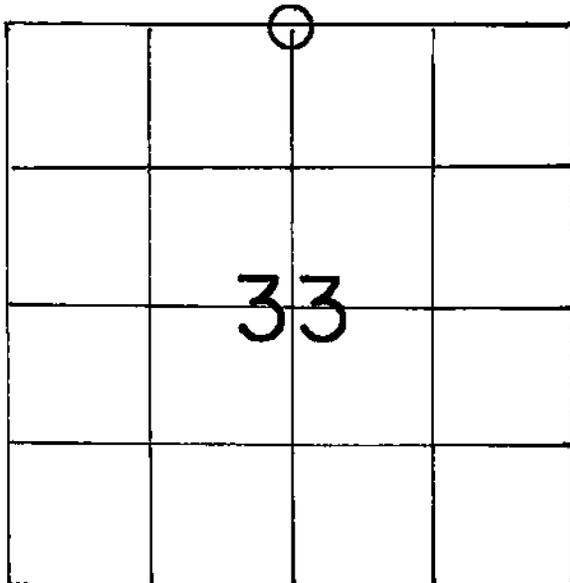

WISCONSIN COORDINATE SYSTEM

North

East

Theta Angle

Horiz. Order

Vert. Order

TYPE OF LANDMARK P.K. nail w/cap
~~1" x 30" Iron Pipe~~

BEARINGS ARE REFERENCED TO

LOCATION OF LANDMARK

Crew: WILLIAM C. JUNG
 PETER F. FOLLANSBEE

Crew: William C. Jung
 Peter F. Follansbee

Date: 12/01/1994

Date: 8/27/01

Describe any record evidence, monument evidence, testimonial evidence or any other material evidence you considered and whether the monument was found or restored through acceptance of an obliterated evidence location.

I set the pipe over an existing round steel rod. I had set this rod in August of 1983.

8/27/01 - The iron pipe had been knocked out. We set a P.K. nail with a cap at the corner.

Describe or show any material discrepancy between the location of the restored corner and that of the corner previously restored or reestablished.

None Known.

LaCrosse County U.S. Public Land Survey Monument Record

RECORD OF LAND CORNER PERPETUATION

No. _____

STATE OF WISCONSIN

County of Monroe

I, William C. Jung hereby certify that the information shown hereon correctly describes the original corner, resurvey information, evidence found, type of monument found or placed, and witness monuments and accessories used to perpetuate the location of the original or established corner.

Dated this 12th day of August, 19 83

at Tomah, Wisconsin.

William C. Jung
Registered Land Surveyor 1323


| | | |
|---|-------------------------|---------------------|
| COUNTY LaCrosse | | |
| TOWN Hamilton | | |
| HIGHWAY Intersection of "M"&Gills Coulee Rd | | |
| SECTION 33 | TOWNSHIP T17N | RANGE R6W |
| TYPE OF LANDMARK 1/4"x12" round steel rod | | |

Date of Survey August 5, 1983


Drafted by Jung

Date August 12, 1983

North 1/4 Corner-Section 33-T17N-R6W

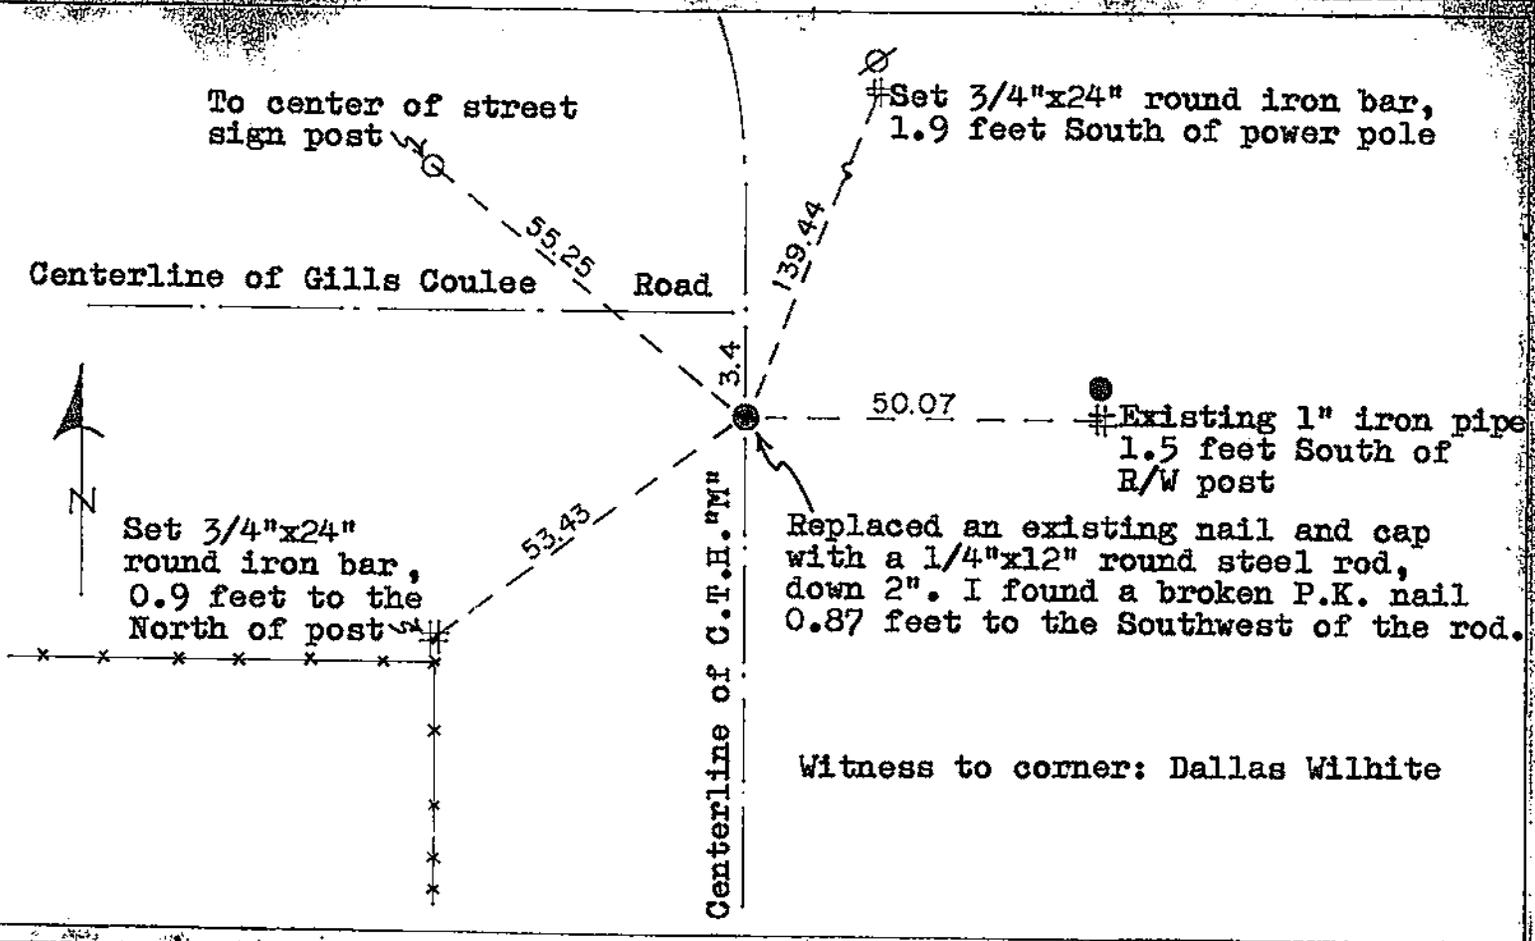

| WISCONSIN COORDINATE SYSTEM | |
|-----------------------------|-------------|
| North | Zone |
| East | |
| Elevation | Theta Angle |
| Vertical control order | |
| Horizontal control order | |

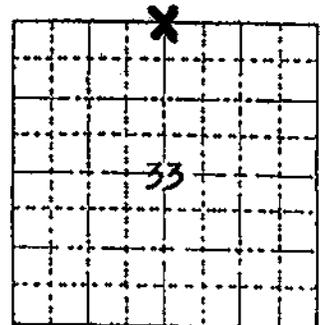

REMARKS: I found a nail and cap at the corner. This point had been used as the corner in previous surveys. I replaced the nail and cap with a 1/4"x12" round steel rod.

LOCATION SKETCH
(Location of landmark indicated by "x")

VOID