


21706290020

U. S. PUBLIC LAND SURVEY MONUMENT RECORD

SECTION 32 T 17 N, R 6 W, TOWN OF HAMILTON

LA CROSSE COUNTY

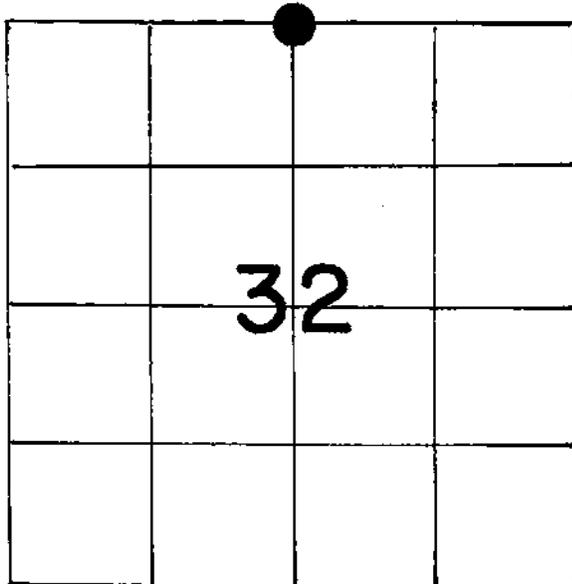

LOCATION OF LANDMARK

WISCONSIN COORDINATE SYSTEM

North

East

Theta Angle

Horiz. Order

Vert. Order

TYPE OF LANDMARK

BERNTSEN

BEARINGS ARE REFERENCED TO

(none shown)

Crew: William Jung
Perry Dahl
5/28/85

Describe any record evidence, monument evidence, testimonial evidence or any other material evidence you considered and whether the monument was found or restored through acceptance of an obliterated evidence location.

Ken Carlson set an iron bar at this corner in 1979. That same year when working for Harley Sime I used the iron bar as a corner for (2) bridge location surveys. I removed the iron bar and replaced it with a Berntsen marker.

Describe or show any material discrepancy between the location of the restored corner and that of the corner previously restored or reestablished.

None known.

