


21706292000

U. S. PUBLIC LAND SURVEY MONUMENT RECORD

SECTION 28 T 17 N, R 6 W, TOWN OF HAMILTON

LA CROSSE COUNTY

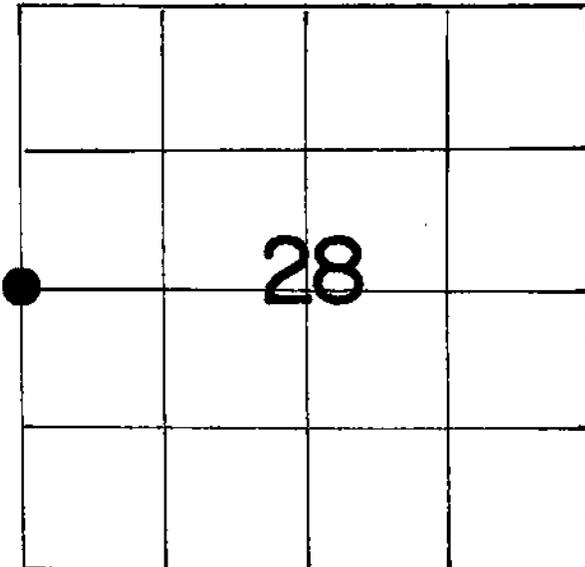

LOCATION OF LANDMARK

Crew: William C. Jung

Perry Dahl

5/1/85

Describe any record evidence, monument evidence, testimonial evidence or any other material evidence you considered and whether the monument was found or restored through acceptance of an obliterated evidence location.

I accepted the old occupied corner as the best available evidence of the original government corner and monumented the corner with a Berntsen monument. I found what I believe to be evidence of the old corner in the East-West fence.

Describe or show any material discrepancy between the location of the restored corner and that of the corner previously restored or reestablished.

None known.

WISCONSIN COORDINATE SYSTEM

North

East

Theta Angle

Horiz. Order

Vert. Order

TYPE OF LANDMARK

BERNTSEN

BEARINGS ARE REFERENCED TO


Assumed

RECORD OF DURABLE WITNESS MONUMENTS

| NO | DESCRIPTION | BEARING | DISTANCE |
|----|--|---------|----------|
| 1 | DOUBLE-BLAZED 9" HICKORY WITH P.K. NAIL | N9°W | 42.31' |
| 2 | DOUBLE-BLAZED 17" OAK WITH P.K. NAIL | N24°W | 34.99' |
| 3 | DOUBLE-BLAZED 11" CHERRY TREE WITH P.K. NAIL | S62°E | 9.97' |
| 4 | DOUBLE-BLAZED 10" OAK TREE WITH P.K. NAIL | N70°E | 17.99' |

(Each distance is to a P.K. nail in a hack on the side of the tree. All bearings are magnetic using a hand compass.)


~~(Each distance is to a P.K. nail in a hack. All bearings are magnetic.)~~

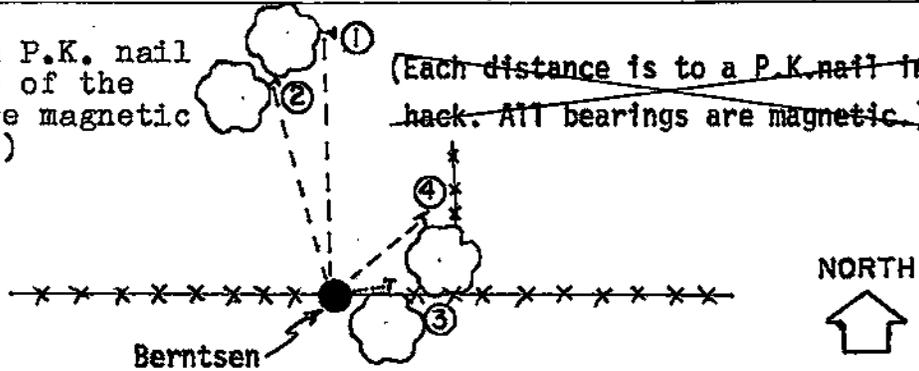

PLAN VIEW DRAWING OF REFERENCE TIES

MAP SHOWING DISTANCE AND DIRECTION TO OTHER PUBLIC LAND SURVEY CORNERS USED FOR REESTABLISHING THE CORNER


(Not to scale)

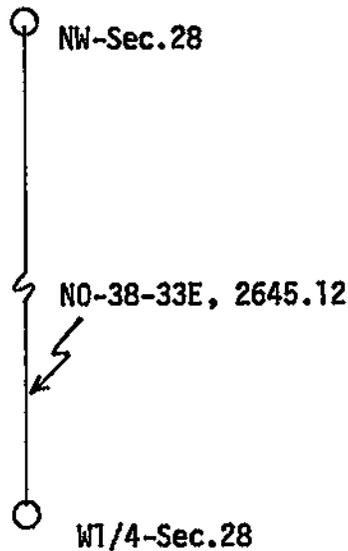

I, William C. Jung, Deputy County Surveyor,
 HEREBY CERTIFY THAT THE CORNER LOCATION SHOWN ON THIS RECORD
 WAS DETERMINED BY ME OR UNDER MY DIRECTION AND CONTROL AND
 THAT THIS U. S. PUBLIC LAND SURVEY MONUMENT RECORD IS CORRECT
 AND COMPLETE TO THE BEST OF MY KNOWLEDGE AND BELIEF.

William C. Jung
 Signature

2/4/86
 Date

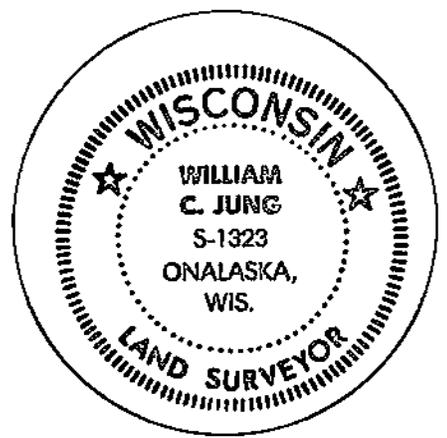

Seal