


21706300000

## U. S. PUBLIC LAND SURVEY MONUMENT RECORD

SECTION 32 T 17 N, R 6 W, TOWN OF HAMILTON

LA CROSSE COUNTY

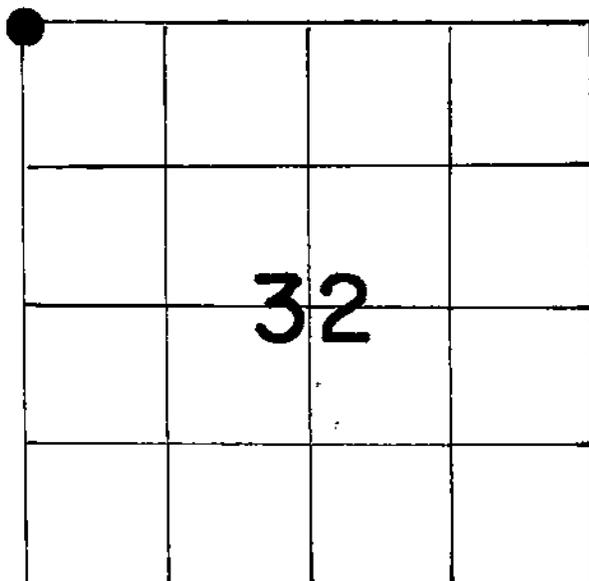

LOCATION OF LANDMARK

WISCONSIN COORDINATE SYSTEM

North

East

Theta Angle

Horiz. Order

Vert. Order

TYPE OF LANDMARK  
BERNTSEN

BEARINGS ARE REFERENCED TO

Magnetic as per 1979 Sims survey

Crew: William Jung  
Perry Dahl  
5/22/85

Describe any record evidence, monument evidence, testimonial evidence or any other material evidence you considered and whether the monument was found or restored through acceptance of an obliterated evidence location.


Ron Blummer (unlicensed) used this point as the corner in 1975. Ken Carlson set an iron bar at this corner in 1979. When working for Harley Sims in 1979, I used the iron bar as a corner for a bridge location survey. Bob Chalsma used this corner in 1984. I removed the iron bar and replaced it with a Berntsen marker.

Describe or show any material discrepancy between the location of the restored corner and that of the corner previously restored or reestablished.

None known.

RECORD OF DURABLE WITNESS MONUMENTS


NO	DESCRIPTION	BEARING	DISTANCE
1	TELEPHONE PEDESTAL (to center)	-----	30.4'
2	SET 1½" IRON PIPE	-----	28.84'
3	SET ¾" IRON ROD	-----	21.38'
4	STREET SIGN POST (to center)	-----	36.37'

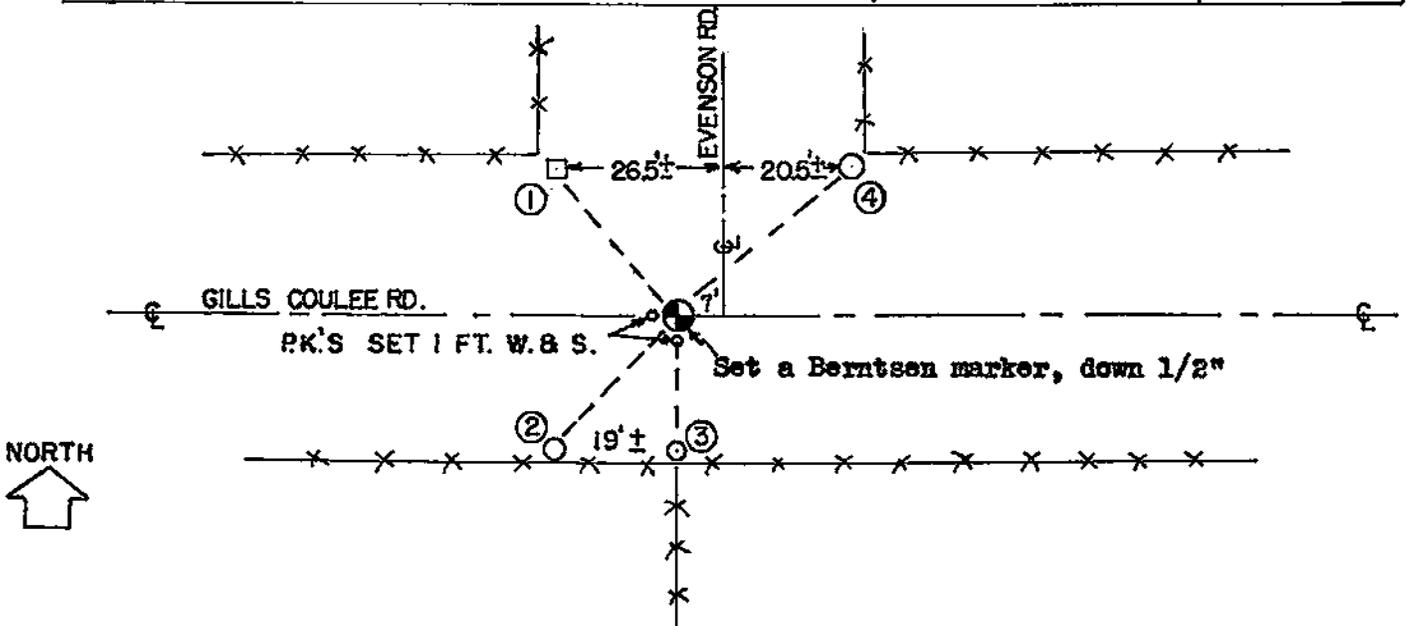

PLAN VIEW DRAWING OF REFERENCE TIES

MAP SHOWING DISTANCE AND DIRECTION TO OTHER PUBLIC LAND SURVEY CORNERS USED FOR REESTABLISHING THE CORNER

(Not to scale)

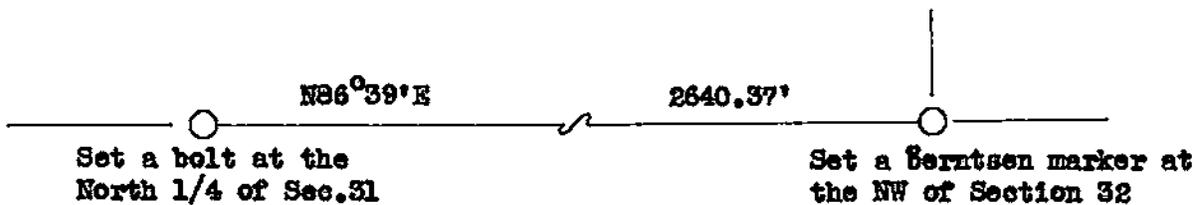

I, William C. Jung, Deputy County Surveyor,  
 HEREBY CERTIFY THAT THE CORNER LOCATION SHOWN ON THIS RECORD  
 WAS DETERMINED BY ME OR UNDER MY DIRECTION AND CONTROL AND  
 THAT THIS U. S. PUBLIC LAND SURVEY MONUMENT RECORD IS CORRECT  
 AND COMPLETE TO THE BEST OF MY KNOWLEDGE AND BELIEF.

William C. Jung 10/7/83  
 Signature Date



Seal