


21706310000

U. S. PUBLIC LAND SURVEY MONUMENT RECORD

SECTION 32 T 17 N, R 6 W, TOWN OF HAMILTON

LA CROSSE COUNTY

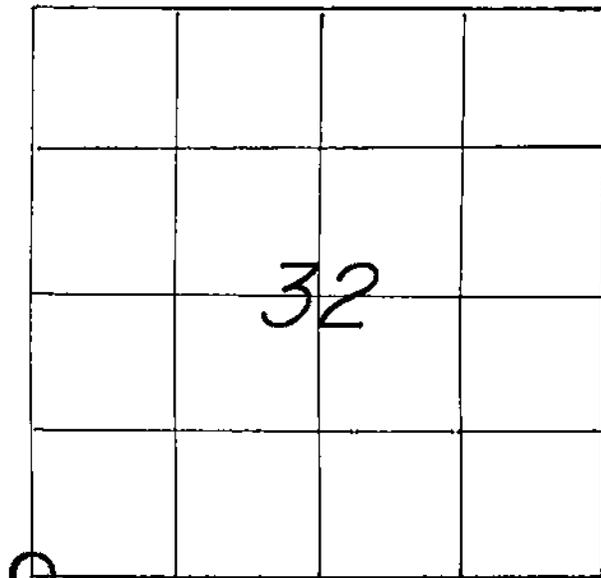

LOCATION OF LANDMARK

CREW: **WILLIAM C. JUNG**
PETER F. FOLLANSBEE
 DATE: **5/04/2000**

WISCONSIN COORDINATE SYSTEM

North

East

Theta Angle

Horiz. Order

Vert. Order

TYPE OF LANDMARK Mag Nail

~~COMPUTED LOCATION BY WITNESS POINTS.~~

BEARINGS ARE REFERENCED TO

Describe any record evidence, monument evidence, testimonial evidence or any other material evidence you considered and whether the monument was found or restored through acceptance of an obliterated evidence location.

There was a P.K. nail at this corner that had been used as the corner in previous survey work. It also fit the occupied conditions. I accepted it as the best available evidence of the original government corner position. On 7/6/98 I tied this P.K. nail off. It was later lost to road construction. I did not reset this corner as it is too dangerous to work out in this highway. Our ties give enough data to compute out the old location of the P.K. nail. *****


Describe or show any material discrepancy between the location of the restored corner and that of the corner previously restored or reestablished.

NONE KNOWN.

***** Dick Berg set a mag nail at this corner 9/2/02.


RECORD OF DURABLE WITNESS MONUMENTS

NO	DESCRIPTION	BEARING	DISTANCE
1	EX. IRON PIPE AT NORTH EDGE OF PAVEMENT	N.'WESTERLY ±	30.05 FT.
2	EX. IRON PIPE AT NORTH EDGE OF PAVEMENT	NORTHERLY ±	21.45 FT.
3	EX. IRON PIPE AT NORTH EDGE OF PAVEMENT	N.'EASTERLY ±	30.01 FT.
4	EX. IRON PIPE NEAR THE BOTTOM OF THE BACKSLOPE	NORTHERLY ±	60 FT. ±

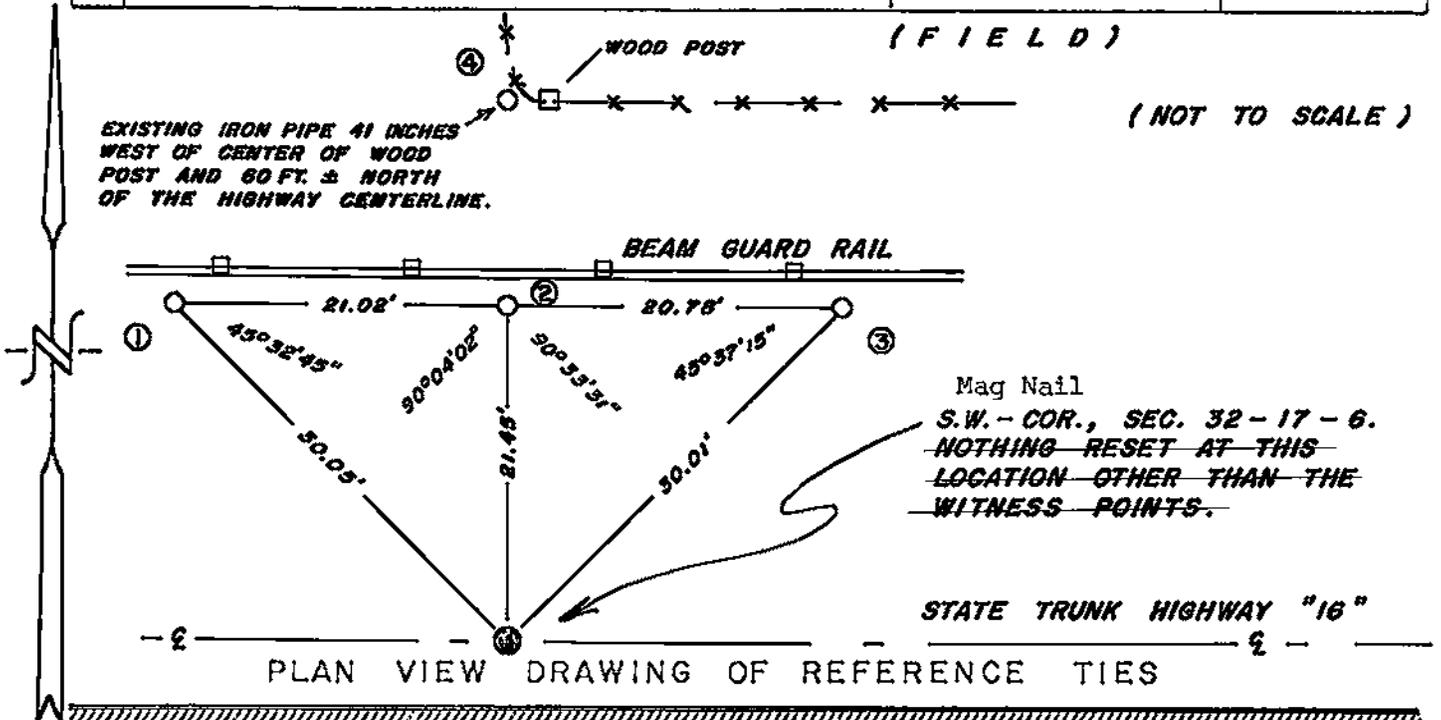

MAP SHOWING DISTANCE AND DIRECTION TO OTHER PUBLIC LAND SURVEY CORNERS USED FOR REESTABLISHING THE CORNER

(not to scale)

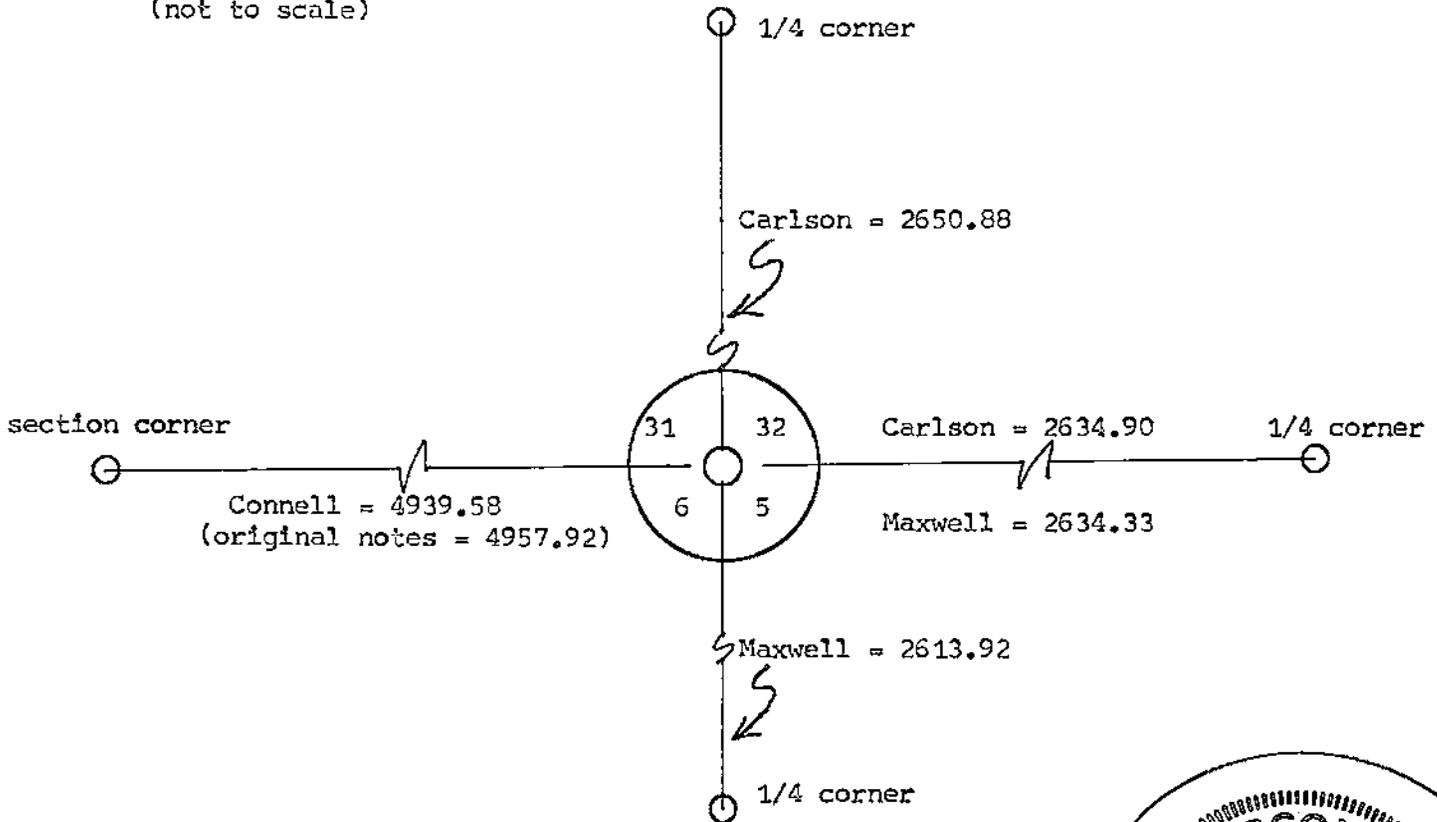

I, WILLIAM C. JUNG, COUNTY SURVEYOR
 HEREBY CERTIFY THAT THE CORNER LOCATION SHOWN ON THIS RECORD WAS DETERMINED BY ME OR UNDER MY DIRECTION AND CONTROL AND THAT THIS U. S. PUBLIC LAND SURVEY MONUMENT RECORD IS CORRECT AND COMPLETE TO THE BEST OF MY KNOWLEDGE AND BELIEF.

William C. Jung 11/28/00
 Signature Date

Revised: 11/22/02 *wey*



BERG enterprises

W7463 Sylvester Road
Holmen, Wisconsin 54636
Phone (608) 526-9248

October 30, 2002

I, Richard A. Berg, Registered Land Surveyor, hereby certify that on September 2, 2002, with the assistance of Dustin Berg, set a mag nail at the northeast corner of Section 6, T16N, R6W, Town of Hamilton, LaCrosse County, Wisconsin. The corner falls approximately in the centerline of the pavement on State Trunk Highway 16.

We set the corner at the location shown on the U.S. Public Land Survey Monument Record prepared by William C. Jung, LaCrosse County Surveyor, on November 28, 2000. All of the witness monuments shown on Mr. Jung's U.S. Public Land Survey Monument Record were still intact. Therefore, the same distances and directions to the same witness monuments still apply.

Dated this 30th day of October, 2002


Richard A. Berg, RLS #1213

