


U. S. PUBLIC LAND SURVEY MONUMENT RECORD

SECTION 32 T 17 N, R 6 W, TOWN OF HAMILTON

LA CROSSE COUNTY

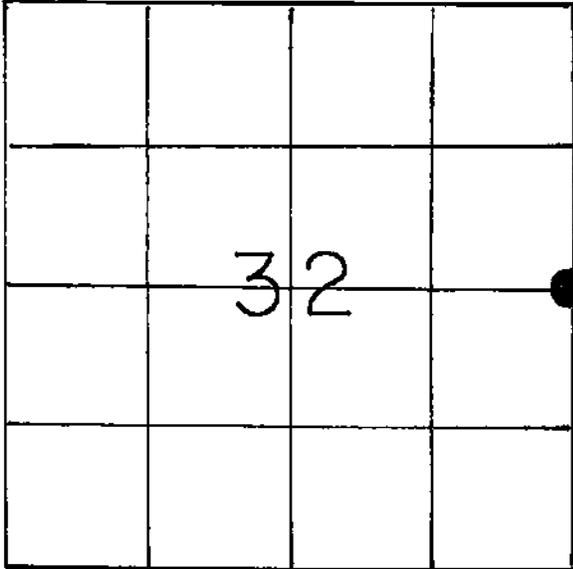

LOCATION OF LANDMARK

WISCONSIN COORDINATE SYSTEM

North

East

Theta Angle

Horiz. Order

Vert. Order

TYPE OF LANDMARK

Brass capped Lunde marker

BEARINGS ARE REFERENCED TO

Crew: William C. Jung
Peter F. Follansbee

Date: August 15, 1991

Describe any record evidence, monument evidence, testimonial evidence or any other material evidence you considered and whether the monument was found or restored through acceptance of an obliterated evidence location.


I accepted the old occupied fence corner as the best available evidence of the original government corner position. The corner was monumented with a Lunde marker. A whiskey bottle with a shell casing was buried by the marker. The Lunde was set N35°W, 1.2 feet from Lampman's nail. It was very hard digging because of tree roots. This fence corner has been used as the corner in previous survey work.

Describe or show any material discrepancy between the location of the restored corner and that of the corner previously restored or reestablished.

None known.

RECORD OF DURABLE WITNESS MONUMENTS

NO	DESCRIPTION	BEARING	DISTANCE
1	P.K. in single blazed 8" elm with a sign	-----	0.98
2	P.K. in an unblazed 12" basswood 5' N. of fence	-----	11.42
3	P.K. in single blazed 13" cherry 3' W. of fence	-----	15.87
4	P.K. in single blazed 7" box elder 3' N. of fence	-----	43.62

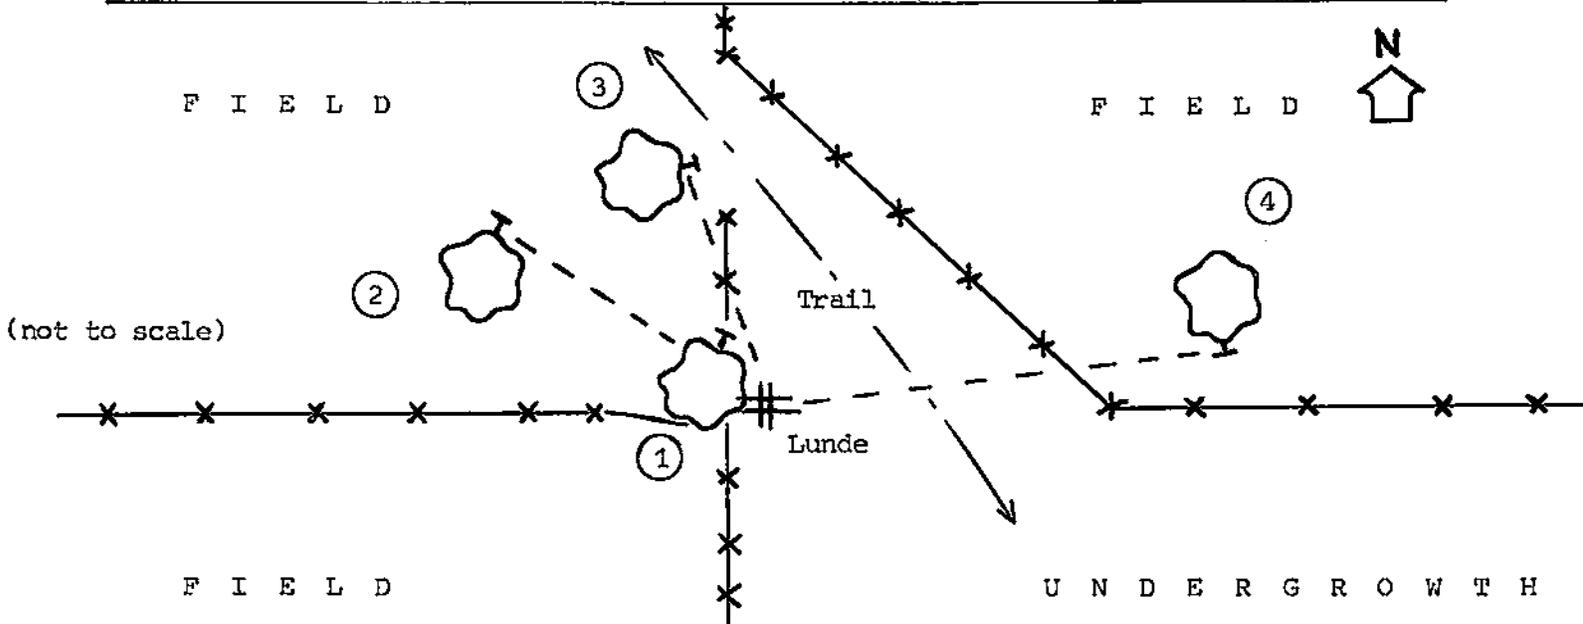

PLAN VIEW DRAWING OF REFERENCE TIES


MAP SHOWING DISTANCE AND DIRECTION TO OTHER PUBLIC LAND SURVEY CORNERS USED FOR REESTABLISHING THE CORNER

No section measurements made by me at this time.

I, William C. Jung, Deputy County Surveyor,
 HEREBY CERTIFY THAT THE CORNER LOCATION SHOWN ON THIS RECORD
 WAS DETERMINED BY ME OR UNDER MY DIRECTION AND CONTROL AND
 THAT THIS U. S. PUBLIC LAND SURVEY MONUMENT RECORD IS CORRECT
 AND COMPLETE TO THE BEST OF MY KNOWLEDGE AND BELIEF.

William C. Jung
 Signature

November 6, 1991
 Date

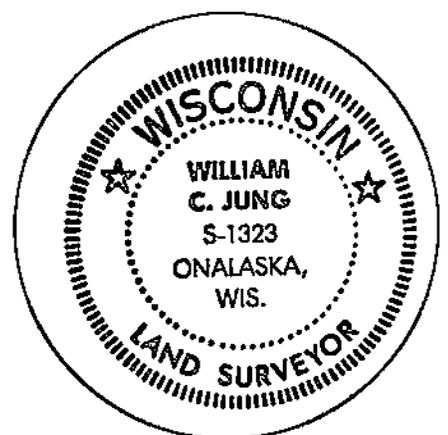

Seal