


U. S. PUBLIC LAND SURVEY MONUMENT RECORD

SECTION 34 T 17 N, R 6 W, ~~TOWN~~ OF VILLAGE OF WEST SALEM
LA CROSSE COUNTY

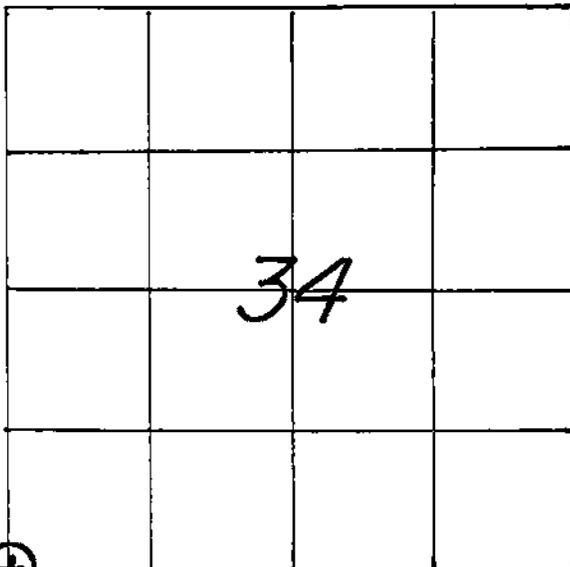

LOCATION OF LANDMARK

CREW: WILLIAM C. JUNG
PETER F. FOLLANSBEE
DATE: 7/30/2002

WISCONSIN COORDINATE SYSTEM

North 694,069.123

East 1,680,850.737

Theta Angle

Horiz. Order

Vert. Order

DATUM: NAD 1983('91)

TYPE OF LANDMARK

3/4" x 30" IRON BAR IN BIT. PAVEMENT

BEARINGS ARE REFERENCED TO

GRID NORTH AS PER SECTION DATA.

Describe any record evidence, monument evidence, testimonial evidence or any other material evidence you considered and whether the monument was found or restored through acceptance of an obliterated evidence location.

The monument at this corner was knocked out during the reconstruction of "16" last year. I reset the corner with an iron bar.


Describe or show any material discrepancy between the location of the restored corner and that of the corner previously restored or reestablished.

I do not agree with the mag nail set by Maxwell. This nail is $S71^{\circ}24'E$, 0.08 feet from my iron bar.

RECORD OF DURABLE WITNESS MONUMENTS


NO	DESCRIPTION	BEARING	DISTANCE
1	RESET AN EXISTING 1-1/4" O.D. IRON PIPE (FOUND BENT)	NORTHERLY ±	32.86 FT.
2	SET A DRILL HOLE ON TOP OF CURB, 2' EAST OF END	EASTERLY ±	41.57 FT.
3	SET A DRILL HOLE ON TOP OF CURB, 1' EAST OF JOINT	S. EASTERLY ±	55.41 FT.
4	EX. 1-1/4" O.D. IRON PIPE 5-1/2" BACK OF SIDEWALK	SOUTHERLY ±	43.85 FT.

(NOT TO SCALE)

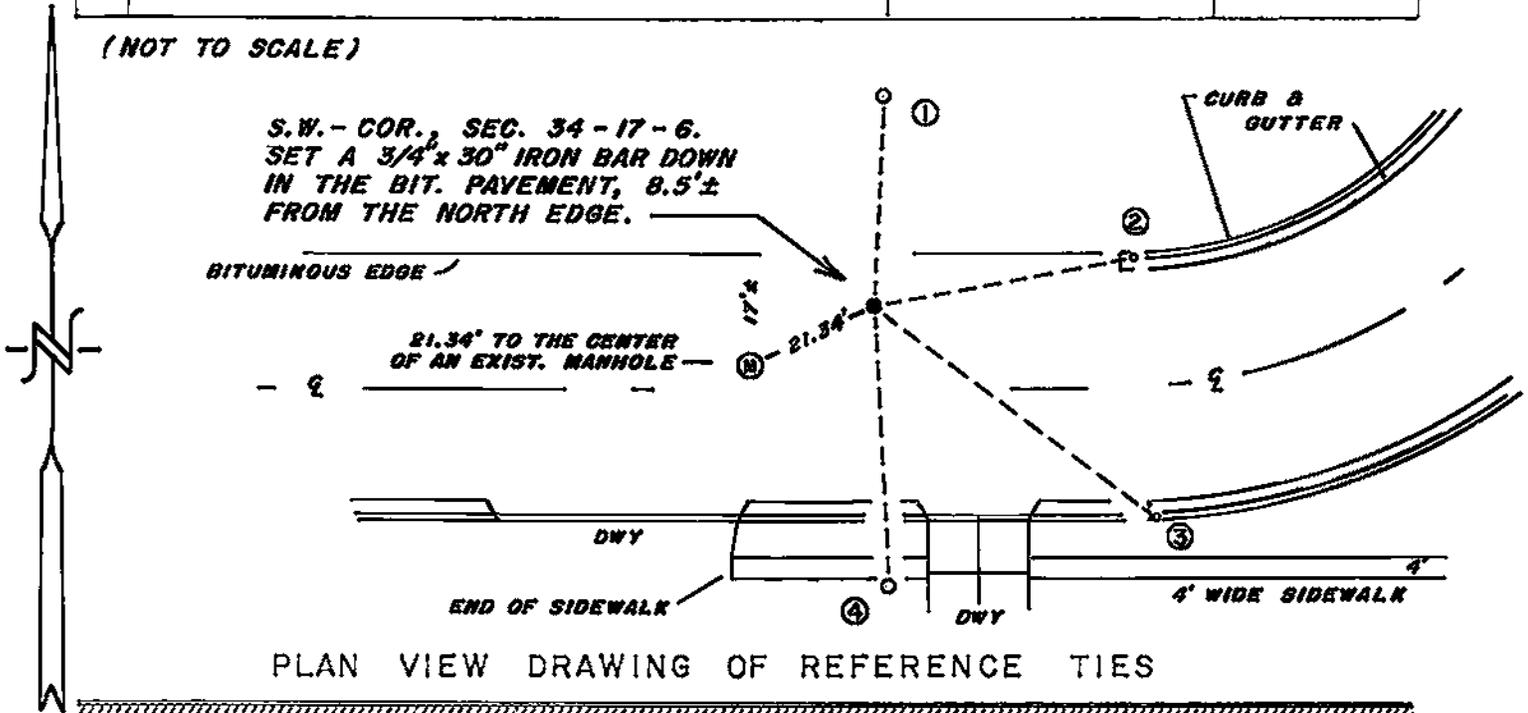


MAP SHOWING DISTANCE AND DIRECTION TO OTHER PUBLIC LAND SURVEY CORNERS USED FOR REESTABLISHING THE CORNER

(GRID BEARINGS & DISTANCES)
(GRID FACTOR: 0.999937736)
(NOT TO SCALE)

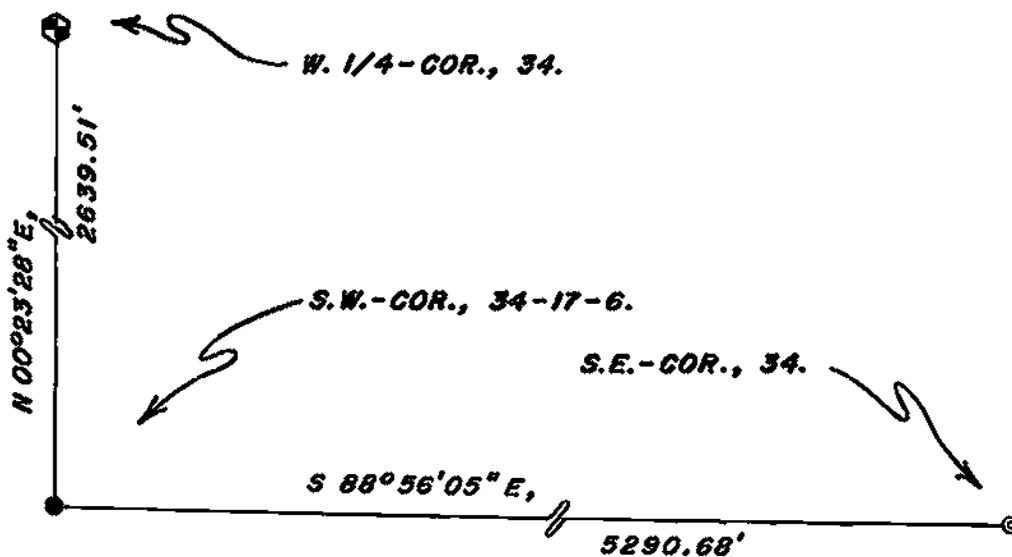

I, WILLIAM C. JUNG, COUNTY SURVEYOR
HEREBY CERTIFY THAT THE CORNER LOCATION SHOWN ON THIS RECORD
WAS DETERMINED BY ME OR UNDER MY DIRECTION AND CONTROL AND
THAT THIS U. S. PUBLIC LAND SURVEY MONUMENT RECORD IS CORRECT
AND COMPLETE TO THE BEST OF MY KNOWLEDGE AND BELIEF.

William C. Jung 12/27/02
Signature Date

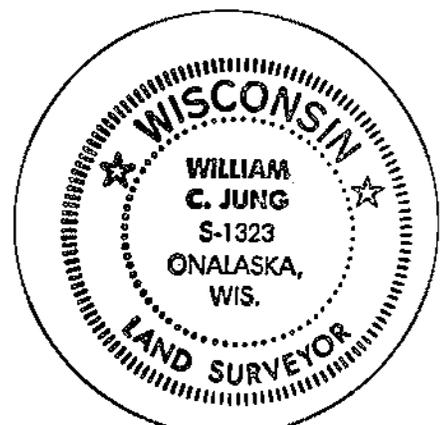


Seal

U. S. PUBLIC LAND SURVEY MONUMENT RECORD

SECTION 4 T 16 N, R 6 W, ^{VILLAGE} TOWN OF WEST SALEM

LA CROSSE COUNTY

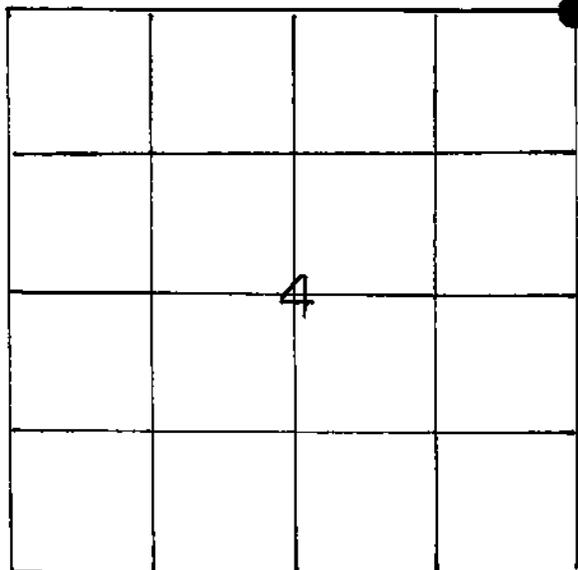

LOCATION OF LANDMARK

Crew: William Jung
Perry Dahl

11/29/84

WISCONSIN COORDINATE SYSTEM

North

East

Theta Angle

Horiz. Order

Vert. Order

TYPE OF LANDMARK

Railroad Spike

BEARINGS ARE REFERENCED TO

Assumed

Describe any record evidence, monument evidence, testimonial evidence or any other material evidence you considered and whether the monument was found or restored through acceptance of an obliterated evidence location.

This corner caused me a lot of problems as my research showed that it had at least four possible locations. The Village maps show it to be in the centerline of Garland Street. Ken Carlson set a 3/4" iron bar at the corner in the Spring of 1979. He noted at least two possible corner locations. James Allen shows a corner in May of 1966 that would have been about 10.7' South of Carlson's corner. In 1981 Greg Hofmeister disagreed with Carlson's corner and set an iron pipe. A Clayton Solberg map of October, 1962, shows a corner that would differ from Carlson and Hofmeister. I reset the corner at Carlson's location. His iron bar was destroyed during street construc-

Describe or show any material discrepancy between the location of the restored corner and that of the corner previously restored or reestablished.

(see notes below)

continued:

tion. Lenschow used this location in 1972 as did Lampman in March of 1985. The Plats of Salem Territory and First Addition to Salem Territory are tied to my corner location. Therefore my corner agrees with Carlson, Lenschow, Pederson, Chalsma, and DOT hwy. maps dating back to 1935. Allen, Hofmeister, and Clayton Solberg disagree with this final location. I discussed this problem with Ray Pelishek, and he agrees with my location too. Also, Dick Berg and Rob Lampman agree with my final corner. My traversing and computations indicate to me that my corner best fits the original government corner location.

