

21706332000

LaCrosse County U.S. Public Land Survey Monument Record

RECORD OF LAND CORNER PERPETUATION

No. _____

STATE OF WISCONSIN

County of Monroe ss.

I, William C. Jung, hereby certify that the information shown hereon correctly describes the original corner, resurvey information, evidence found, type of monument found or placed, and witness monuments and accessories used to perpetuate the location of the original or established corner.

Dated this 12th day of August, 19 83

at Tomah, Wisconsin.


William C. Jung

Registered Land Surveyor 1323


Title

COUNTY LaCrosse		
TOWN Village of West Salem		
HIGHWAY 33' West of West Ave. centerline		
SECTION 33	TOWNSHIP T17N	RANGE R6W
TYPE OF LANDMARK Brass capped Lunde marker 1 5/8" Iron Pipe		

Date of Survey August 5, 1983 Revision: March 26, 1992
 Drafted by Jung Jung
 Date August 12, 1983 June 8, 1992 *awj*

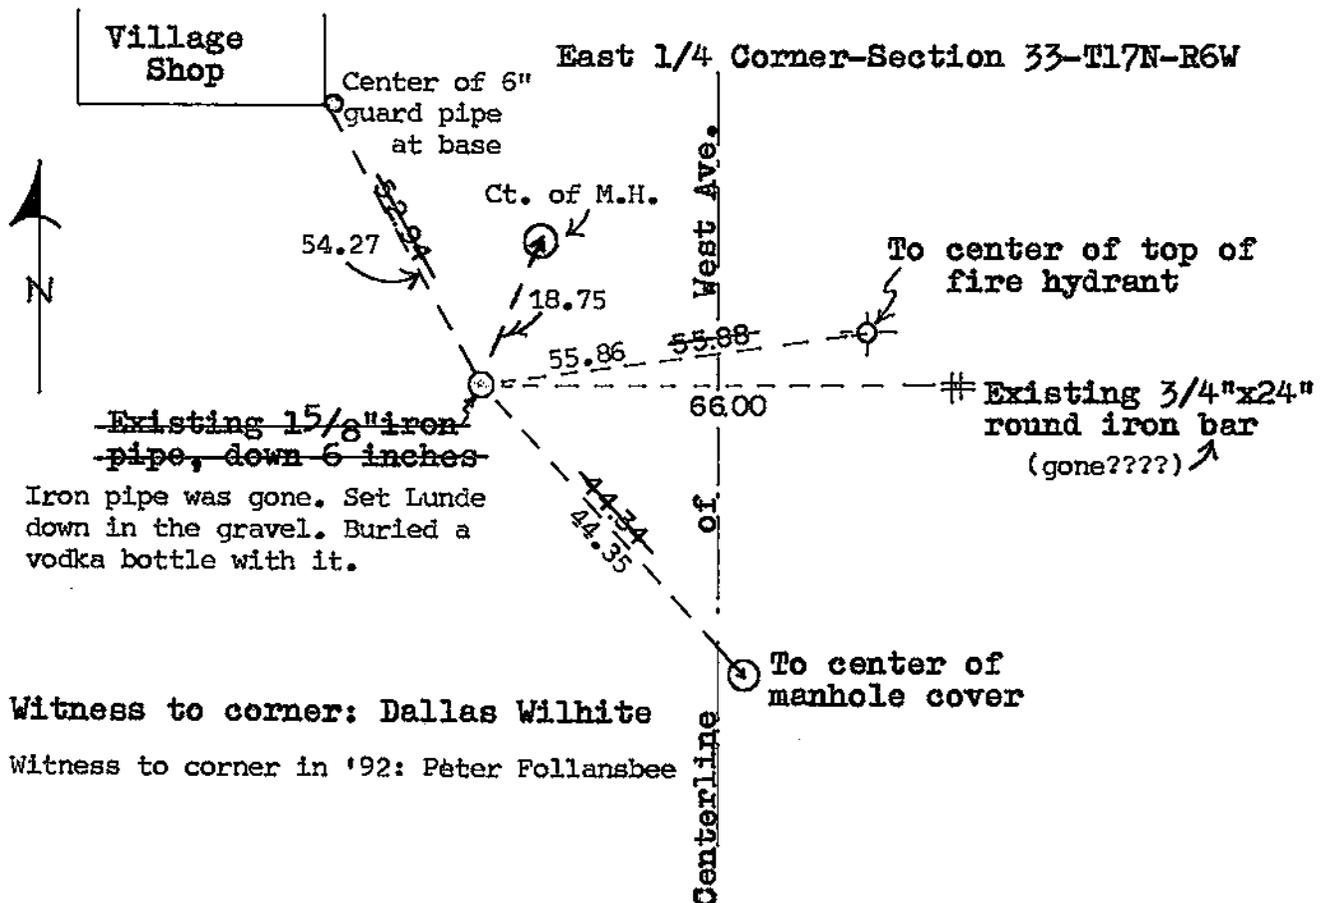

WISCONSIN COORDINATE SYSTEM	
North <u>696,708.571</u>	Zone <u>SOUTH</u>
East <u>1,680,868.759</u>	<u>1983('91)</u>
Elevation	Theta Angle
Vertical control order	
Horizontal control order	

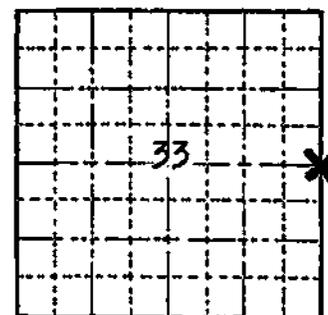

REMARKS: I found an existing iron pipe at the corner which had been used in previous surveys, including one by myself in April of 1982, a survey by Hofmeister in June of 1981, a survey by Lampman in March of 1981, a survey by Marten in November of 1972, a survey by Bandow in November of 1974, and a survey by Denzine in March of 1977.

LOCATION SKETCH
(Location of landmark indicated by "x")