


21706340020

 U. S. PUBLIC LAND SURVEY MOUMENT RECORD

 SECTION 34, T.17N., R.6W., VILLAGE OF WEST SALEM
 LACROSSE COUNTY, WISCONSIN

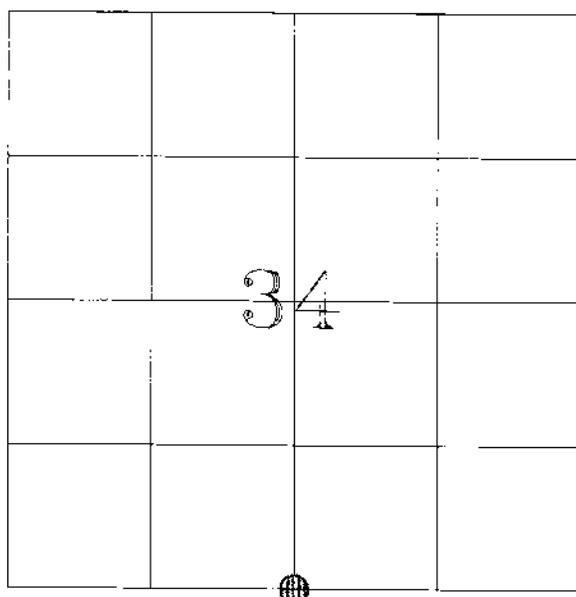

LOCATION OF LANDMARK

 Crew: Rodney H. Maxwell
 Laurence E. Johns III

Date: 7 January 2002

WISCONSIN COORDINATE SYSTEM
North
East
Theta Angle
Horiz. Order
Vert. Order
TYPE OF LANDMARK:
No Monument Set Falls on Manhole Cover
BEARINGS ARE REFERENCED TO:
Assumed Datum

Describe any record evidence, monument evidence, testimonial evidence or any other material evidence you considered and whether the monument was found or restored through acceptance of an obliterated evidence location.


This corner is shown on existing plats and surveys at the intersection of Leonard and Garland Streets starting with the Original Plat.

Describe or show any material discrepancy between the location of the restored corner and that of the corner previously restored or reestablished.

There have been other locations for this corner used on other surveys. All the other locations indicate they are on the manhole cover, some indicate the center of the manhole cover to be the corner. Even though this corner has been used several times on Surveys there is no other record of a tie sheet. I have recreated the intersection of the two streets to the best of my ability.


RECORD OF DURABLE WITNESS MONUMENTS

NO.	DESCRIPTION	BEARING	DISTANCE
1	Drill Hole (Existing)	S 45°38'43" W	46.41'
2	Set 3/4" x 18" Iron Rod	N 44°21'18" W	46.93'
3	Set 3/4" x 18" Iron Rod	N 45°23'28" E	46.61'
4	Set 3/4" x 18" Iron Rod	S 44°36'32" E	46.72'

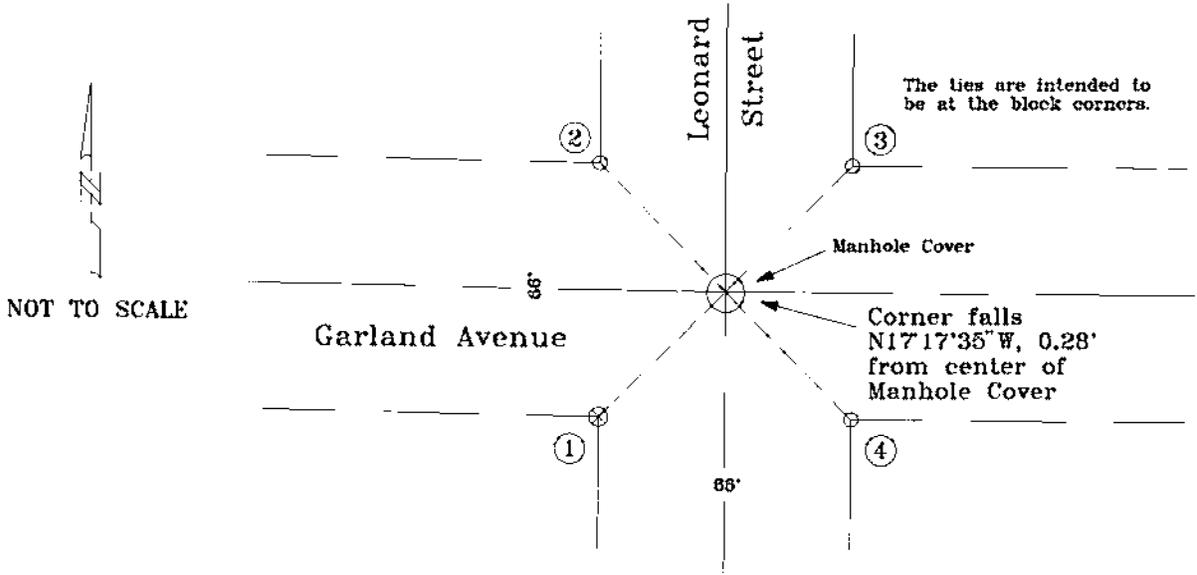

PLAN VIEW DRAWING OF REFERENCE TIES

Map Showing Distance And Direction To Other Public Land Survey Corners Used For Re-Establishing The Corner

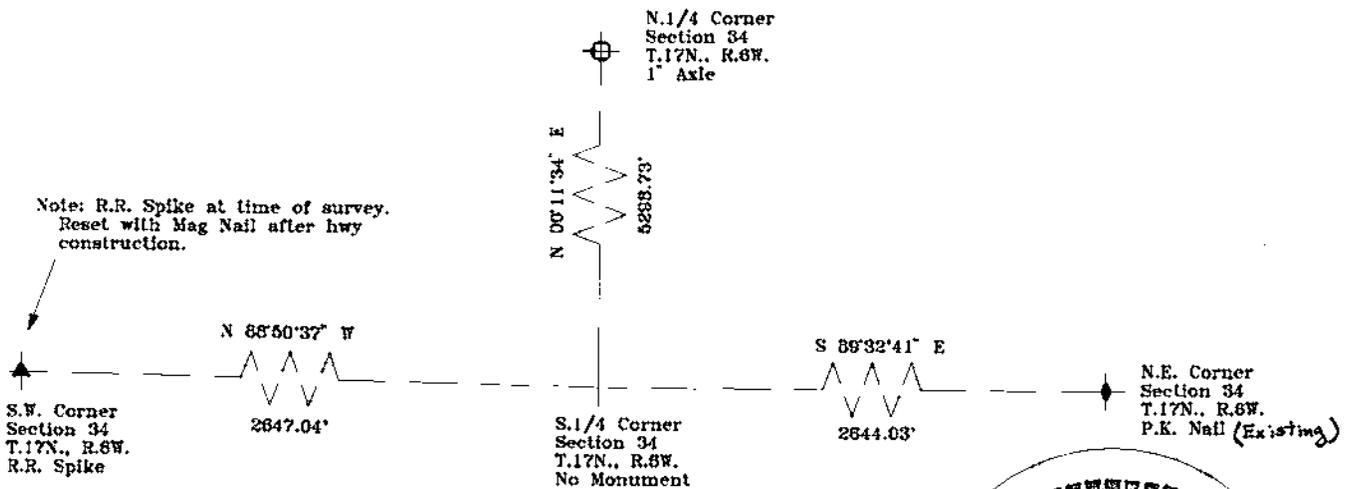

I, Rodney H. Maxwell, Registered Land Surveyor, hereby certify that the corner location shown on this record was determined by me or under my direction and control, and that this U.S. Public Land Survey Monument Record is correct and complete to the best of my knowledge and belief.

Rodney H. Maxwell

Rodney H. Maxwell
Maxwell Surveying
7457 Highway 16, Suite C
Sparta, Wisconsin
7 January 2002

