


21706342000

U. S. PUBLIC LAND SURVEY MONUMENT RECORD

SECTION 34 T 17 N, R 6 W, VILLAGE OF WEST SALEM

LA CROSSE COUNTY

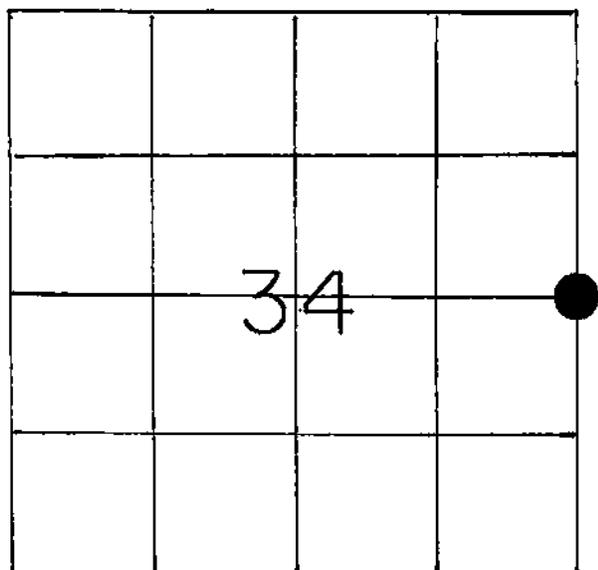

LOCATION OF LANDMARK

Crew: William Jung
Peter Follansbee

8/4/1987

Describe any record evidence, monument evidence, testimonial evidence or any other material evidence you considered and whether the monument was found or restored through acceptance of an obliterated evidence location.

I accepted an angle iron fence post set in concrete as the best available evidence of the original government corner position. This point has also been used as the corner in previous survey work.

Describe or show any material discrepancy between the location of the restored corner and that of the corner previously restored or reestablished.

NONE KNOWN

WISCONSIN COORDINATE SYSTEM

North

East

Theta Angle

Horiz. Order

Vert. Order


TYPE OF LANDMARK

ANGLE IRON FENCE POST IN CONCRETE

BEARINGS ARE REFERENCED TO
True North

RECORD OF DURABLE WITNESS MONUMENTS


NO	DESCRIPTION	BEARING	DISTANCE
1	SET 1 1/4" x 26" IRON PIPE	WEST ±	19.30 Ft.
2	SET 1 1/4" x 26" IRON PIPE	EAST ±	15.15 Ft.
3	SET 1 1/4" x 26" IRON PIPE	SOUTH ±	16.70 Ft.
4			

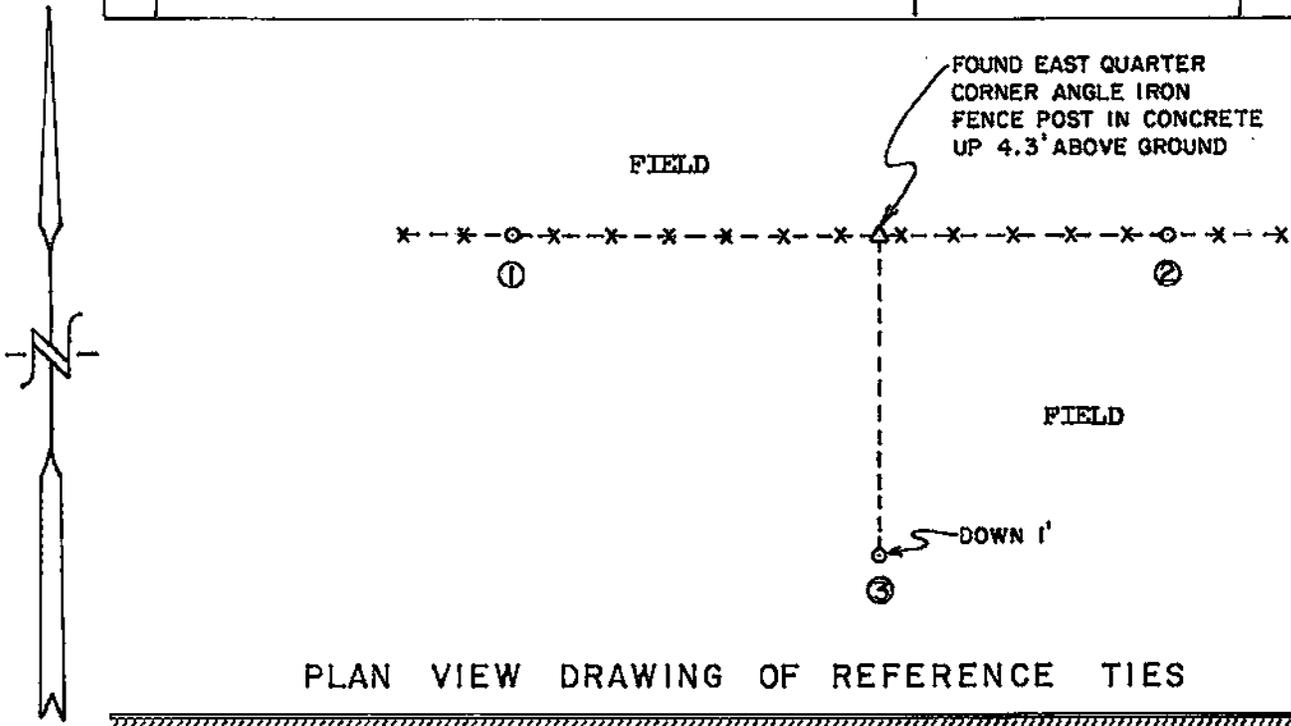

PLAN VIEW DRAWING OF REFERENCE TIES

MAP SHOWING DISTANCE AND DIRECTION TO OTHER PUBLIC LAND SURVEY CORNERS USED FOR REESTABLISHING THE CORNER


(NOT TO SCALE)

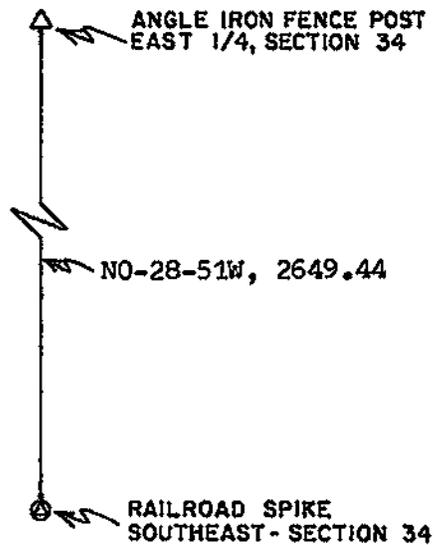

I, WILLIAM C. JUNG, Deputy County Surveyor
 HEREBY CERTIFY THAT THE CORNER LOCATION SHOWN ON THIS RECORD
 WAS DETERMINED BY ME OR UNDER MY DIRECTION AND CONTROL AND
 THAT THIS U. S. PUBLIC LAND SURVEY MONUMENT RECORD IS CORRECT
 AND COMPLETE TO THE BEST OF MY KNOWLEDGE AND BELIEF.

William C. Jung
 Signature

December 9, 1987
 Date

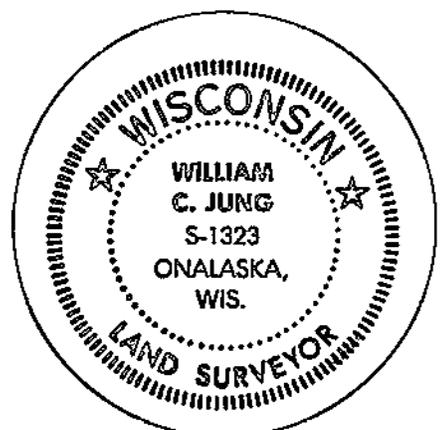

Seal