


U. S. PUBLIC LAND SURVEY MONUMENT RECORD

SECTION 35 T 17 N, R 6 W, TOWN OF Hamilton

LA CROSSE COUNTY

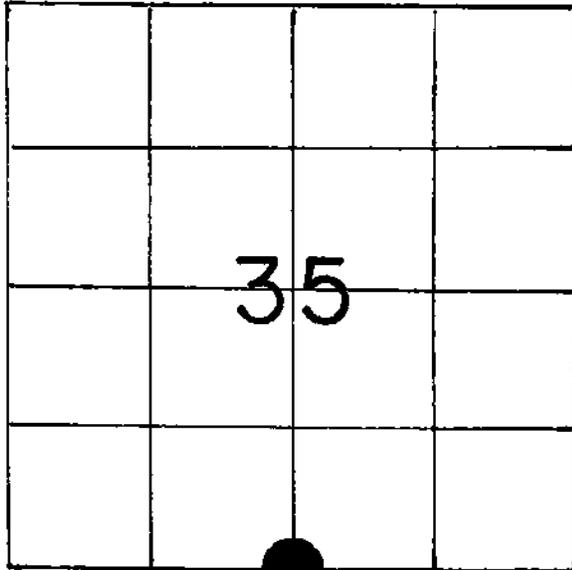

LOCATION OF LANDMARK

Crew: William C. Jung
Peter F. Follansbee

Date: June 28, 1989

Describe any record evidence, monument evidence, testimonial evidence or any other material evidence you considered and whether the monument was found or restored through acceptance of an obliterated evidence location.

The original government survey called for a 8" burr oak, North, 58 links. I believe the old burr oak to the North is the original government bearing tree. I set the corner by using the tree. I set a brass capped Lunde marker at the corner and buried a bottle on the Southeast side of the Lunde.

Describe or show any material discrepancy between the location of the restored corner and that of the corner previously restored or reestablished.

I found a railroad spike at the single proportionate position which I do not agree with. My corner is 5.6 feet South of the railroad spike.

WISCONSIN COORDINATE SYSTEM

North *693,933.827*East *1,688,788.852*

Theta Angle

Horiz. Order

Vert. Order

DATUM: *1983('91)*

TYPE OF LANDMARK


Brass capped Lunde marker

BEARINGS ARE REFERENCED TO

True


RECORD OF DURABLE WITNESS MONUMENTS

NO	DESCRIPTION	BEARING	DISTANCE
1	1" iron pipe at the SW cemetery corner	-----	119.48
2	8" timber nail in unblazed burr oak, c=8.3'	magnetic = N2°W	38.61
3	1" iron pipe at the SE cemetery corner	-----	30.74
4	Existing P.K. nail in power pole	-----	7.42

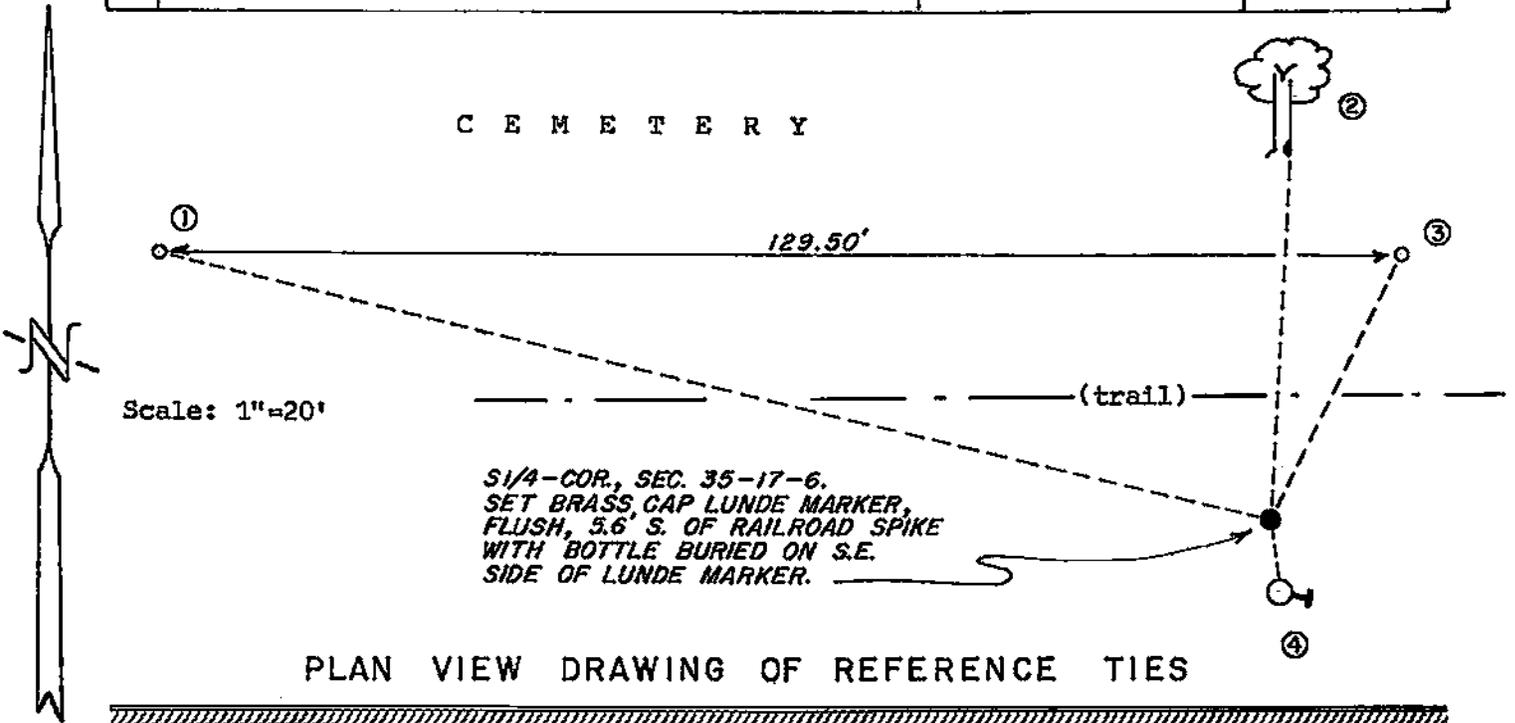


MAP SHOWING DISTANCE AND DIRECTION TO OTHER PUBLIC LAND SURVEY CORNERS USED FOR REESTABLISHING THE CORNER

(not to scale)

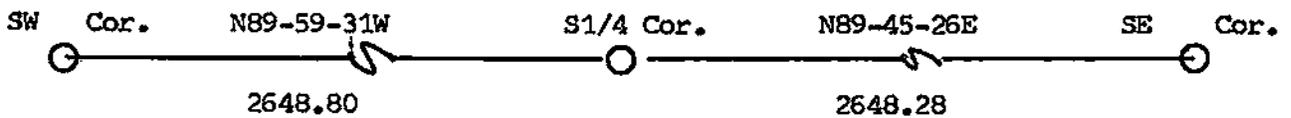

I, William C. Jung, Deputy County Surveyor,
HEREBY CERTIFY THAT THE CORNER LOCATION SHOWN ON THIS RECORD
WAS DETERMINED BY ME OR UNDER MY DIRECTION AND CONTROL AND
THAT THIS U. S. PUBLIC LAND SURVEY MONUMENT RECORD IS CORRECT
AND COMPLETE TO THE BEST OF MY KNOWLEDGE AND BELIEF.

William C. Jung July 20, 1989
Signature Date

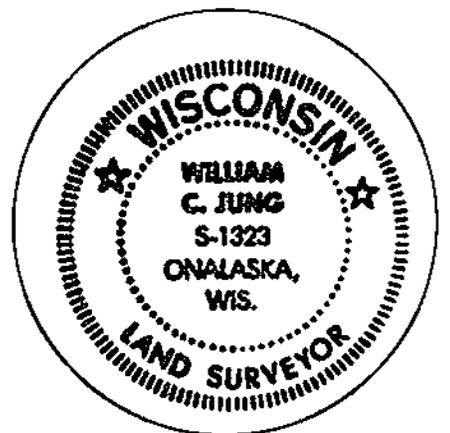

Seal