


21707132000

U. S. PUBLIC LAND SURVEY MONUMENT RECORD

SECTION 18 T 17 N, R 6 W, TOWN OF HAMILTON

LA CROSSE COUNTY

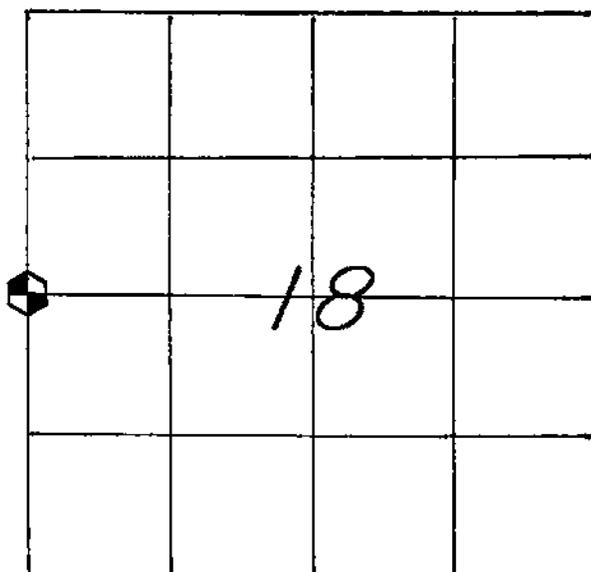

LOCATION OF LANDMARK

Crew: WILLIAM C. JUNG

PETER F. FOLLANSBEE

Date: 5/20/1997

Describe any record evidence, monument evidence, testimonial evidence or any other material evidence you considered and whether the monument was found or restored through acceptance of an obliterated evidence location.

I replaced Lampman's iron bar with a brass capped Lunde marker.

Describe or show any material discrepancy between the location of the restored corner and that of the corner previously restored or reestablished.

None Known.

WISCONSIN COORDINATE SYSTEM

North

East

Theta Angle

Horiz. Order

Vert. Order


TYPE OF LANDMARK

Brass cap Lunde marker.

BEARINGS ARE REFERENCED TO

RECORD OF DURABLE WITNESS MONUMENTS
MAGNETIC

NO	DESCRIPTION	BEARING	DISTANCE
1	Set nail in E.-side 13" White Oak	N 18°W	46.81 Ft.
2	Set nail in NW-side 7" Basswood	N 22°E	62.63 Ft.
3	Set nail in NW-side 13" Birch	N 37°E	32.92 Ft.
4	Set nail in NW-side 5" Hickory	N 42°E	36.97 Ft.

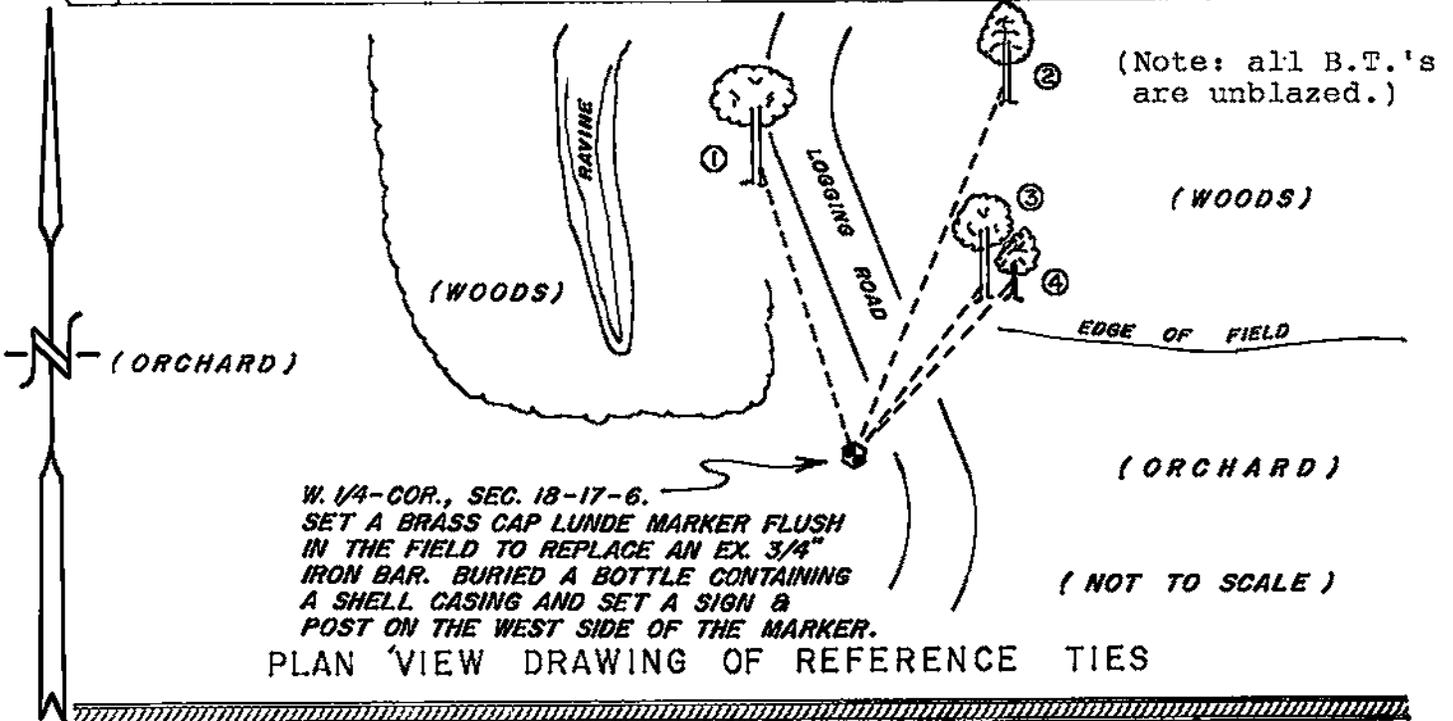

MAP SHOWING DISTANCE AND DIRECTION TO OTHER PUBLIC LAND SURVEY CORNERS USED FOR REESTABLISHING THE CORNER

No section measurements were made by me at this time. This location was confirmed by Lampman.

I, William C. Jung, County Surveyor
HEREBY CERTIFY THAT THE CORNER LOCATION SHOWN ON THIS RECORD WAS DETERMINED BY ME OR UNDER MY DIRECTION AND CONTROL AND THAT THIS U. S. PUBLIC LAND SURVEY MONUMENT RECORD IS CORRECT AND COMPLETE TO THE BEST OF MY KNOWLEDGE AND BELIEF.

William C. Jung 2/6/98
Signature Date



Seal