


21707240000

U. S. PUBLIC LAND SURVEY MONUMENT RECORD

SECTION 30 T 17 N, R 6 W, TOWN OF HAMILTON
LA CROSSE COUNTY

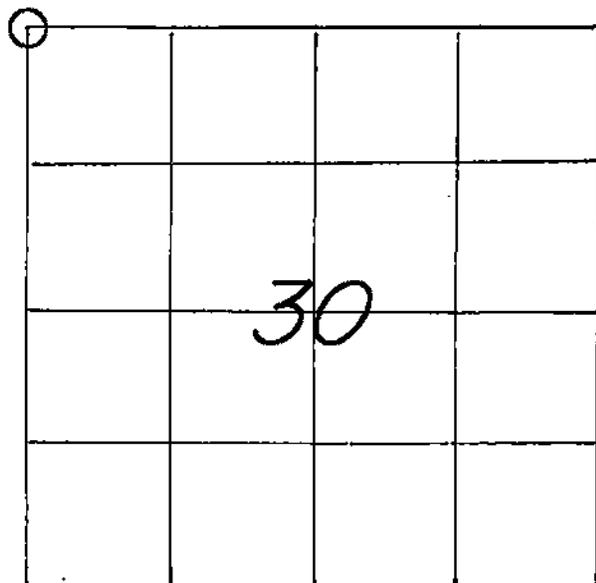

WISCONSIN COORDINATE SYSTEM

North

East

Theta Angle

Horiz. Order

Vert. Order

TYPE OF LANDMARK

2-1/2" IRON PIPE.

BEARINGS ARE REFERENCED TO

LOCATION OF LANDMARK

CREW: WILLIAM C. JUNG
PETER F. FOLLANSBEE
DATE: 7/08/1998

Describe any record evidence, monument evidence, testimonial evidence or any other material evidence you considered and whether the monument was found or restored through acceptance of an obliterated evidence location.


I found an iron pipe at the corner that had been used in previous survey work. I accepted the corner as the best available evidence of the original government corner position.

Describe or show any material discrepancy between the location of the restored corner and that of the corner previously restored or reestablished.

It would appear that Joe Murphy's section corner location was North at the fence intersection. I could not find any type of monument there.

RECORD OF DURABLE WITNESS MONUMENTS
MAGNETIC

NO	DESCRIPTION	BEARING	DISTANCE
1	NAIL IN N-SIDE 13-1/2" ASPEN	N 78° W	33.17 FT.
2	NAIL IN E-SIDE 21" WHITE OAK (existing blazes)	N 10° E	35.00 FT.
3	NAIL IN N.W-SIDE 7" HICKORY " "	N 34° E	12.43 FT.
4	NAIL IN N.W-SIDE 13" WHITE OAK " "	N 46° E	17.45 FT.

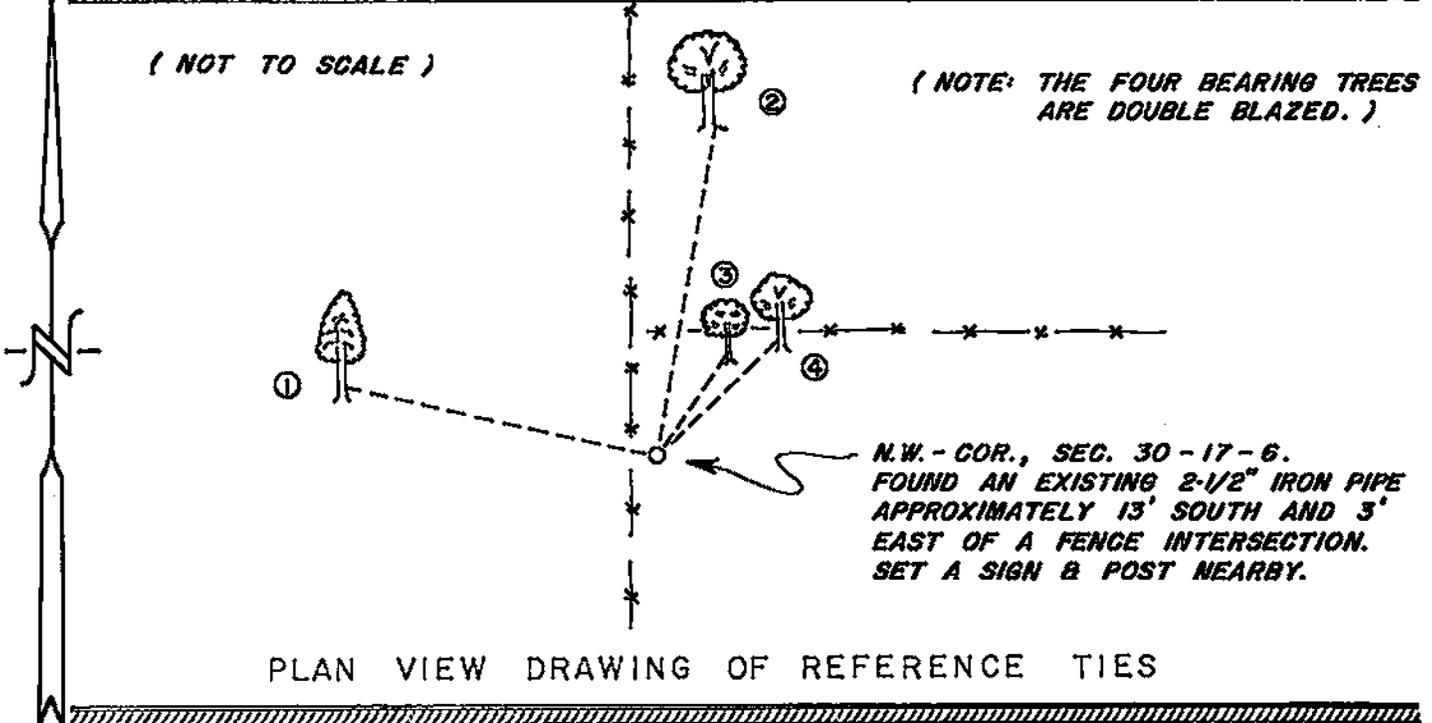


MAP SHOWING DISTANCE AND DIRECTION TO OTHER PUBLIC LAND SURVEY CORNERS USED FOR REESTABLISHING THE CORNER

No section measurements were made by me at this time. The location of this corner was confirmed previously by others with their section work.

I, WILLIAM C. JUNG, COUNTY SURVEYOR
HEREBY CERTIFY THAT THE CORNER LOCATION SHOWN ON THIS RECORD WAS DETERMINED BY ME OR UNDER MY DIRECTION AND CONTROL AND THAT THIS U. S. PUBLIC LAND SURVEY MONUMENT RECORD IS CORRECT AND COMPLETE TO THE BEST OF MY KNOWLEDGE AND BELIEF.

William C. Jung 3/24/99
Signature Date

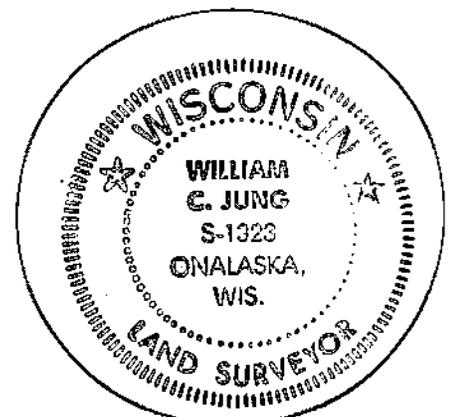

Seal