


U. S. PUBLIC LAND SURVEY MONUMENT RECORD

SECTION 19 T 17 N, R 6 W, TOWN OF Hamilton

LA CROSSE COUNTY

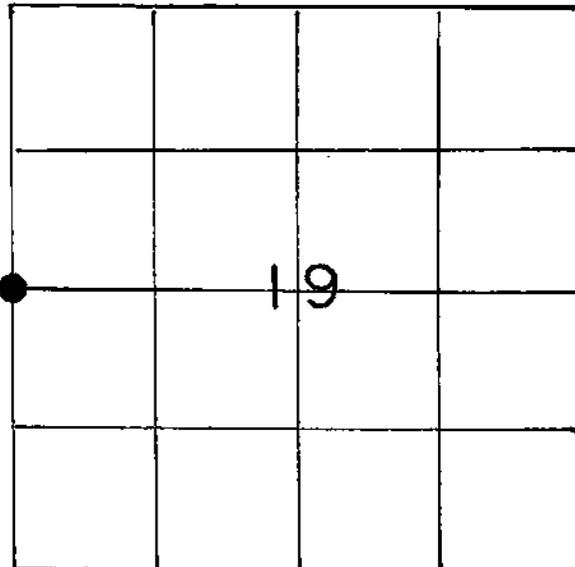

LOCATION OF LANDMARK

Crew: William C. Jung
Bernie Mickschl

July 9, 1987

WISCONSIN COORDINATE SYSTEM

North

East

Theta Angle

Horiz. Order

Vert. Order

TYPE OF LANDMARK

Existing 2½" iron pipe

BEARINGS ARE REFERENCED TO

Assumed as per Chalsma survey

Describe any record evidence, monument evidence, testimonial evidence or any other material evidence you considered and whether the monument was found or restored through acceptance of an obliterated evidence location.


Chalsma set an iron pipe at this corner in 1985. He set the corner by single proportionate measurement using the Northwest corner of Section 19 and the Southwest corner of Section 30. Lampman recently used this pipe as the corner. I accepted this pipe used in previous surveys as the best available evidence of the original government corner position.

Describe or show any material discrepancy between the location of the restored corner and that of the corner previously restored or reestablished.

None known.

RECORD OF DURABLE WITNESS MONUMENTS
MAGNETIC

NO	DESCRIPTION	BEARING	DISTANCE
1	P.K. nail in double blazed 9" hickory	S40°W	25.50
2	P.K. nail in double blazed large triple oak	N69°W	16.96
3	P.K. nail in double blazed 8" hickory	N75°E	12.59
4	P.K. nail in double blazed 8" hickory	S75°E	9.42

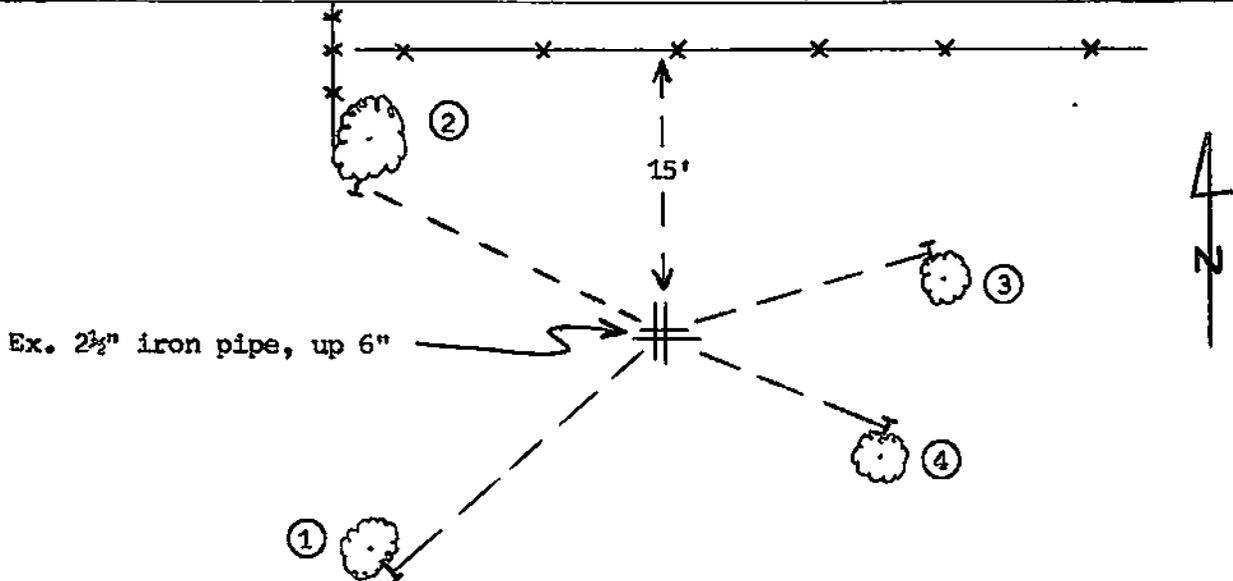


PLAN VIEW DRAWING OF REFERENCE TIES



MAP SHOWING DISTANCE AND DIRECTION TO OTHER PUBLIC LAND SURVEY CORNERS USED FOR REESTABLISHING THE CORNER


(not to scale)

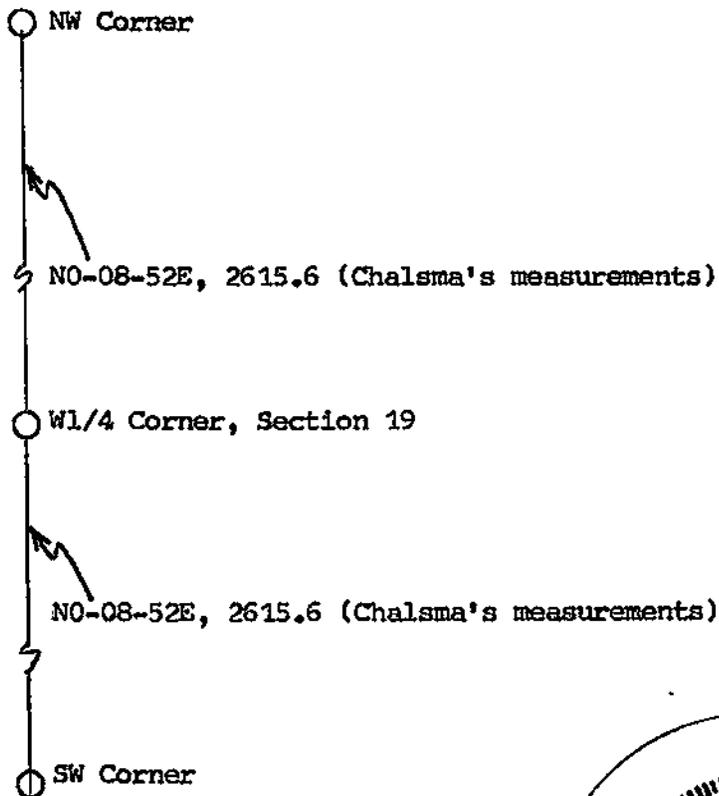

I, William C. Jung, Deputy County Surveyor,
HEREBY CERTIFY THAT THE CORNER LOCATION SHOWN ON THIS RECORD
WAS DETERMINED BY ME OR UNDER MY DIRECTION AND CONTROL AND
THAT THIS U. S. PUBLIC LAND SURVEY MONUMENT RECORD IS CORRECT
AND COMPLETE TO THE BEST OF MY KNOWLEDGE AND BELIEF.

William C. Jung
Signature

July 16, 1987
Date

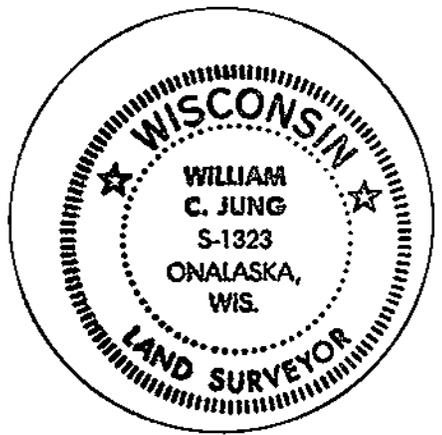

Seal