


21707252000

U. S. PUBLIC LAND SURVEY MONUMENT RECORD

SECTION 30 T 17 N, R 6 W, TOWN OF HAMILTON

LA CROSSE COUNTY

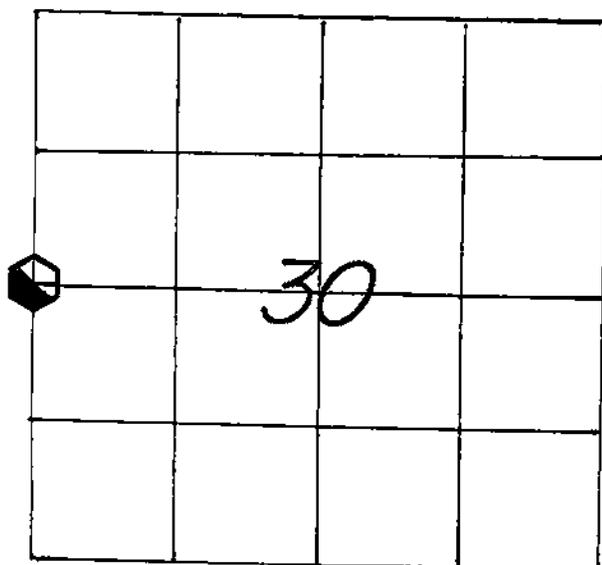

LOCATION OF LANDMARK

CREW: WILLIAM C. JUNG
 PETER F. FOLLANSBEE
 DATE: 5/19/2005

WISCONSIN COORDINATE SYSTEM	
North	702,124.796
East	1,665,365.096
Theta Angle	
Horiz. Order	
Vert. Order	
DATUM:	1983('91)
TYPE OF LANDMARK	
BERNTSEN MARKER.	
BEARINGS ARE REFERENCED TO	
GRID NORTH AS PER SECTION DATA.	

Describe any record evidence, monument evidence, testimonial evidence or any other material evidence you considered and whether the monument was found or restored through acceptance of an obliterated evidence location.


I found the Berntsen marker that I set back in 1985 and took new ties.

Describe or show any material discrepancy between the location of the restored corner and that of the corner previously restored or reestablished.


NONE KNOWN.

RECORD OF DURABLE WITNESS MONUMENTS

NO	DESCRIPTION	BEARING	DISTANCE
1	SET A 3/4" x 30" IRON BAR 3' WEST OF EDGE-OF-PAVEM'T	S.'WESTERLY ±	23.44 FT.
2	SET A 3/4" x 30" IRON BAR 3' WEST OF EDGE-OF-PAVEM'T	N.'WESTERLY ±	41.24 FT.
3	SET A 3/4" x 30" IRON BAR 6' WEST OF COR. OF BUILDING	N.'EASTERLY ±	51.93 FT.
4	SET A 3/4" x 30" IRON BAR 6' WEST OF COR. OF BUILDING	S.'EASTERLY ±	41.45 FT.

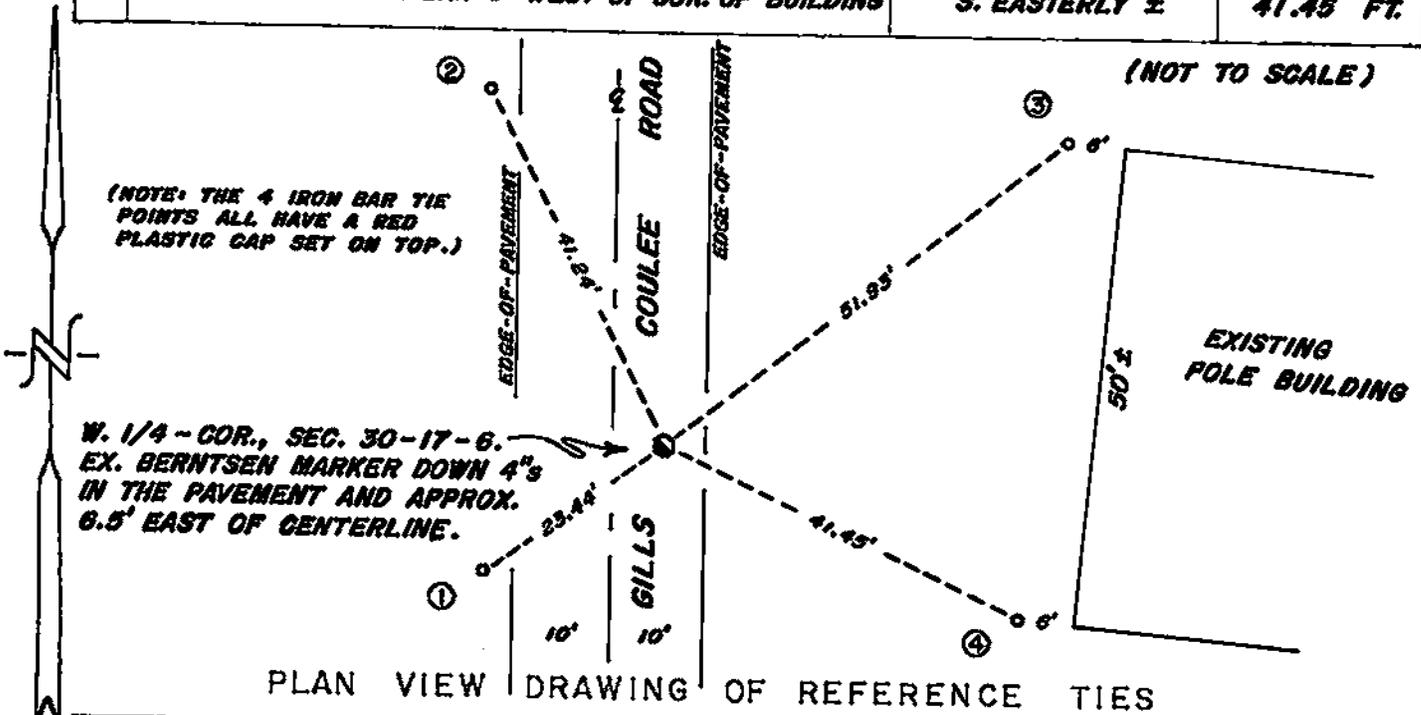


MAP SHOWING DISTANCE AND DIRECTION TO OTHER PUBLIC LAND SURVEY CORNERS USED FOR REESTABLISHING THE CORNER

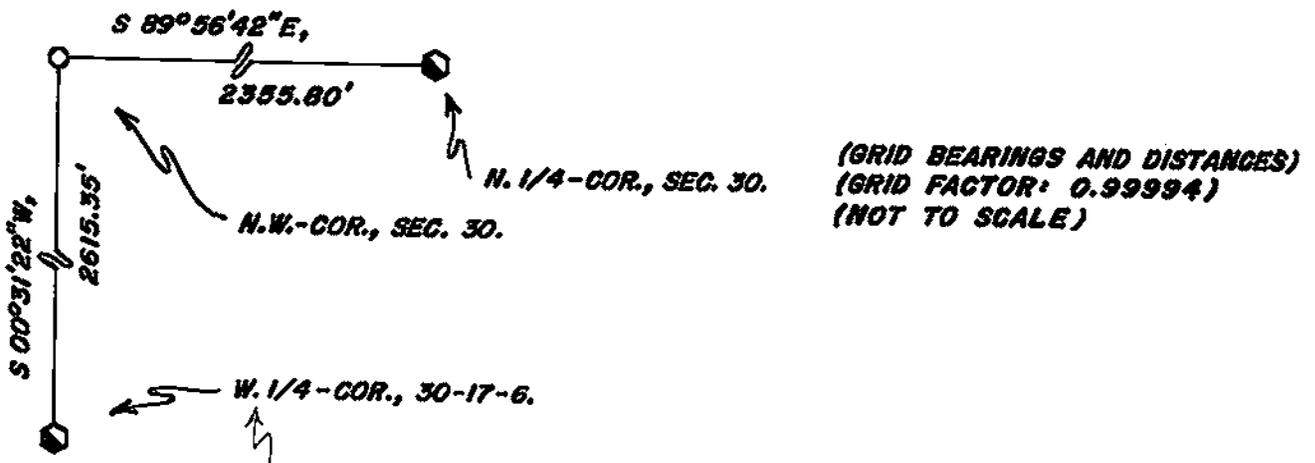

(For my measurements South of this corner, see my 1985 tie sheet.)

I, WILLIAM C. JUNG, COUNTY SURVEYOR
HEREBY CERTIFY THAT THE CORNER LOCATION SHOWN ON THIS RECORD WAS DETERMINED BY ME OR UNDER MY DIRECTION AND CONTROL AND THAT THIS U. S. PUBLIC LAND SURVEY MONUMENT RECORD IS CORRECT AND COMPLETE TO THE BEST OF MY KNOWLEDGE AND BELIEF.

William C. Jung 12/2/05
Signature Date

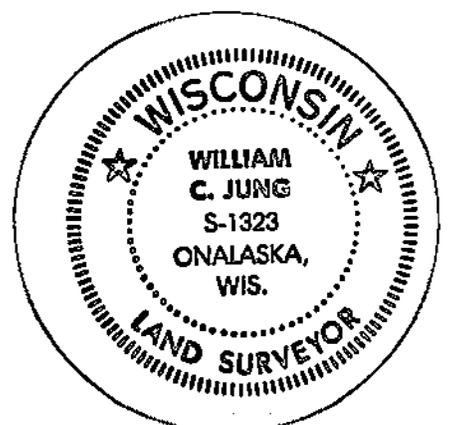


Seal

U. S. PUBLIC LAND SURVEY MONUMENT RECORD

SECTION 30 T 17 N, R 8 W, TOWN OF Hamilton

LA CROSSE COUNTY

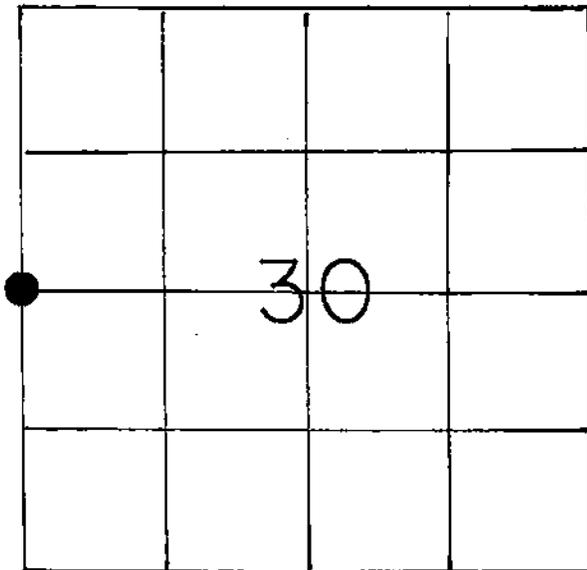

LOCATION OF LANDMARK

Crew: William Jung
 Perry Dahl
 10/3/85

WISCONSIN COORDINATE SYSTEM
North
East
Theta Angle
Horiz. Order
Vert. Order
TYPE OF LANDMARK
Berntsen
BEARINGS ARE REFERENCED TO
Magnetic as per 1979 Sims survey

Describe any record evidence, monument evidence, testimonial evidence or any other material evidence you considered and whether the monument was found or restored through acceptance of an obliterated evidence location.


I found a P.K. nail set by Bob Chalsma at the corner. He set the nail on line and equidistant between the section corners. I removed the P.K. nail and set a Berntsen marker.

Describe or show any material discrepancy between the location of the restored corner and that of the corner previously restored or reestablished.

None known.


RECORD OF DURABLE WITNESS MONUMENTS

NO	DESCRIPTION	BEARING	DISTANCE
1	Set a 1 1/8" iron pipe, flush	N87°E	21.00
2	NW Corner of shed	-----	56.60
3	SW Corner of shed	-----	47.17
4			

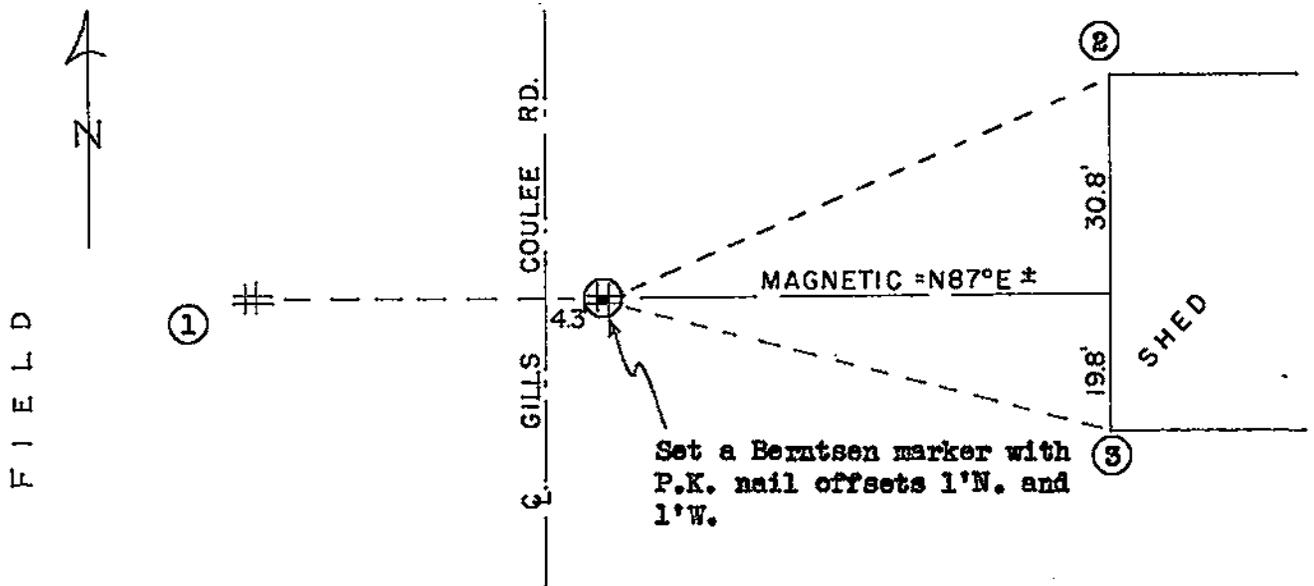

PLAN VIEW DRAWING OF REFERENCE TIES

MAP SHOWING DISTANCE AND DIRECTION TO OTHER PUBLIC LAND SURVEY CORNERS USED FOR REESTABLISHING THE CORNER

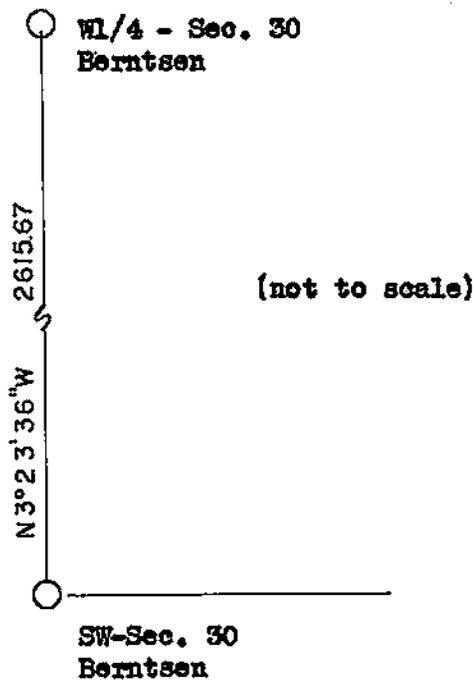

I, William C. Jung, Deputy County Surveyor,
 HEREBY CERTIFY THAT THE CORNER LOCATION SHOWN ON THIS RECORD
 WAS DETERMINED BY ME OR UNDER MY DIRECTION AND CONTROL AND
 THAT THIS U. S. PUBLIC LAND SURVEY MONUMENT RECORD IS CORRECT
 AND COMPLETE TO THE BEST OF MY KNOWLEDGE AND BELIEF.

William C. Jung 10/9/85
 Signature Date

