


21806310020

U. S. PUBLIC LAND SURVEY MONUMENT RECORD

SECTION 6 T 17 N, R 6 W, TOWN OF HAMILTON
 LA CROSSE COUNTY

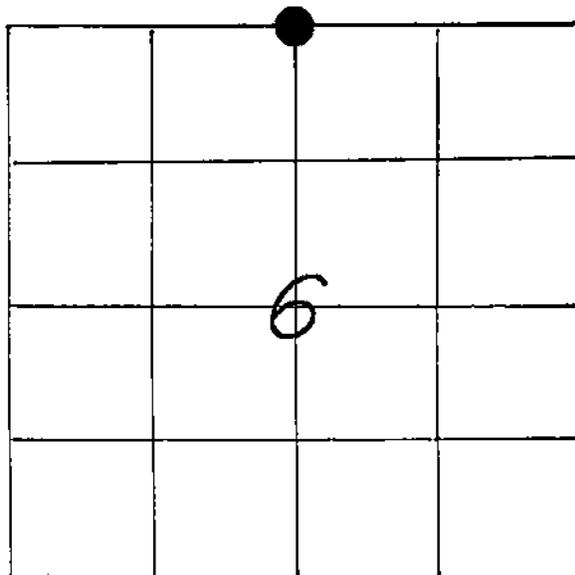

WISCONSIN COORDINATE SYSTEM

North

East

Theta Angle

Horiz. Order

Vert. Order

TYPE OF LANDMARK

3/4" x 24" IRON BAR WITH ALUMINUM CAP

BEARINGS ARE REFERENCED TO

ASSUMED NORTH.

LOCATION OF LANDMARK

CREW: WILLIAM C. JUNG
 PETER F. FOLLANSBEE
 DATE: 12/02/1998

Describe any record evidence, monument evidence, testimonial evidence or any other material evidence you considered and whether the monument was found or restored through acceptance of an obliterated evidence location.


I set this corner "as per law" by single proportionate measurement. This computed location had been used as the corner position in previous survey work.

Describe or show any material discrepancy between the location of the restored corner and that of the corner previously restored or reestablished.

NONE KNOWN.


RECORD OF DURABLE WITNESS MONUMENTS

NO	DESCRIPTION	MAGNETIC	
		BEARING	DISTANCE
1	SET A NAIL IN THE S.-SIDE 4-1/2" OAK	N 75° W	32.29 FT.
2	SET A PK. NAIL IN THE S.W.-SIDE 4" OAK	N 48° W	45.38 FT.
3	SET A NAIL IN THE S.W.-SIDE 12" MAPLE	N 40° W	16.75 FT.
4	SET A NAIL IN THE S.E.-SIDE OF A DOUBLE BOX ELDER	N 28° E	SL. = 53.10'

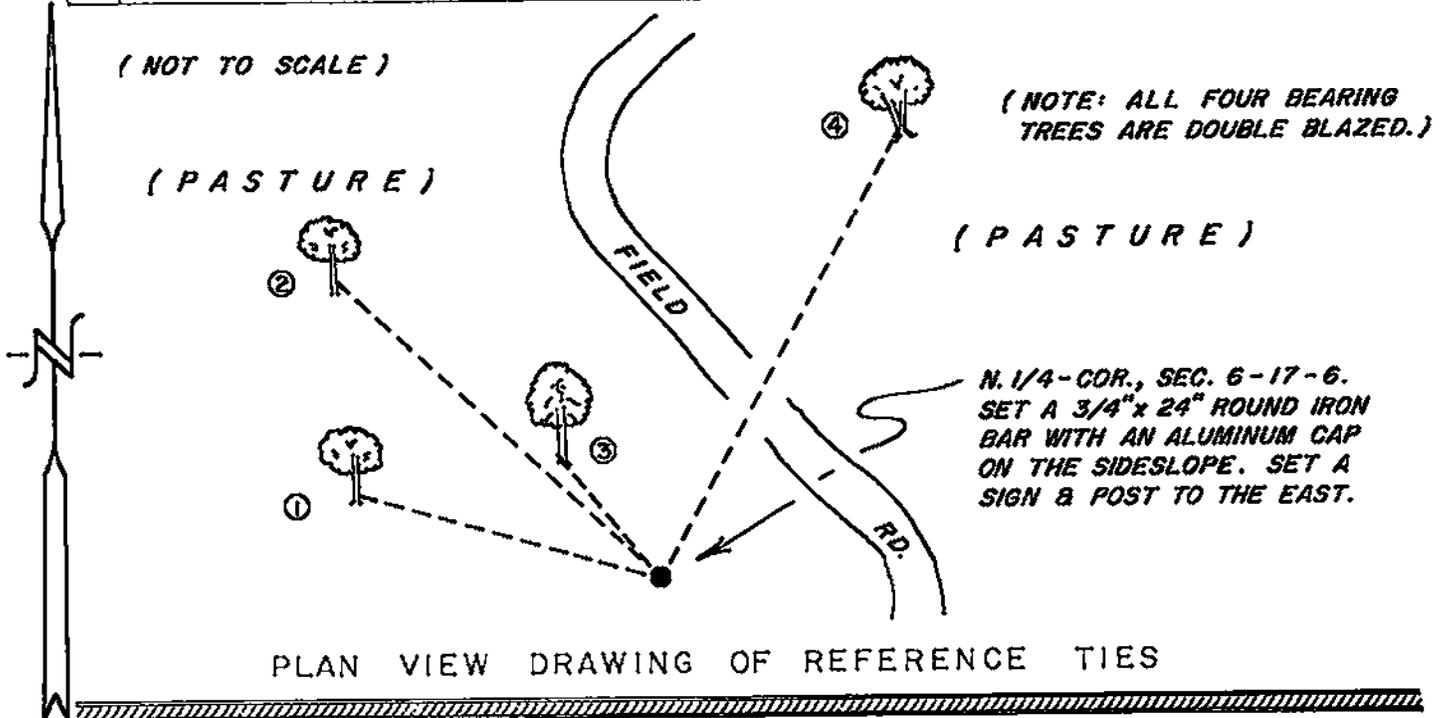

MAP SHOWING DISTANCE AND DIRECTION TO OTHER PUBLIC LAND SURVEY CORNERS USED FOR REESTABLISHING THE CORNER

(not to scale)

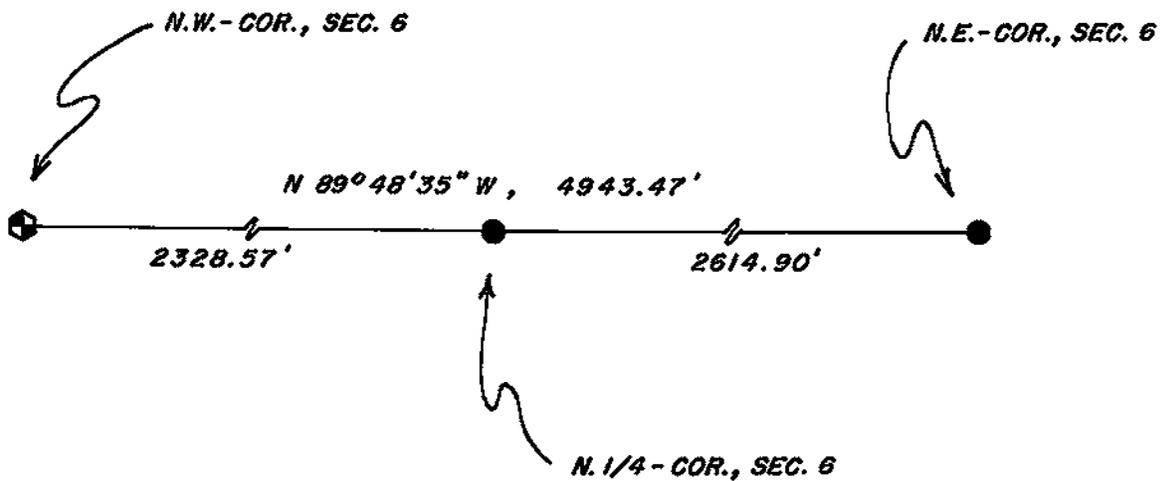

I, WILLIAM C. JUNG, COUNTY SURVEYOR
HEREBY CERTIFY THAT THE CORNER LOCATION SHOWN ON THIS RECORD WAS DETERMINED BY ME OR UNDER MY DIRECTION AND CONTROL AND THAT THIS U. S. PUBLIC LAND SURVEY MONUMENT RECORD IS CORRECT AND COMPLETE TO THE BEST OF MY KNOWLEDGE AND BELIEF.

William C. Jung 12/31/98
Signature Date



Seal