


U. S. PUBLIC LAND SURVEY MONUMENT RECORD

SECTION 5 T 17 N, R 6 W, TOWN OF HAMILTON

LA CROSSE COUNTY

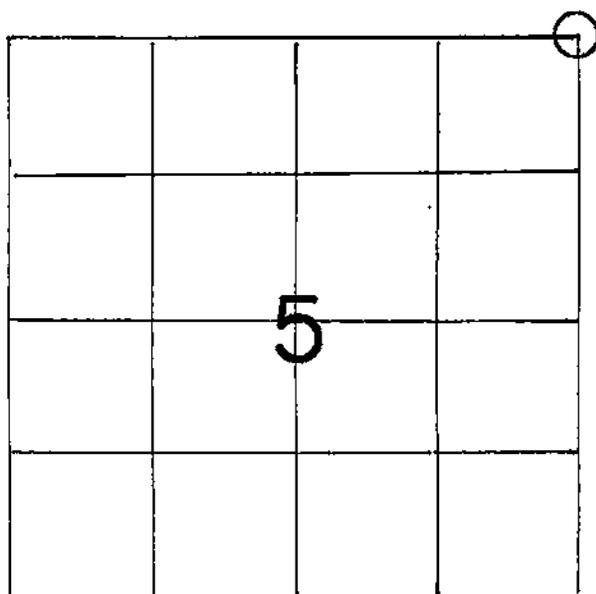

WISCONSIN COORDINATE SYSTEM

North

East

Theta Angle

Horiz. Order

Vert. Order

TYPE OF LANDMARK

EXISTING 1-1/4" IRON PIPE

BEARINGS ARE REFERENCED TO

LOCATION OF LANDMARK

CREW: WILLIAM C. JUNG

PETER F. FOLLANSBEE

DATE: 11/17/1998

Describe any record evidence, monument evidence, testimonial evidence or any other material evidence you considered and whether the monument was found or restored through acceptance of an obliterated evidence location.


I found a 1 1/4" iron pipe at the old occupied corner and accepted it as the best available evidence of the original government corner position. This pipe had been used in previous survey work. There is also a 1 1/2" drill bit (?), up 15", 4" to the East of the pipe.

Describe or show any material discrepancy between the location of the restored corner and that of the corner previously restored or reestablished.

None known.

RECORD OF DURABLE WITNESS MONUMENTS
MAGNETIC

NO	DESCRIPTION	BEARING	DISTANCE
1	SET A NAIL IN THE S.E.-SIDE 9-1/2" CHERRY	S 29° W	53.22 FT.
2	SET A NAIL IN THE S.E.-SIDE 11" ELM	S 35° W	14.43 FT.
3	SET A NAIL IN THE W.-SIDE 28" WHITE OAK	N 03° E	7.43 FT.
4	SET A NAIL IN THE S.E.-SIDE 5" BASSWOOD	N. 'EASTERLY ±	27.61 FT.

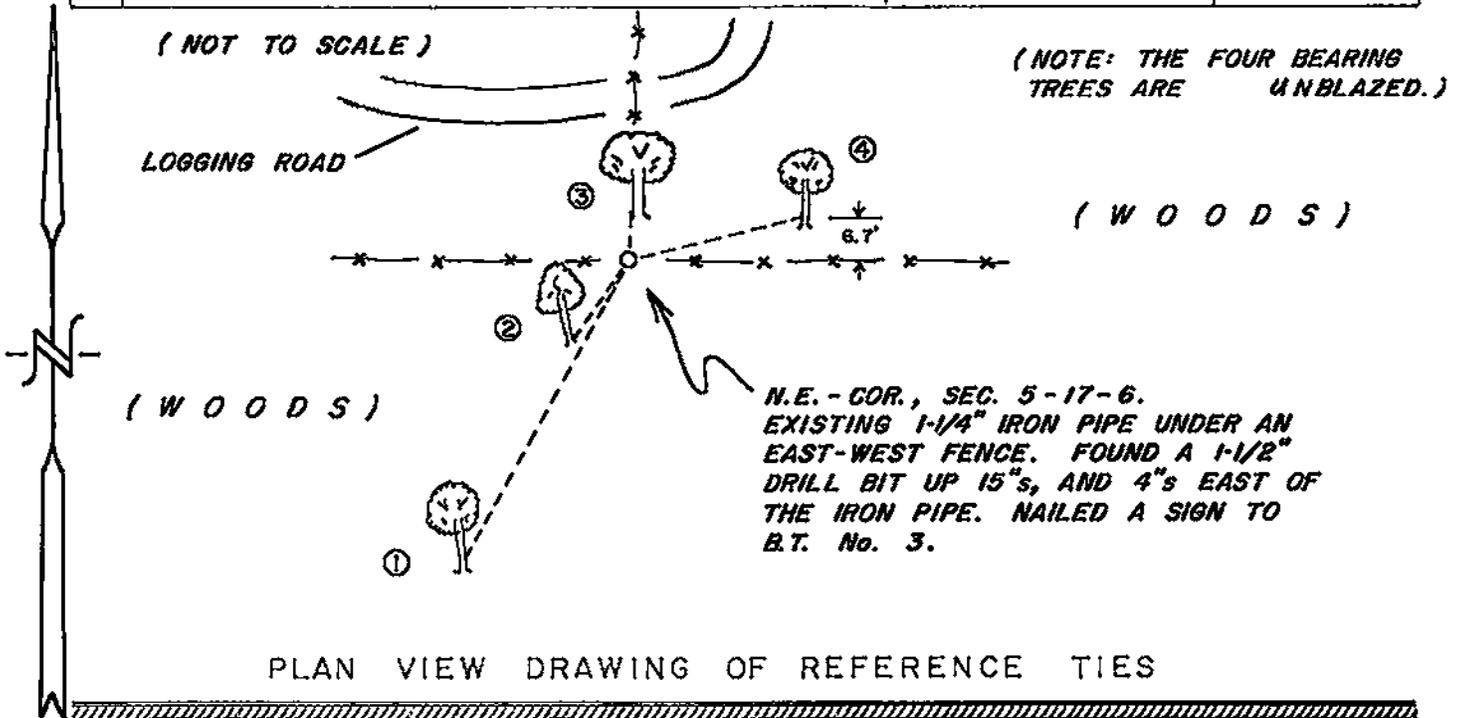


MAP SHOWING DISTANCE AND DIRECTION TO OTHER PUBLIC LAND SURVEY CORNERS USED FOR REESTABLISHING THE CORNER

No section measurements were made by me at this time. The location of this corner was confirmed by others.

I, WILLIAM C. JUNG, COUNTY SURVEYOR
HEREBY CERTIFY THAT THE CORNER LOCATION SHOWN ON THIS RECORD WAS DETERMINED BY ME OR UNDER MY DIRECTION AND CONTROL AND THAT THIS U. S. PUBLIC LAND SURVEY MONUMENT RECORD IS CORRECT AND COMPLETE TO THE BEST OF MY KNOWLEDGE AND BELIEF.

William C. Jung
Signature

1/4/99
Date

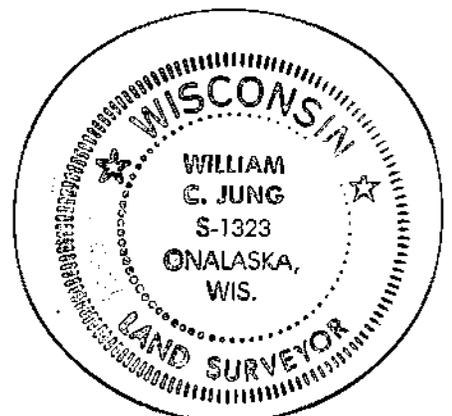

Seal