


U. S. PUBLIC LAND SURVEY MONUMENT RECORD

SECTION 5 T 17 N, R 6 W, TOWN OF HAMILTON

LA CROSSE COUNTY

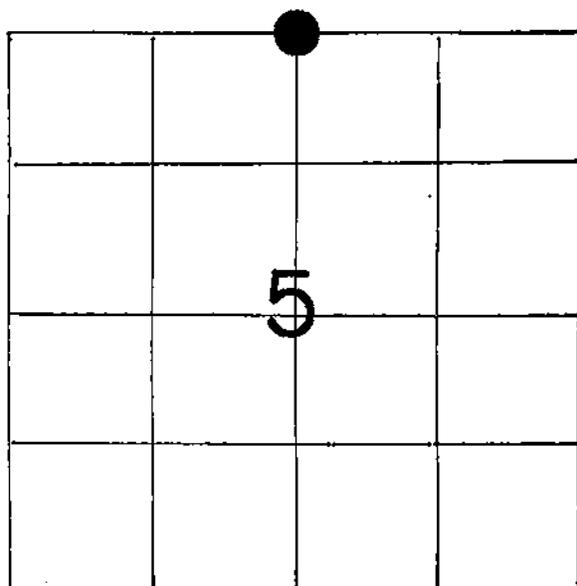

WISCONSIN COORDINATE SYSTEM
North
East
Theta Angle
Horiz. Order
Vert. Order
TYPE OF LANDMARK
<i>3/4" x 30" IRON BAR WITH AN ALUMINUM CAP</i>
BEARINGS ARE REFERENCED TO
<i>ASSUMED NORTH.</i>

LOCATION OF LANDMARK

CREW: WILLIAM C. JUNG
PETER F. FOLLANSBEE
DATE: 11/17/1998

Describe any record evidence, monument evidence, testimonial evidence or any other material evidence you considered and whether the monument was found or restored through acceptance of an obliterated evidence location.

I accepted the occupied corner as the best available evidence of the original government corner position. This location had been used in previous survey work. The corner was monumented with a 3/4"x30" round iron bar with a cap with a 1/2"x27" round iron bar set 0.12 feet to the Northeast.


Describe or show any material discrepancy between the location of the restored corner and that of the corner previously restored or reestablished.

None known.

RECORD OF DURABLE WITNESS MONUMENTS


MAGNETIC

NO	DESCRIPTION	BEARING	DISTANCE
1	SET A NAIL IN THE S.E.-SIDE 18" OAK	S 85° W	26.61 FT.
2	SET A NAIL IN THE S.E.-SIDE 15" OAK	S 69° W	45.66 FT.
3	SET A NAIL IN THE N.W.-SIDE 12" OAK	S 55° W	39.37 FT.
4	SET A NAIL IN THE N.E.-SIDE 12" ASH	S 41° E	45.20 FT.

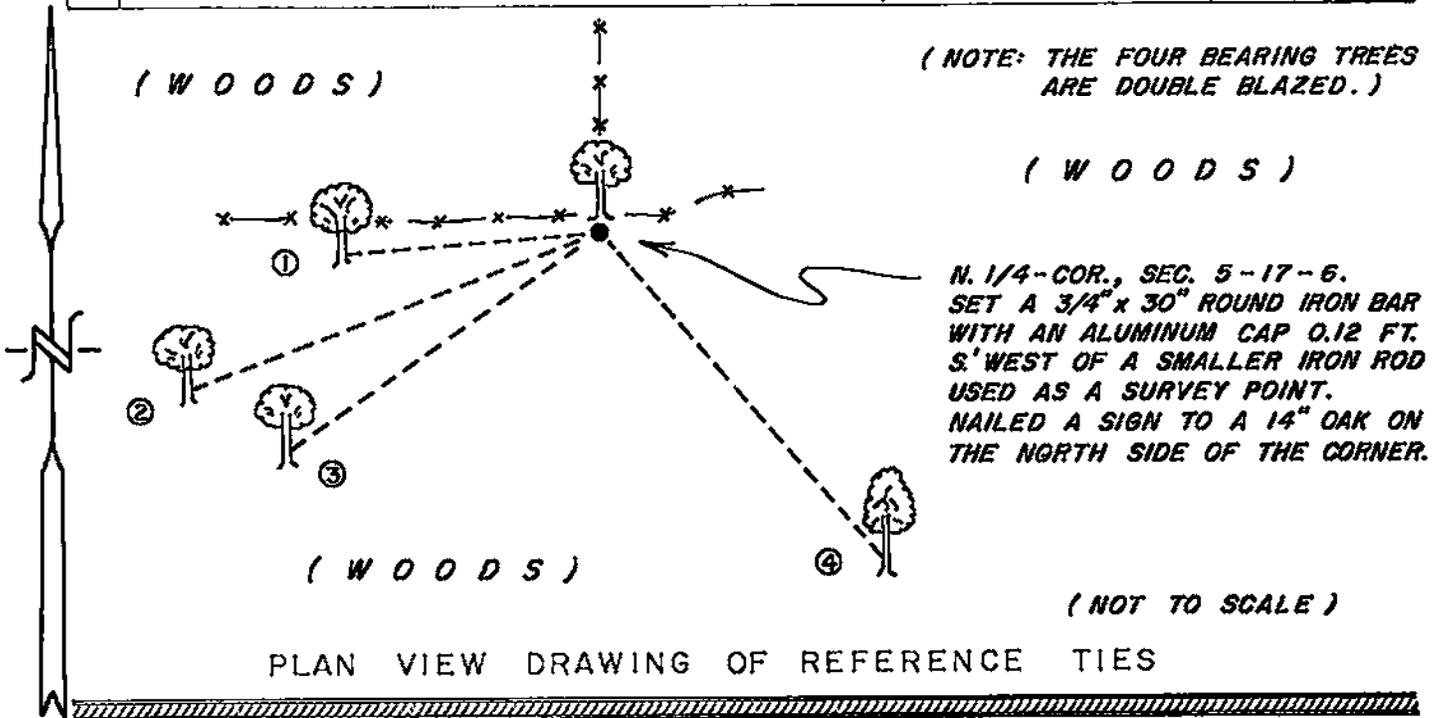


MAP SHOWING DISTANCE AND DIRECTION TO OTHER PUBLIC LAND SURVEY CORNERS USED FOR REESTABLISHING THE CORNER

(not to scale)

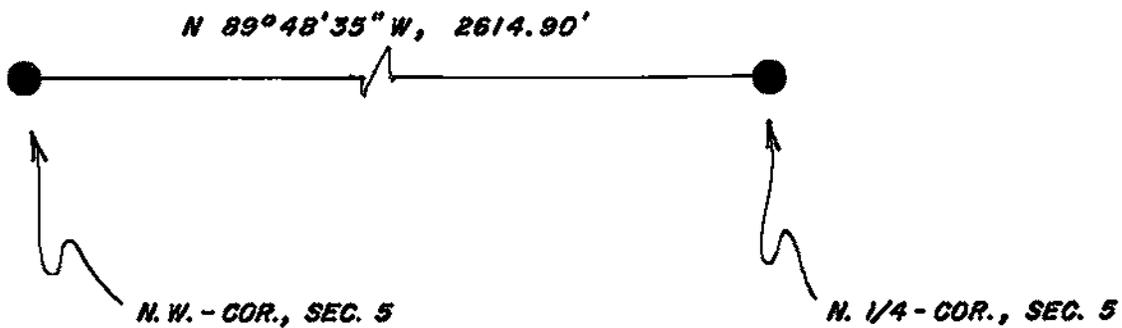

I, WILLIAM C. JUNG, COUNTY SURVEYOR
 HEREBY CERTIFY THAT THE CORNER LOCATION SHOWN ON THIS RECORD
 WAS DETERMINED BY ME OR UNDER MY DIRECTION AND CONTROL AND
 THAT THIS U. S. PUBLIC LAND SURVEY MONUMENT RECORD IS CORRECT
 AND COMPLETE TO THE BEST OF MY KNOWLEDGE AND BELIEF.

William C. Jung 1/4/99
 Signature Date

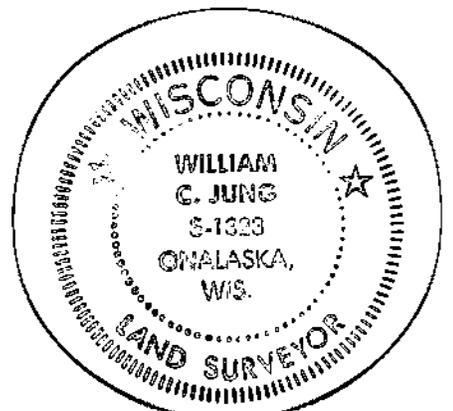

Seal