


U. S. PUBLIC LAND SURVEY MONUMENT RECORD

SECTION 3 T 17 N, R 6 W, TOWN OF HAMILTON  
LA CROSSE COUNTY

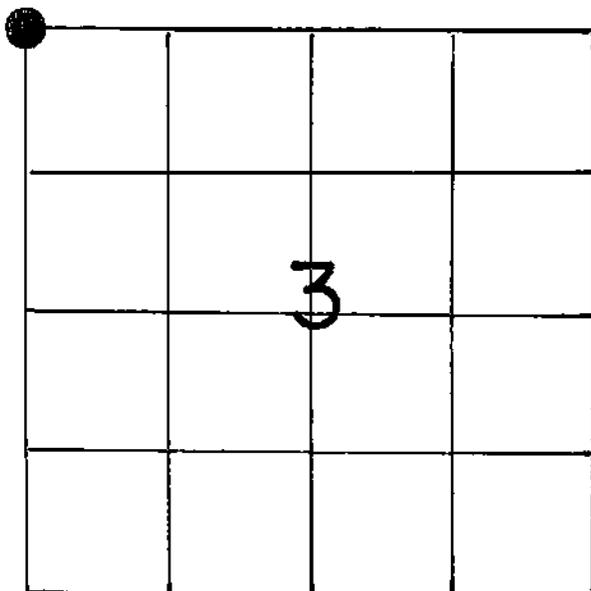

LOCATION OF LANDMARK

Crew: William C. Jung

Peter F. Follansbee

Date: 12/10/91

Describe any record evidence, monument evidence, testimonial evidence or any other material evidence you considered and whether the monument was found or restored through acceptance of an obliterated evidence location.

I found an iron pipe at the old occupied fence corner and accepted it as the best available evidence of the original government corner position. The pipe had been used as the corner in previous survey work. A Berntsen top was set in the existing pipe.


Describe or show any material discrepancy between the location of the restored corner and that of the corner previously restored or reestablished.

None known.

WISCONSIN COORDINATE SYSTEM
North
East
Theta Angle
Horiz. Order
Vert. Order
TYPE OF LANDMARK
Berntsen top in an iron pipe
BEARINGS ARE REFERENCED TO
Assumed


RECORD OF DURABLE WITNESS MONUMENTS

NO	DESCRIPTION	BEARING	DISTANCE
1	P.K. nail in double blazed 8" white oak	-----	17.25
2	" 18" oak	-----	17.40
3	" 10" oak	-----	17.83
4	P.K. nail in 4" unblazed hickory with sign	-----	1.37

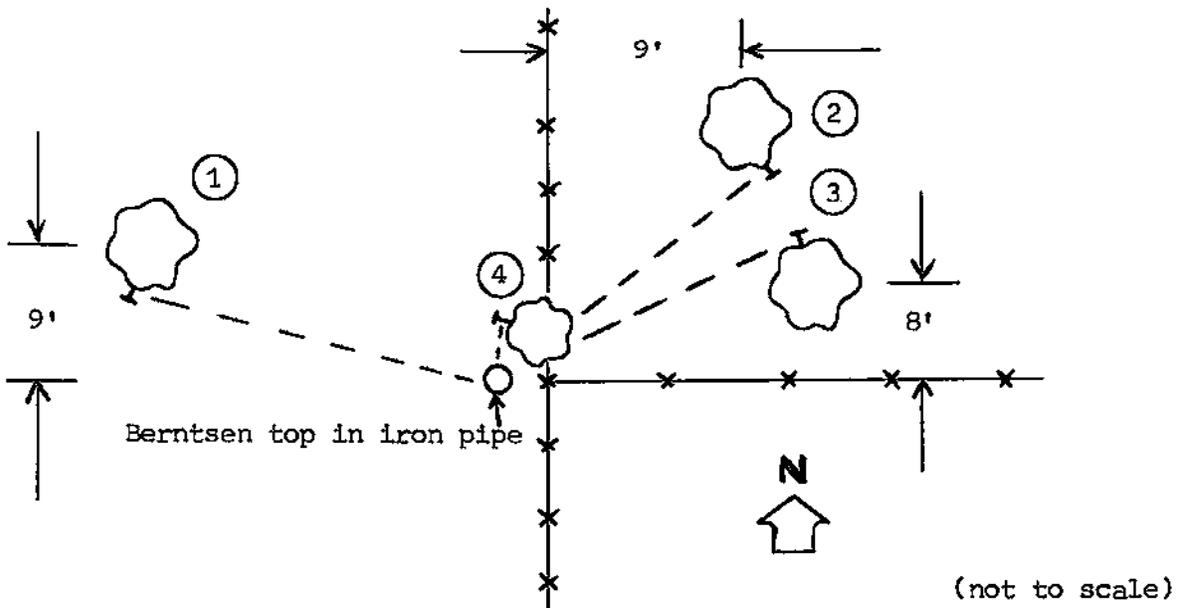

PLAN VIEW DRAWING OF REFERENCE TIES

MAP SHOWING DISTANCE AND DIRECTION TO OTHER PUBLIC LAND SURVEY CORNERS USED FOR REESTABLISHING THE CORNER

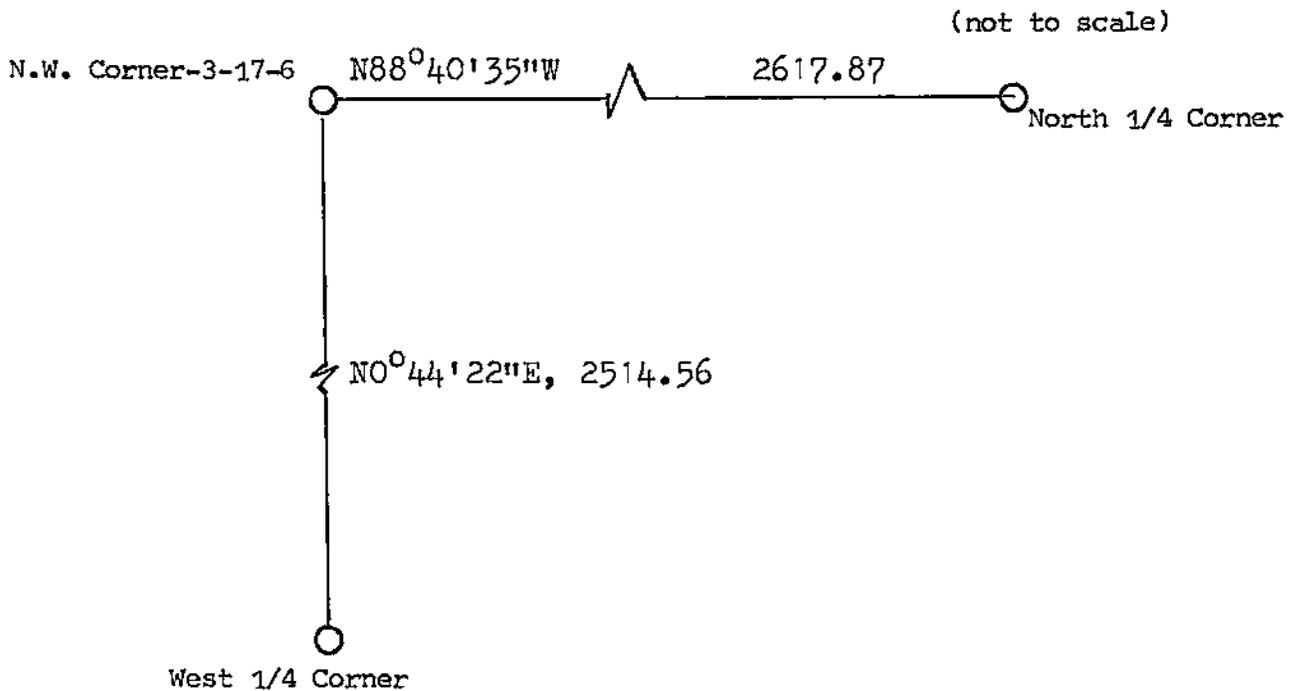

I, William C. Jung, Deputy County Surveyor,  
 HEREBY CERTIFY THAT THE CORNER LOCATION SHOWN ON THIS RECORD  
 WAS DETERMINED BY ME OR UNDER MY DIRECTION AND CONTROL AND  
 THAT THIS U. S. PUBLIC LAND SURVEY MONUMENT RECORD IS CORRECT  
 AND COMPLETE TO THE BEST OF MY KNOWLEDGE AND BELIEF.

William C. Jung December 20, 1991  
 Signature Date



Seal