


21806340000

U. S. PUBLIC LAND SURVEY MONUMENT RECORD

SECTION 3 T 17 N, R 6 W, TOWN OF Hamilton/Farmington
LA CROSSE COUNTY

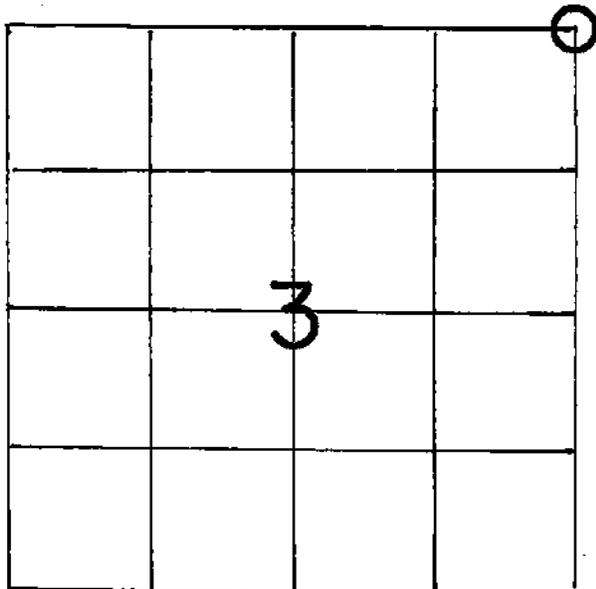

LOCATION OF LANDMARK

Crew: WILLIAM C. JUNG
PETER F. FOLLANSBEE

Date: 1/13/1992

Describe any record evidence, monument evidence, testimonial evidence or any other material evidence you considered and whether the monument was found or restored through acceptance of an obliterated evidence location.

I accepted the old occupied corner location as the best available evidence of the original government corner position and monumented it with an iron pipe.


Describe or show any material discrepancy between the location of the restored corner and that of the corner previously restored or reestablished.

None known

WISCONSIN COORDINATE SYSTEM
North
East
Theta Angle
Horiz. Order
Vert. Order
TYPE OF LANDMARK
Set 1" Iron Pipe
BEARINGS ARE REFERENCED TO
Assumed North


RECORD OF DURABLE WITNESS MONUMENTS

NO	DESCRIPTION	BEARING	DISTANCE
1	Set P.K. Nail in S.-side 15" Oak w/sign	Southwest ±	17.61 Ft.
2	Set P.K. Nail in W.-side 10" Birch	North ±	14.57 Ft.
3	Set P.K. Nail in S.E.-side double W. Oak	Northeast ±	34.01 Ft.
4	Set P.K. Nail in S.-side 6" Oak	East +	17.73 Ft.
5	Set P.K. Nail in N.E.-side 4" Hickory	Southeast ±	19.78 Ft.

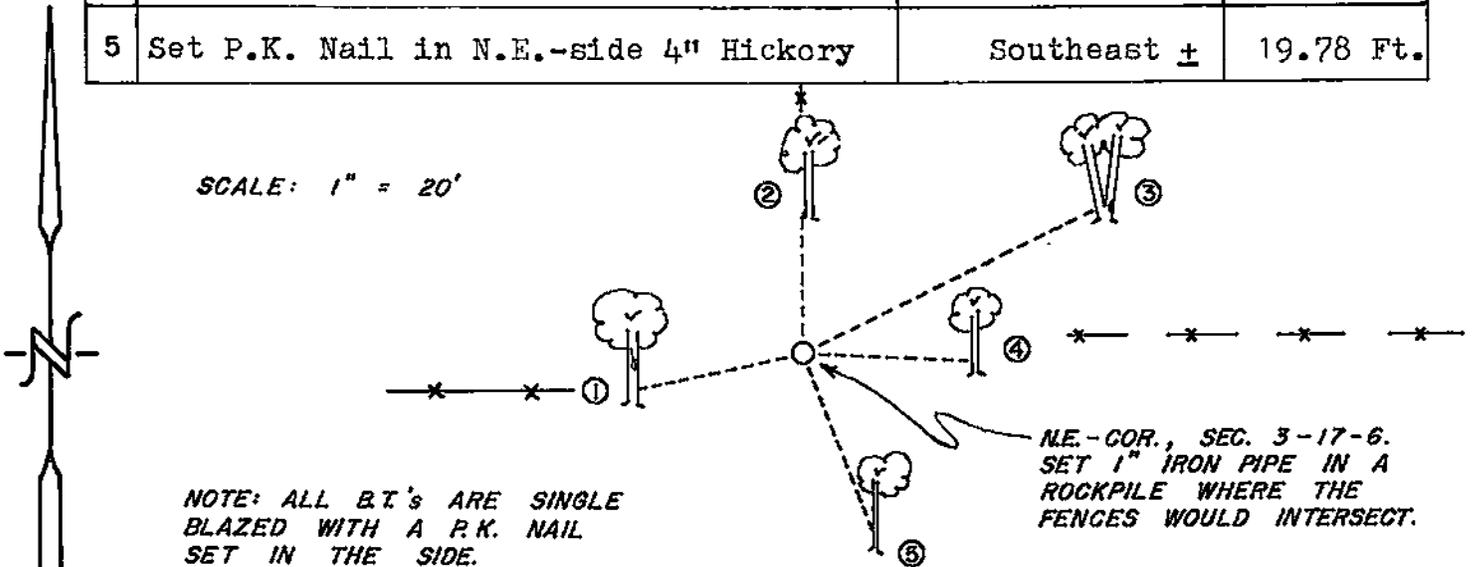

PLAN VIEW DRAWING OF REFERENCE TIES

MAP SHOWING DISTANCE AND DIRECTION TO OTHER PUBLIC LAND SURVEY CORNERS USED FOR REESTABLISHING THE CORNER

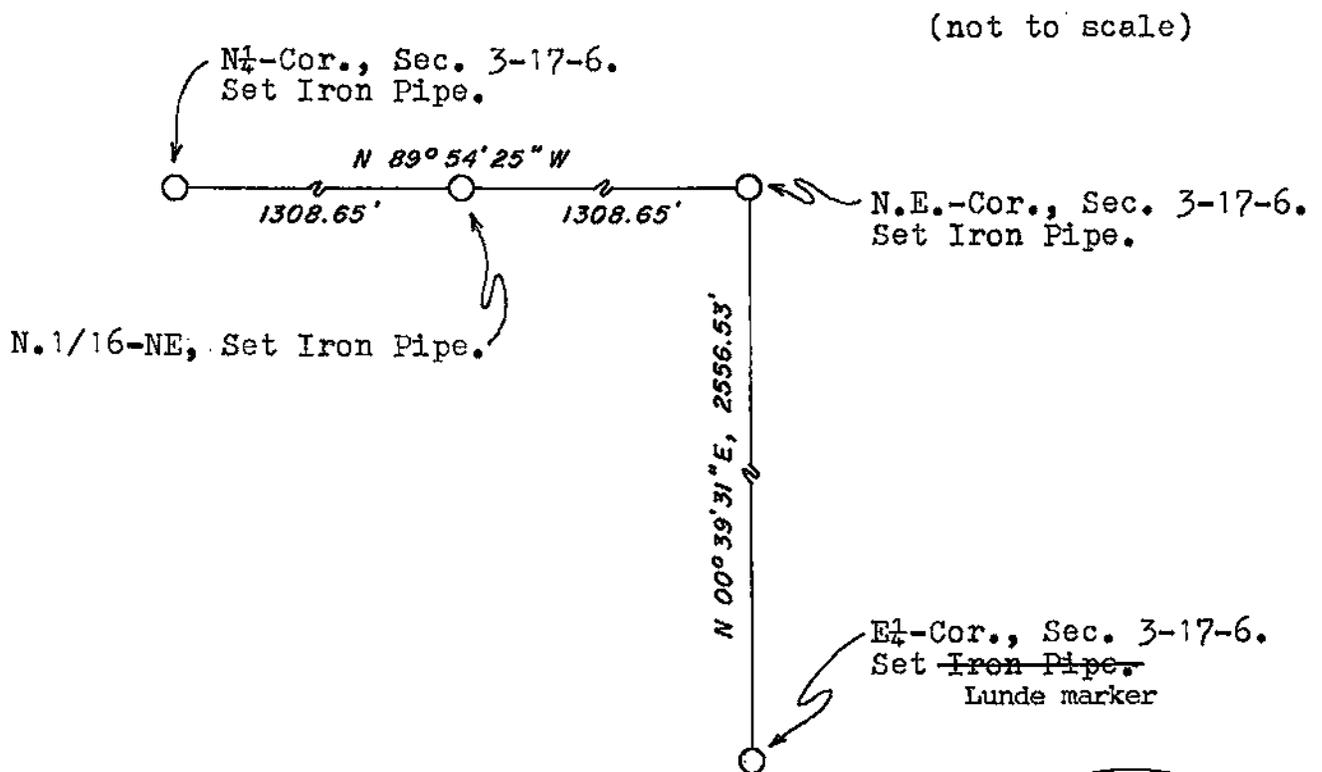


I, William C. Jung, Deputy County Surveyor
 HEREBY CERTIFY THAT THE CORNER LOCATION SHOWN ON THIS RECORD
 WAS DETERMINED BY ME OR UNDER MY DIRECTION AND CONTROL AND
 THAT THIS U. S. PUBLIC LAND SURVEY MONUMENT RECORD IS CORRECT
 AND COMPLETE TO THE BEST OF MY KNOWLEDGE AND BELIEF.

William C. Jung
 Signature

March 11, 1992
 Date

Revised: June 2, 1992

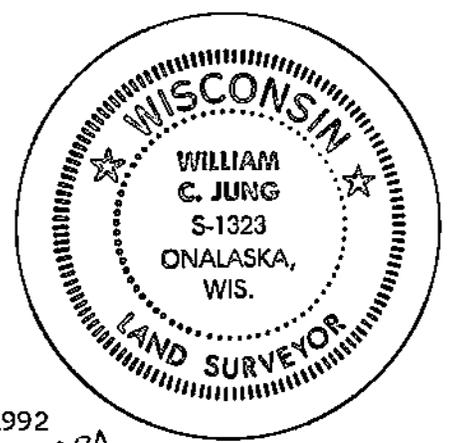

wcj

Seal