


## U. S. PUBLIC LAND SURVEY MONUMENT RECORD

SECTION 1 T 17 N, R 6 W, TOWN OF HAMILTON  
LA CROSSE COUNTY

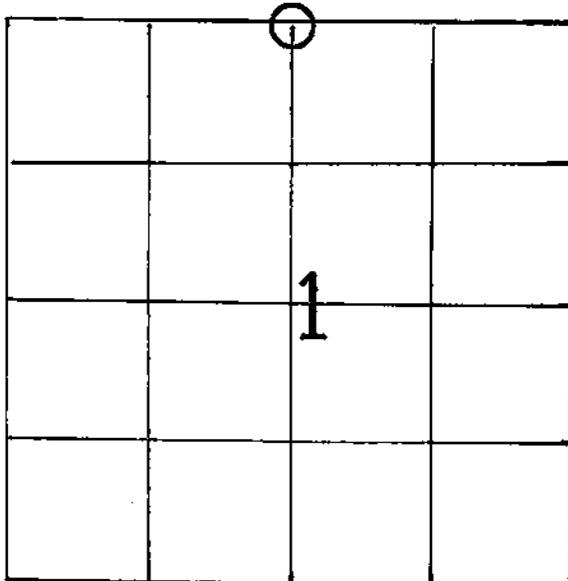

LOCATION OF LANDMARK

## WISCONSIN COORDINATE SYSTEM

North

East

Theta Angle

Horiz. Order

Vert. Order

## TYPE OF LANDMARK

~~1" Iron Pipe.~~ Lunde marker

BEARINGS ARE REFERENCED TO  
True North.

Crew: WILLIAM C. JUNG  
PETER F. FOLLANSBEE

Date: 2/01/1995

Crew: William C. Jung  
Peter F. Follansbee

Date: 5/2/95

Describe any record evidence, monument evidence, testimonial evidence or any other material evidence you considered and whether the monument was found or restored through acceptance of an obliterated evidence location.

I found an old tie post at this corner with three strands of wire going to the West and two strands to the East. I inspected this fence, especially to the West a few hundred feet, and found it to be very old and well maintained. It also had woven wire. I accepted the old occupied corner as the best available evidence of the original government corner position and monumented it with a pipe. It splits the mile within 3.24 feet. It is off line 39.4 feet, more than I like, but the\*\*\*\*\* Describe or show any material discrepancy between the location of the restored corner and that of the corner previously restored or reestablished.

None Known.

\*\*\*\*\* 1/4 corner at the North of Section 2 is off line 21.9 feet and the 1/4 corner at the North of Section 3 is off line 28.1 feet. This is not the first time that I have found such kinks in a Town line in this county.


I also searched further South but found nothing.

5/2/95 - We replaced the iron pipe with a brass capped Lunde marker and buried a wine bottle with it. A sign and post were also set. The Lunde was mounded with rocks.

RECORD OF DURABLE WITNESS MONUMENTS

MAGNETIC


NO	DESCRIPTION	BEARING	DISTANCE
1	Set P.K. Nail in NE-side 18" White Oak	N 50° W	36.74 Ft.
2	Set P.K. Nail in W.-side 8" Hickory	N 14° W	27.79 Ft.
3	Set P.K. Nail in NW-side 8" Hickory	N 54° E	28.83 Ft.
4	Set P.K. Nail in SE-side 7" Hickory	Southwesterly ±	18.82 Ft.

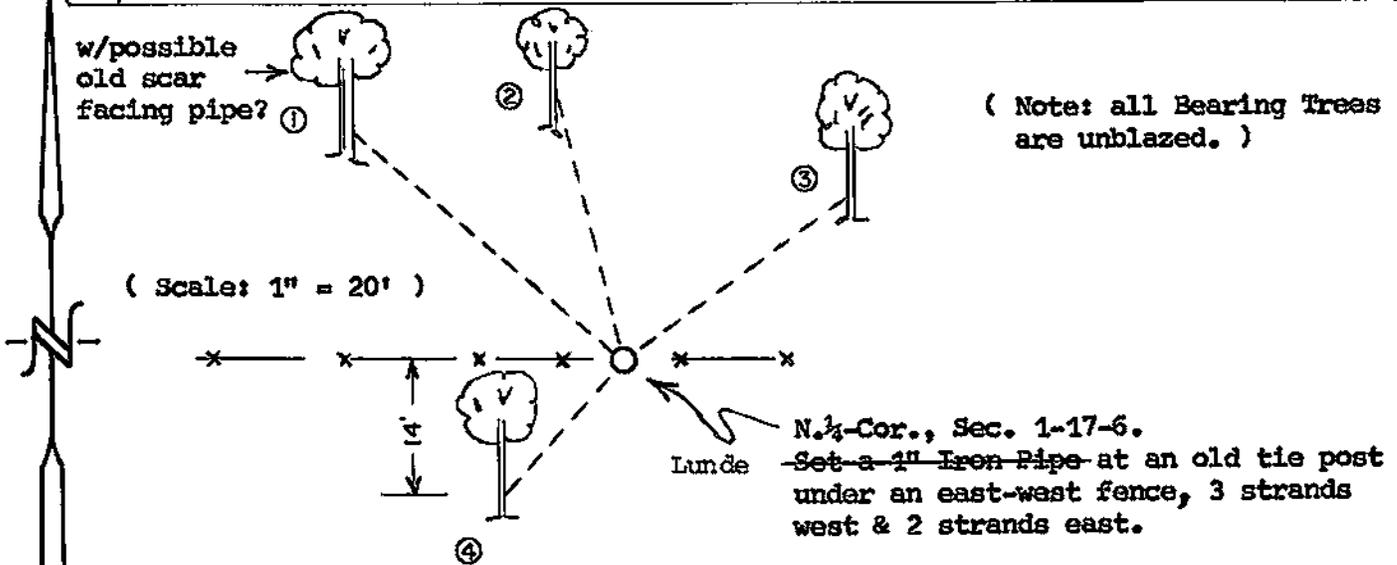

PLAN VIEW DRAWING OF REFERENCE TIES


MAP SHOWING DISTANCE AND DIRECTION TO OTHER PUBLIC LAND SURVEY CORNERS USED FOR REESTABLISHING THE CORNER

(not to scale)

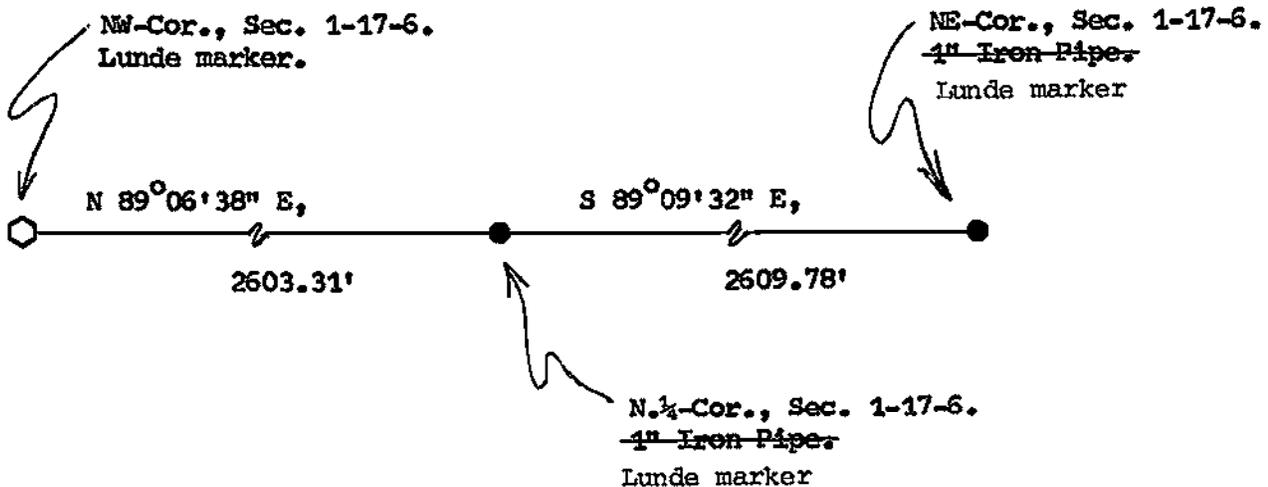

I, William C. Jung, County Surveyor  
HEREBY CERTIFY THAT THE CORNER LOCATION SHOWN ON THIS RECORD WAS DETERMINED BY ME OR UNDER MY DIRECTION AND CONTROL AND THAT THIS U. S. PUBLIC LAND SURVEY MONUMENT RECORD IS CORRECT AND COMPLETE TO THE BEST OF MY KNOWLEDGE AND BELIEF.

William C. Jung 3/2/95  
Signature Date

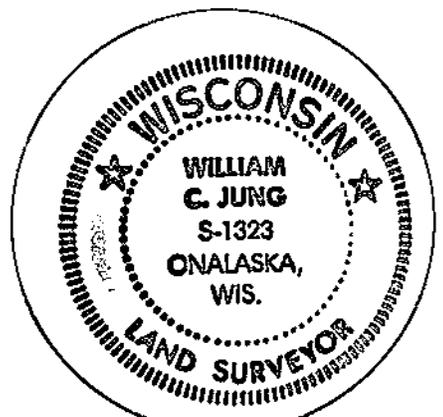

Seal

Revised: 2/2/96 *wcj*