


U. S. PUBLIC LAND SURVEY MONUMENT RECORD

SECTION 12 T 17 N, R 7 W, TOWN OF ONALASKA

LA CROSSE COUNTY

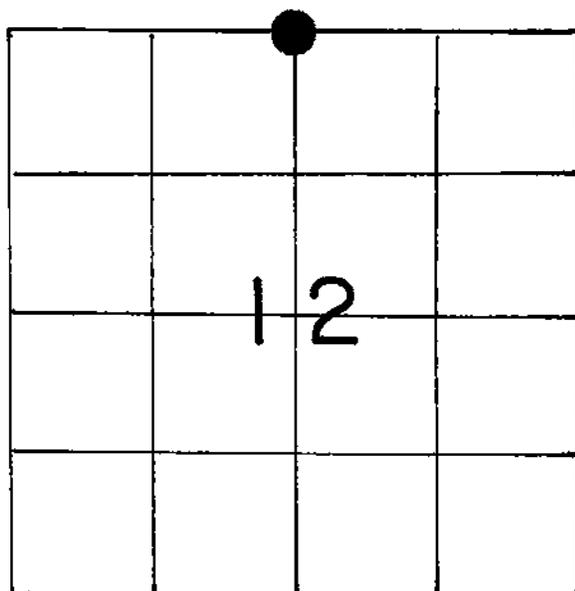

LOCATION OF LANDMARK

Crew: WILLIAM C. JUNG
 PETER F. FOLLANSBEE
 Date: 6/05/1995

WISCONSIN COORDINATE SYSTEM

North

East

Theta Angle

Horiz. Order

Vert. Order

TYPE OF LANDMARK

Brass Cap Lunde Marker.

BEARINGS ARE REFERENCED TO

Describe any record evidence, monument evidence, testimonial evidence or any other material evidence you considered and whether the monument was found or restored through acceptance of an obliterated evidence location.


At an earlier date I set an iron pipe at ^{the} occupied corner. I accepted this position as the best available evidence of the original government corner location. The distance West appears to be short about a "two pole chain". Solberg and Scholze also agree with this location. I replaced my pipe with a brass capped Lunde marker.

Describe or show any material discrepancy between the location of the restored corner and that of the corner previously restored or reestablished.

None Known.


RECORD OF DURABLE WITNESS MONUMENTS

NO	DESCRIPTION	MAGNETIC	
		BEARING	DISTANCE
1	Set P.K. Nail in S.-side 7" Hickory	N 86° W	46.95 Ft.
2	Set P.K. Nail in SW-side 28" Oak	N 11° W	19.92 Ft.
3	Set P.K. Nail in N.-side 9" Elm	S 78° E	20.05 Ft.
4	Set P.K. Nail in SW-side 6½" Hickory	S 45° E	11.35 Ft.

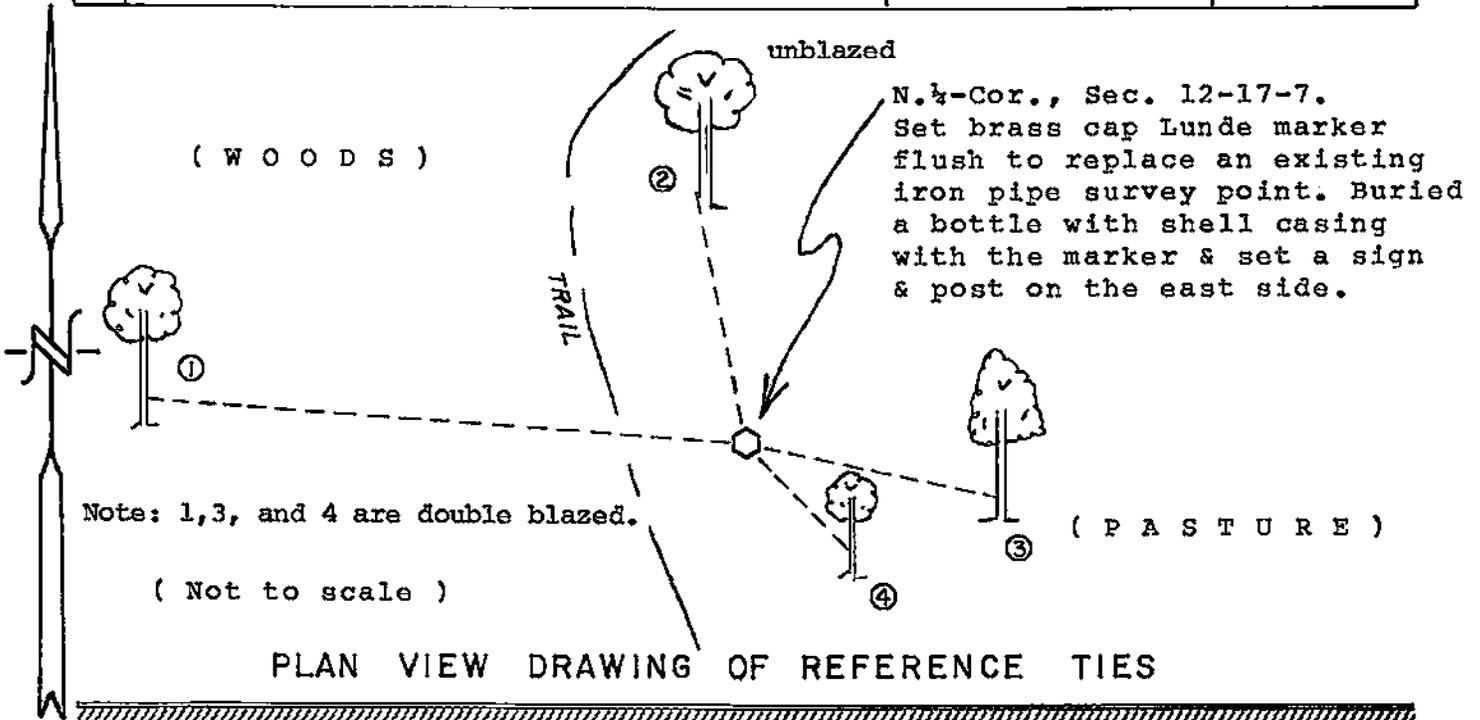


MAP SHOWING DISTANCE AND DIRECTION TO OTHER PUBLIC LAND SURVEY CORNERS USED FOR REESTABLISHING THE CORNER

(Not to scale)

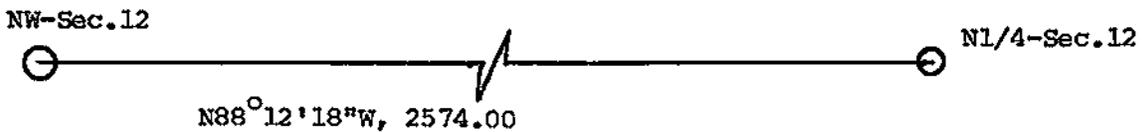

I, William C. Jung, County Surveyor
 HEREBY CERTIFY THAT THE CORNER LOCATION SHOWN ON THIS RECORD
 WAS DETERMINED BY ME OR UNDER MY DIRECTION AND CONTROL AND
 THAT THIS U. S. PUBLIC LAND SURVEY MONUMENT RECORD IS CORRECT
 AND COMPLETE TO THE BEST OF MY KNOWLEDGE AND BELIEF.

William C. Jung 8/17/95
 Signature Date

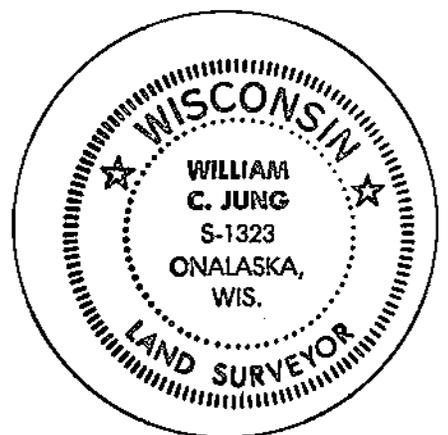

Seal