


21707020000

## U. S. PUBLIC LAND SURVEY MONUMENT RECORD

SECTION 11 T 17 N, R 7 W, TOWN OF ONALASKA

LA CROSSE COUNTY

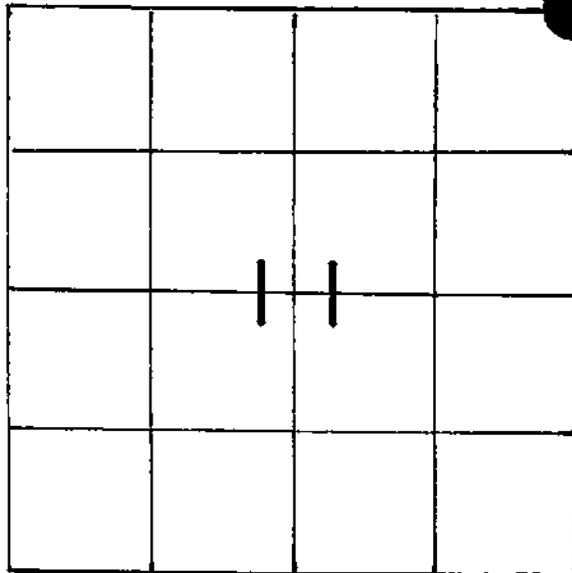

LOCATION OF LANDMARK

Crew: WILLIAM C. JUNG

Crew: William C. Jung  
Peter F. Follansbee\*\*\*\*\* 1<sup>3/4</sup>" iron pipe over the  
Lunde marker

Date: 5/05/1993

Date: 8/11/00

Describe any record evidence, monument evidence, testimonial evidence or any other material evidence you considered and whether the monument was found or restored through acceptance of an obliterated evidence location.

I set this corner at a computed location that best fits the evidence that I found in the four cardinal directions. I set a brass capped Lunde marker at the corner. I interviewed several landowners about this corner. Some had always believed that "it was in the field". Two other old residents that could have helped me are now deceased or the victim of a stroke. I searched the field for a marker but found none.

Describe or show any material discrepancy between the location of the restored corner and that of the corner previously restored or reestablished.

12' South of the road centerline and 39.5' to the North of my Lunde is an iron bar used as the corner in several previous surveys. I disagree with this iron bar. This bar lines up with a fence far to the West of the road and North of the creek. This was not the section fence but apparently a pasture fence built North of the creek to keep the stock in. To have built the fence on the section line would have put it in the creek bottom. This would have been impractical. The iron bar was intended to fit the occupied corner but actually didn't.

## WISCONSIN COORDINATE SYSTEM

North

East

Theta Angle

Horiz. Order

Vert. Order

## TYPE OF LANDMARK


Set brass cap Lunde marker. \*\*\*\*\*

## BEARINGS ARE REFERENCED TO

True North


RECORD OF DURABLE WITNESS MONUMENTS  
MAGNETIC

NO	DESCRIPTION	BEARING	DISTANCE
1	Set 1/2" x 16 1/2" Rebar west of sign post	Northwesterly $\pm$	38.41 Ft.
2	Center of steel utility sign post	N 38° E	40.72 Ft.
3	Set P.K. Nail in SW-side 37" Burr Oak(unblazed)	S 89° E	Sl.= 166.57'
4	Distance to NW-Corner of School Building	S 84° E	Sl.= 220.17'

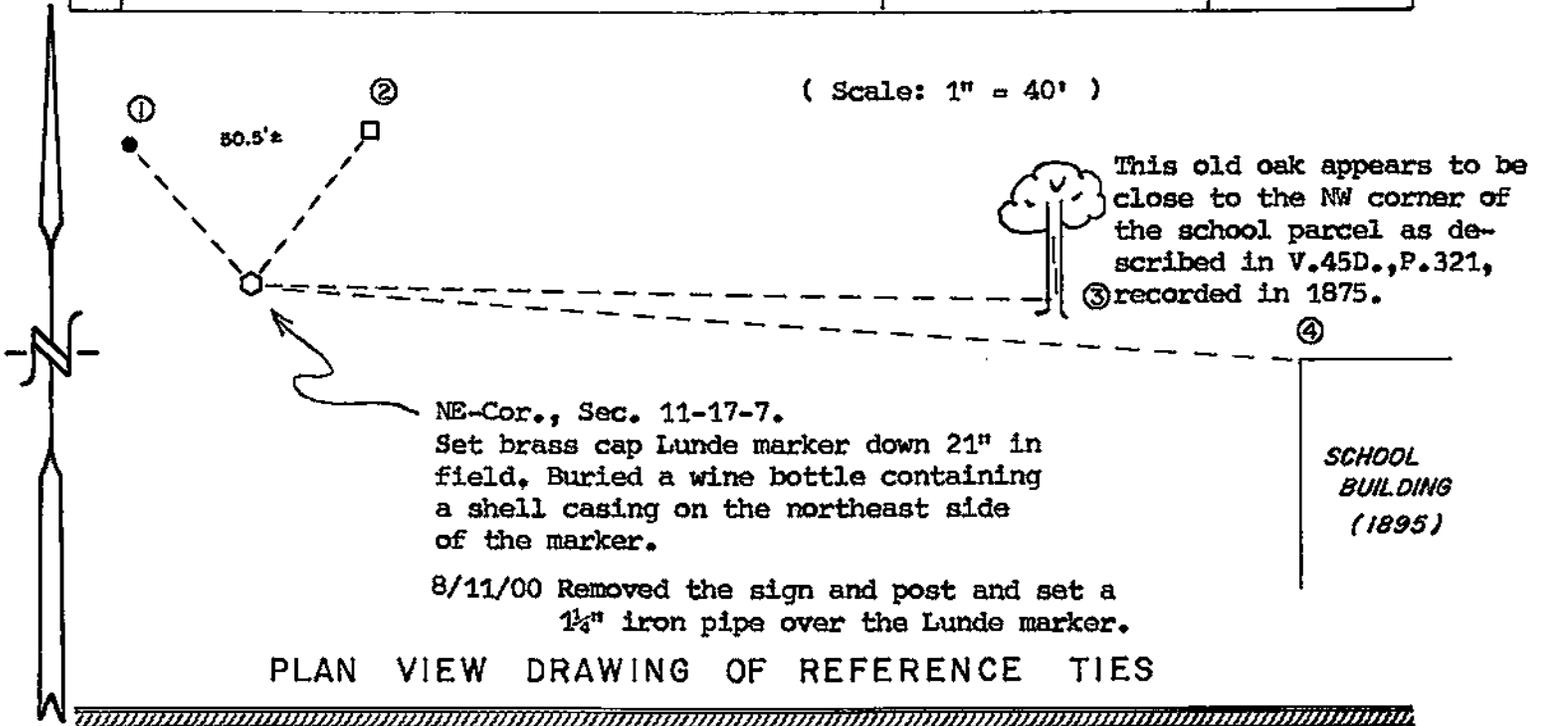

MAP SHOWING DISTANCE AND DIRECTION TO OTHER PUBLIC LAND SURVEY CORNERS USED FOR REESTABLISHING THE CORNER


(not to scale)

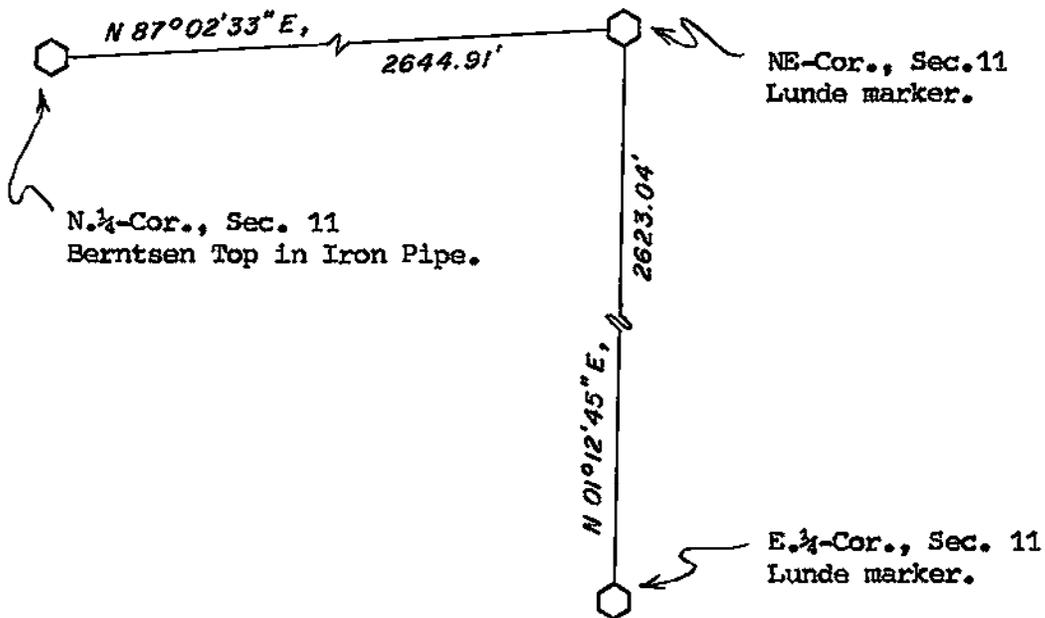

I, William C. Jung, County Surveyor  
HEREBY CERTIFY THAT THE CORNER LOCATION SHOWN ON THIS RECORD WAS DETERMINED BY ME OR UNDER MY DIRECTION AND CONTROL AND THAT THIS U. S. PUBLIC LAND SURVEY MONUMENT RECORD IS CORRECT AND COMPLETE TO THE BEST OF MY KNOWLEDGE AND BELIEF.

William C. Jung      2/11/94  
Signature      Date

Revised: 4/30/02 *wey*

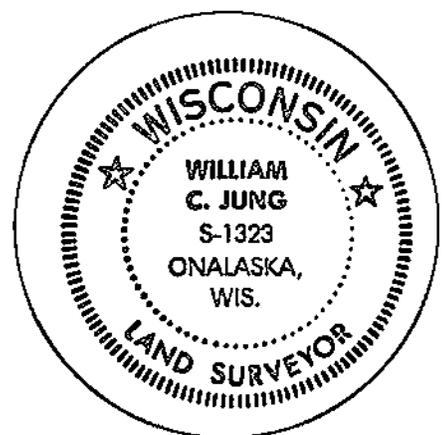

Seal