


21707020020

U. S. PUBLIC LAND SURVEY MONUMENT RECORD

SECTION 11 T 17 N, R 7 W, TOWN OF ONALASKA

LA CROSSE COUNTY

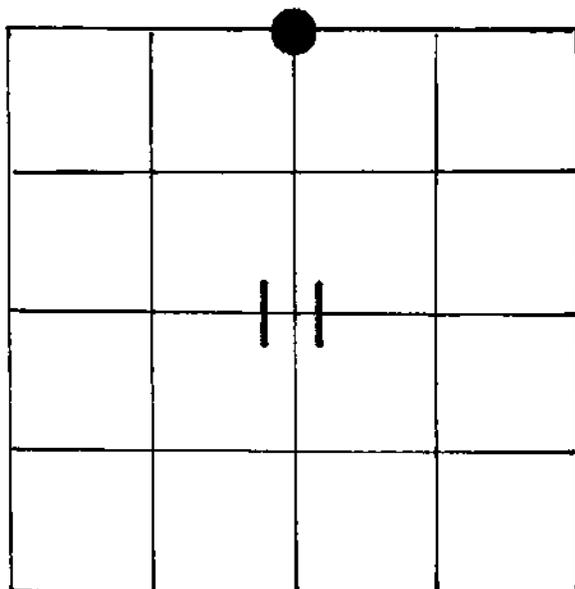

LOCATION OF LANDMARK

Crew: WILLIAM C. JUNG

Date: 5/05/1993

Describe any record evidence, monument evidence, testimonial evidence or any other material evidence you considered and whether the monument was found or restored through acceptance of an obliterated evidence location.

I found an existing iron pipe East of a North-South tie post and accepted it as the best available evidence of the original government corner position. The pipe had been used as the corner in many previous surveys and fits very well the evidence found along the section line. I removed the existing pipe and replaced it with another with a Berntsen top.

Describe or show any material discrepancy between the location of the restored corner and that of the corner previously restored or reestablished.

None known.

WISCONSIN COORDINATE SYSTEM

North

East

Theta Angle

Horiz. Order

Vert. Order

TYPE OF LANDMARK

Set 1½" x 38" I.P. w/Berntsen Top.

BEARINGS ARE REFERENCED TO

True North

