


21707032000

U. S. PUBLIC LAND SURVEY MONUMENT RECORD

SECTION 3 T 17 N, R 7 W, TOWN OF Onalaska

LA CROSSE COUNTY

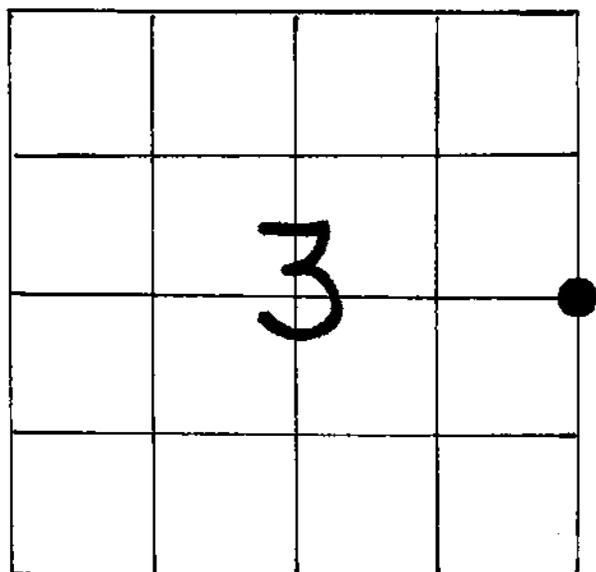

LOCATION OF LANDMARK

Crew: William C. Jung
Peter F. Follansbee

Date: 7/2/91

Describe any record evidence, monument evidence, testimonial evidence or any other material evidence you considered and whether the monument was found or restored through acceptance of an obliterated evidence location.

I found what I believe to be an original bearing tree to the Southeast and set the corner using this tree. The Lunde marker is set on a rock shelf and is 2' West of the fence. Buried near and around the marker is a liquor bottle with a shell casing, a mason jar, (2) very old bottle remnants, and white pottery pieces. The corner is up and mounded.

Describe or show any material discrepancy between the location of the restored corner and that of the corner previously restored or reestablished.

The fence corner, S1^oE, 67 feet, does not fit. I could not accept it.

WISCONSIN COORDINATE SYSTEM

North

East

Theta Angle

Horiz. Order

Vert. Order

TYPE OF LANDMARK

Brass capped Lunde marker

BEARINGS ARE REFERENCED TO

Assumed

