


21707040000

U. S. PUBLIC LAND SURVEY MONUMENT RECORD

SECTION 9 T 17 N, R 7 W, TOWN OF ONALASKA

LA CROSSE COUNTY

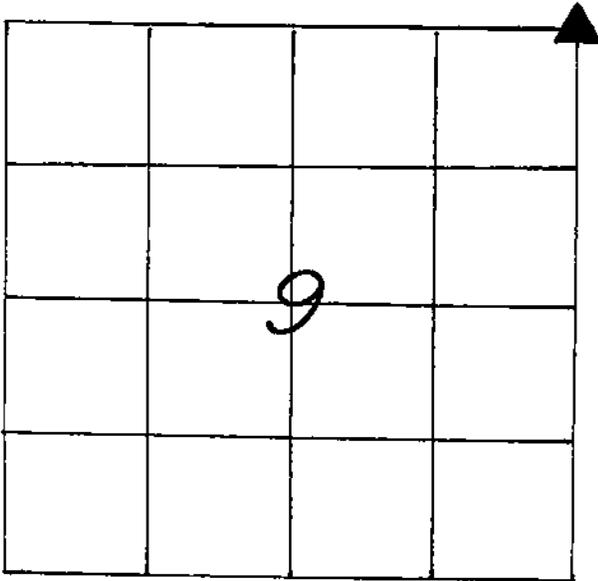

LOCATION OF LANDMARK

CREW: WILLIAM C. JUNG
 PETER F. FOLLANSBEE
 DATE: 9/27/2004

WISCONSIN COORDINATE SYSTEM	
North	720,537.441
East	1,649,789.234
Theta Angle	
Horiz. Order	
Vert. Order	
DATUM:	1983('91)
TYPE OF LANDMARK	
RAILROAD SPIKE IN PAVEMENT.	
BEARINGS ARE REFERENCED TO	
GRID NORTH AS PER SECTION DATA.	

Describe any record evidence, monument evidence, testimonial evidence or any other material evidence you considered and whether the monument was found or restored through acceptance of an obliterated evidence location.


The Berntsen monument that I set at this corner in 1985 was destroyed during this year's repaving project. I set a railroad spike at my old corner location. (See my 1985 tie sheet for the history on this corner.)

Describe or show any material discrepancy between the location of the restored corner and that of the corner previously restored or reestablished.

NONE KNOWN.


RECORD OF DURABLE WITNESS MONUMENTS

NO	DESCRIPTION	GRID BEARINGS	GROUND DIST.'s
		BEARING	DISTANCE
1	SET A 3/4"x30" IRON BAR WITH RED PLASTIC CAP	S 36°17'14" W	34.97 FT.
2	SET A 3/4"x30" IRON BAR WITH RED PLASTIC CAP	N 24°27'24" W	51.20 FT.
3	EX. GPS MARKER ("ONALASKA N.E." GPS)	S 89°28'24" E	36.94 FT.
4	EX. 3/4"x30" IRON BAR WITH RED PLASTIC CAP	S 07°23'31" E	201.32 FT.

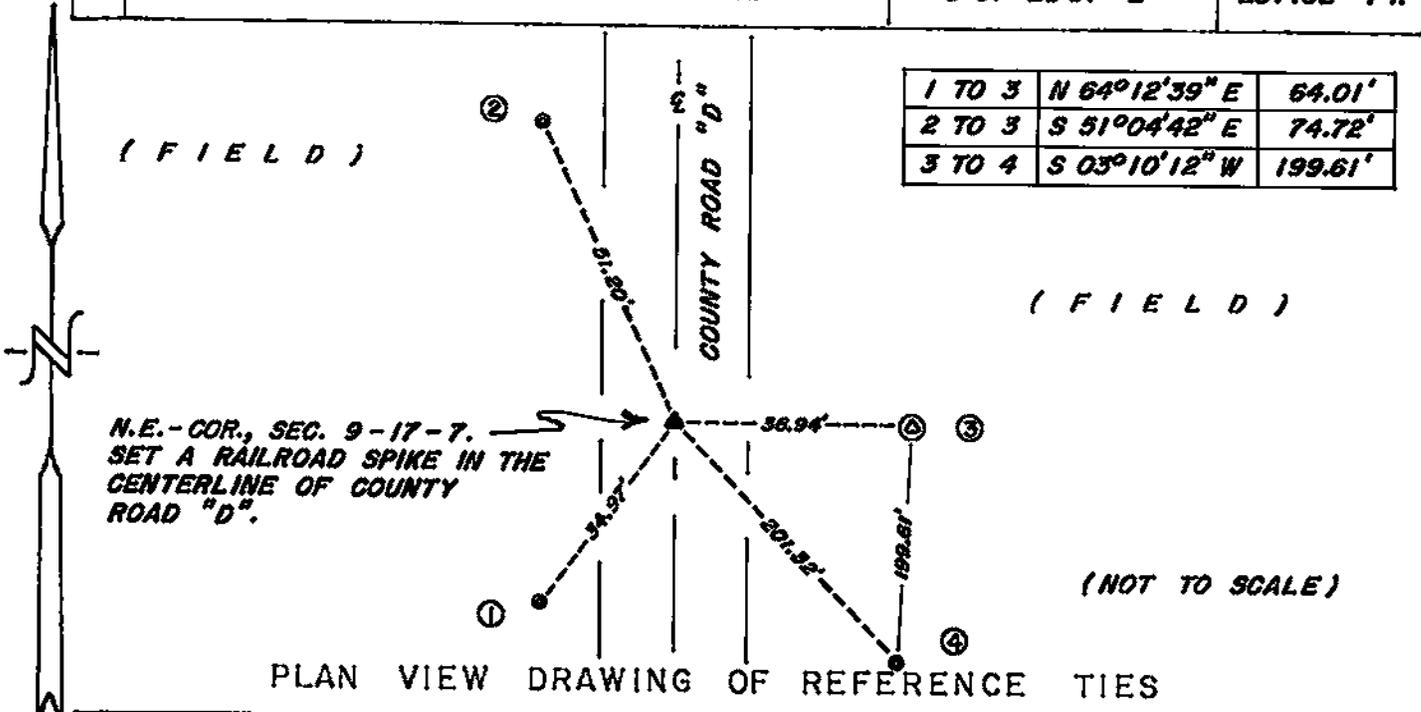

MAP SHOWING DISTANCE AND DIRECTION TO OTHER PUBLIC LAND SURVEY CORNERS USED FOR REESTABLISHING THE CORNER


(GRID BEARINGS AND DISTANCES)
 (GRID FACTOR: 0.999942987)
 (NOT TO SCALE)

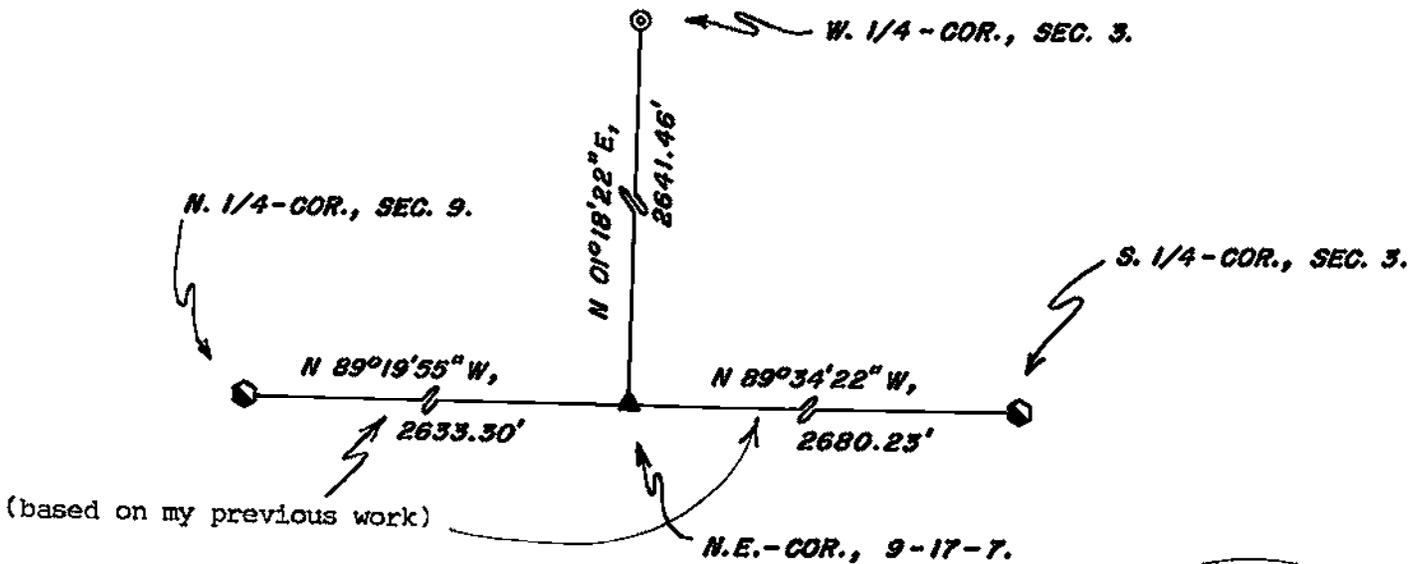

I, WILLIAM C. JUNG, COUNTY SURVEYOR
 HEREBY CERTIFY THAT THE CORNER LOCATION SHOWN ON THIS RECORD
 WAS DETERMINED BY ME OR UNDER MY DIRECTION AND CONTROL AND
 THAT THIS U. S. PUBLIC LAND SURVEY MONUMENT RECORD IS CORRECT
 AND COMPLETE TO THE BEST OF MY KNOWLEDGE AND BELIEF.

William C. Jung
 Signature

12/28/04
 Date

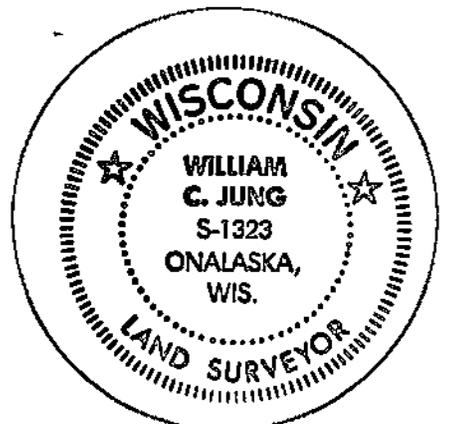


Seal

U. S. PUBLIC LAND SURVEY MONUMENT RECORD

SECTION 10 T 17 N, R 7 W, TOWN OF ONALASKA

LA CROSSE COUNTY

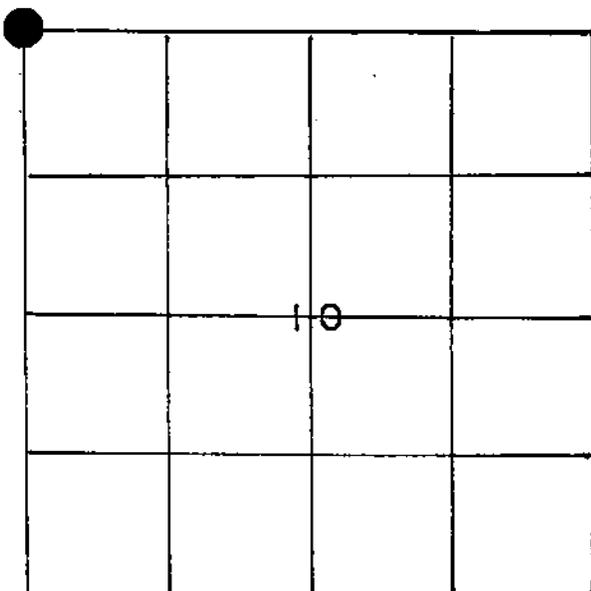

LOCATION OF LANDMARK

Crew: William Jung
 Perry Dahl
 3/28/85

WISCONSIN COORDINATE SYSTEM
North
East
Theta Angle
Horiz. Order
Vert. Order
TYPE OF LANDMARK
Berntsen Monument
BEARINGS ARE REFERENCED TO
Assumed

Describe any record evidence, monument evidence, testimonial evidence or any other material evidence you considered and whether the monument was found or restored through acceptance of an obliterated evidence location.


The old highway map shows this location as the corner. In August of 1982 Dick Berg shows a P.K. nail at the corner. I found a R.R. spike at the corner which agreed with Berg's location. After my field traversing and computations, I accepted this location as the best evidence of the original government corner and monumented it with a Berntsen top.

Describe or show any material discrepancy between the location of the restored corner and that of the corner previously restored or reestablished.

None known.

RECORD OF DURABLE WITNESS MONUMENTS


NO	DESCRIPTION	BEARING	DISTANCE
1	Existing 1½" iron pipe, up 2'	West ±	26.22
2	To center of steel telephone sign post	_____	55.4
3	To the center of a possible unrecorded bearing tree stump (has a scar?)	Magnetic=N24°E	72
4	Set a 1¼" iron pipe	East ±	36.56

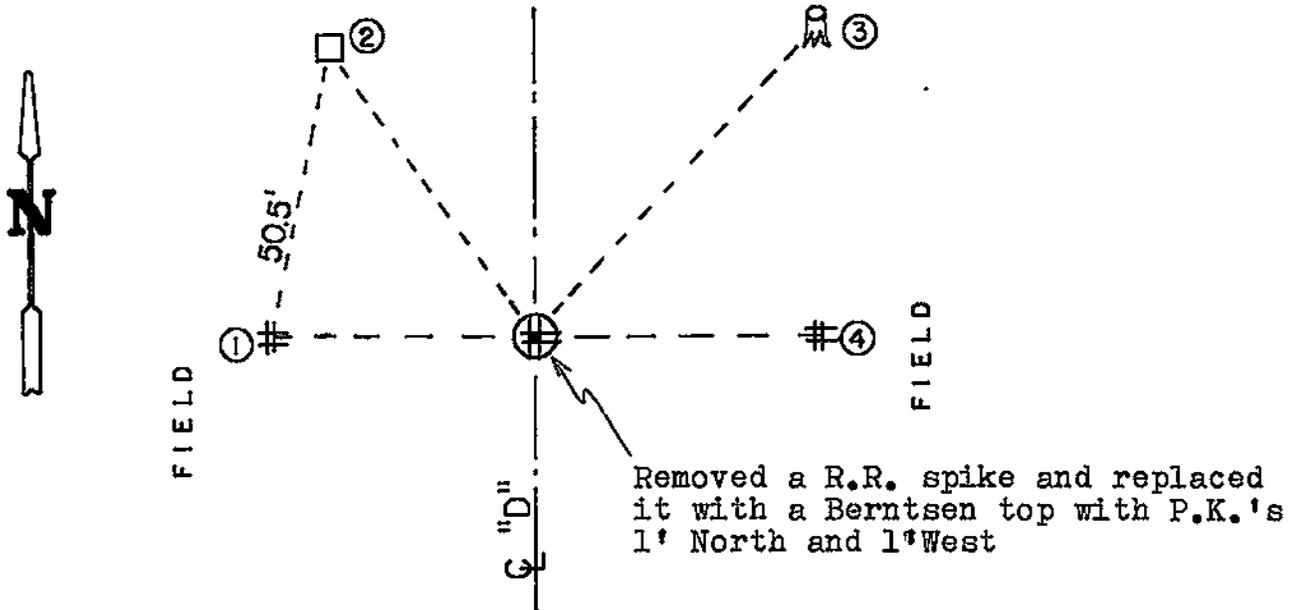

PLAN VIEW DRAWING OF REFERENCE TIES

MAP SHOWING DISTANCE AND DIRECTION TO OTHER PUBLIC LAND SURVEY CORNERS USED FOR REESTABLISHING THE CORNER

(Not to scale)

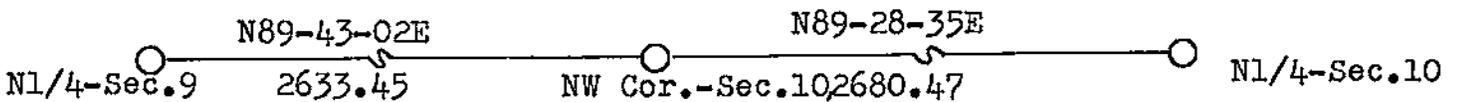

I, William C. Jung, Deputy County Surveyor,
 HEREBY CERTIFY THAT THE CORNER LOCATION SHOWN ON THIS RECORD
 WAS DETERMINED BY ME OR UNDER MY DIRECTION AND CONTROL AND
 THAT THIS U. S. PUBLIC LAND SURVEY MONUMENT RECORD IS CORRECT
 AND COMPLETE TO THE BEST OF MY KNOWLEDGE AND BELIEF.

William C. Jung 2/4/86
 Signature Date



Seal