


21707040020

U. S. PUBLIC LAND SURVEY MONUMENT RECORD

SECTION 9 T 17 N, R 7 W, TOWN OF ONALASKA

LA CROSSE COUNTY

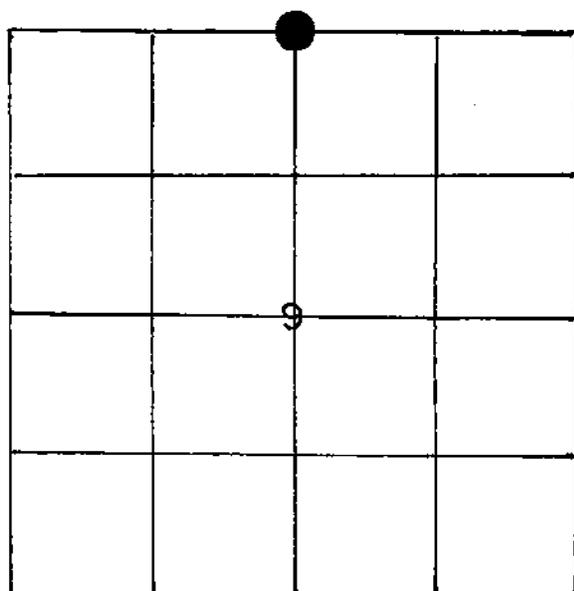

LOCATION OF LANDMARK

Crew: William Jung
Perry Dahl
4/1/85

WISCONSIN COORDINATE SYSTEM
North
East
Theta Angle
Horiz. Order
Vert. Order
TYPE OF LANDMARK
Berntsen monument
BEARINGS ARE REFERENCED TO
Assumed

Crew: William C. Jung
Peter F. Follansbee
4/25/91

Describe any record evidence, monument evidence, testimonial evidence or any other material evidence you considered and whether the monument was found or restored through acceptance of an obliterated evidence location.

I set this corner "by law", on line and equidistant between the section corners. I felt that the fence to the North was "wild".

Describe or show any material discrepancy between the location of the restored corner and that of the corner previously restored or reestablished.

None known.

