


21707042000

U. S. PUBLIC LAND SURVEY MONUMENT RECORD

SECTION 3 T 17 N, R 7 W, TOWN OF ONALASKA

LA CROSSE COUNTY

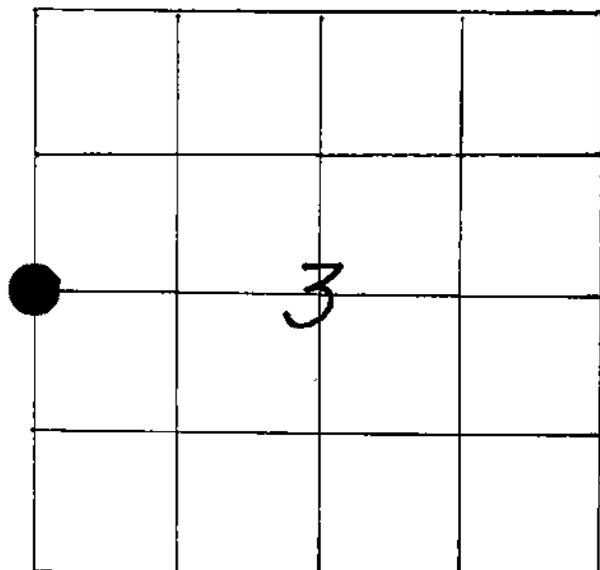

WISCONSIN COORDINATE SYSTEM

North

East

Theta Angle

Horiz. Order

Vert. Order

TYPE OF LANDMARK

3/4" IRON BAR WITH RED PLASTIC CAP.

BEARINGS ARE REFERENCED TO

ASSUMED *NORTH.*

LOCATION OF LANDMARK

CREW: *WILLIAM C. JUNG*
PETER F. FOLLANSBEE
 DATE: *5/02/2003*

Describe any record evidence, monument evidence, testimonial evidence or any other material evidence you considered and whether the monument was found or restored through acceptance of an obliterated evidence location.

In 1991 I resurveyed Section 3. At that time I did not set this corner because it fell in a field. My computed location was at the single proportionate position. Paul Fairchild remeasured the West line of Section 3 this year and checked with my 1991 mile measurement. He then set an iron bar at my computed location out in the field. I drove his bar down 16 inches. I also put one of my red plastic caps on it.


Describe or show any material discrepancy between the location of the restored corner and that of the corner previously restored or reestablished.

NONE KNOWN.


RECORD OF DURABLE WITNESS MONUMENTS

MAGNETIC±

NO	DESCRIPTION	BEARING	DISTANCE
1	SET A 3/4" x 30" IRON BAR AT THE FIELD ROAD INTERS'N	S 30° W ±	328.37 FT.
2	SET A 3/4" x 30" IRON BAR 10' ± INSIDE THE WOODSLINE	N 20° W ±	821.59 FT.
3	SET A 3/4" x 30" IRON BAR 10' ± INSIDE THE WOODSLINE	N 36° E ±	502.49 FT.
4	SET A 3/4" x 30" IRON BAR 10' ± INSIDE THE WOODSLINE	N 66° E ±	550.89 FT.

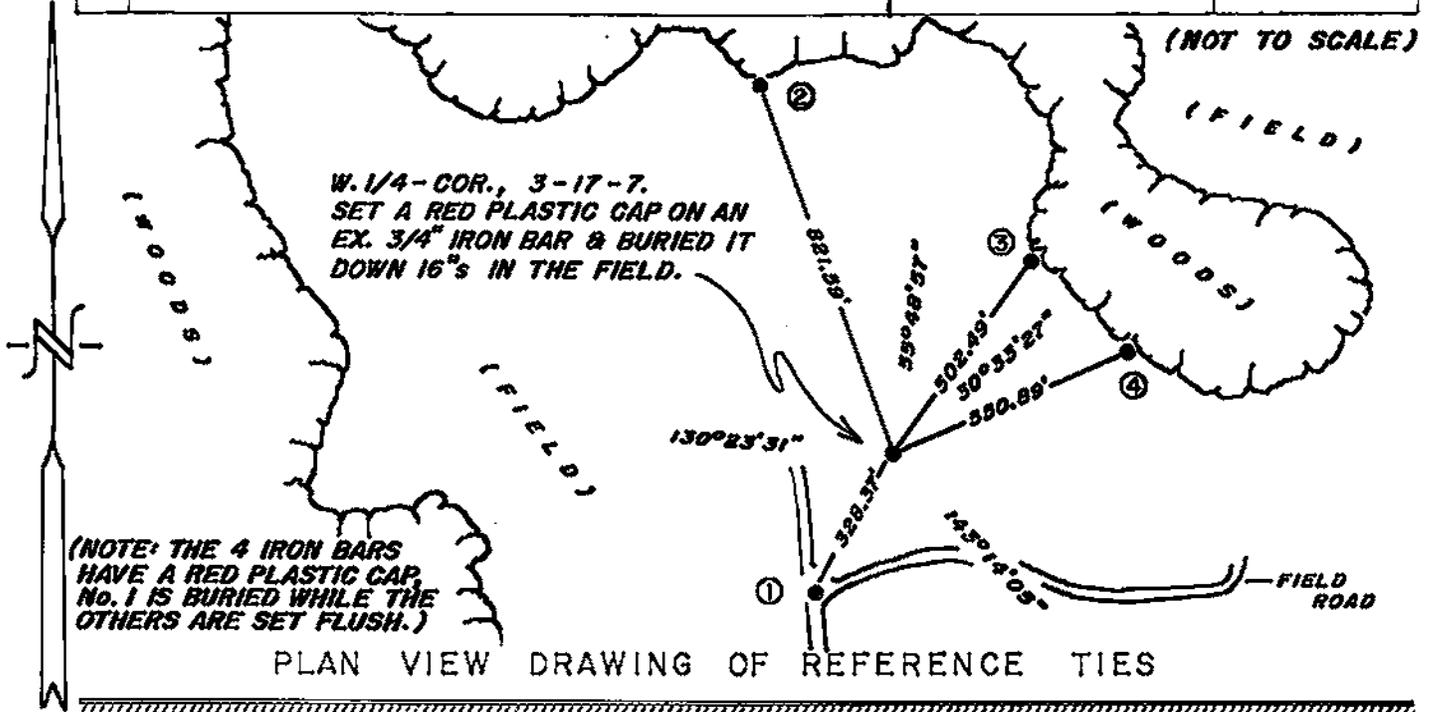

MAP SHOWING DISTANCE AND DIRECTION TO OTHER PUBLIC LAND SURVEY CORNERS USED FOR REESTABLISHING THE CORNER

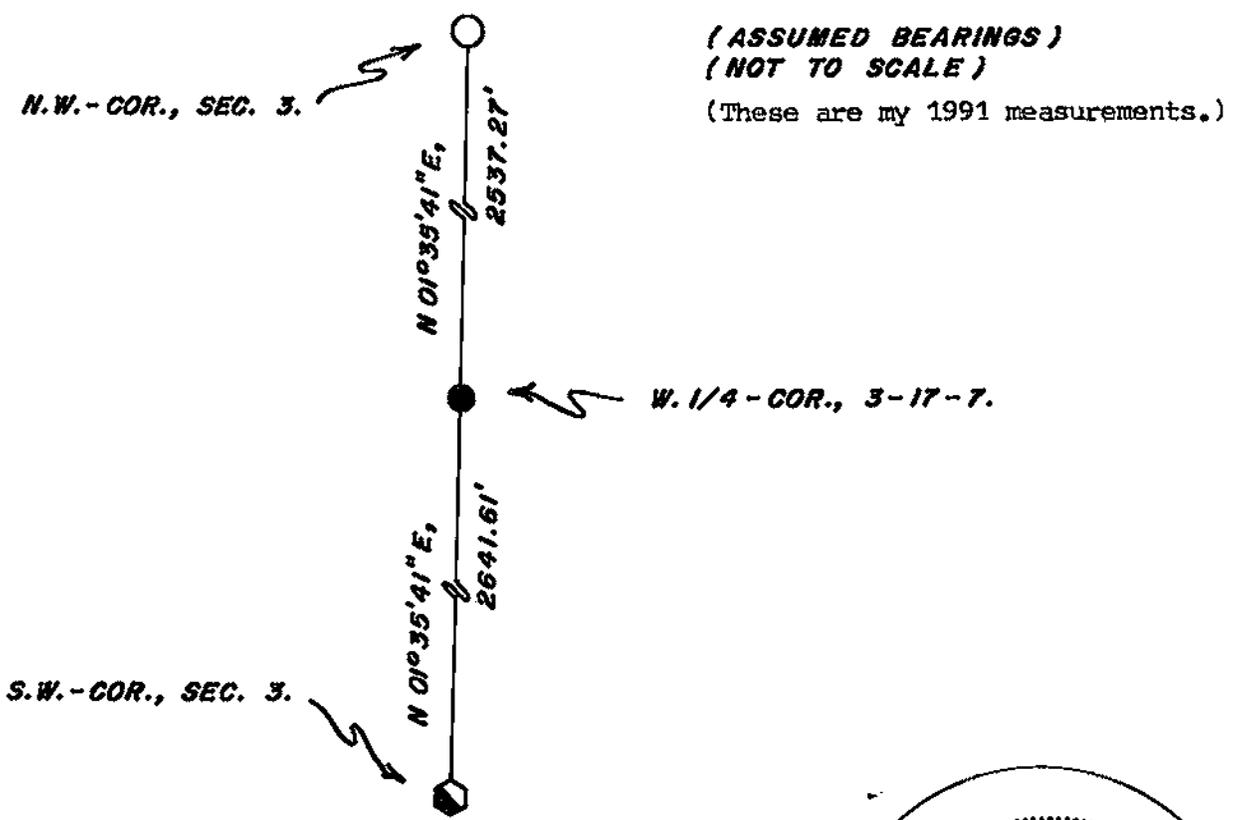

I, WILLIAM G. JUNG, COUNTY SURVEYOR
HEREBY CERTIFY THAT THE CORNER LOCATION SHOWN ON THIS RECORD WAS DETERMINED BY ME OR UNDER MY DIRECTION AND CONTROL AND THAT THIS U. S. PUBLIC LAND SURVEY MONUMENT RECORD IS CORRECT AND COMPLETE TO THE BEST OF MY KNOWLEDGE AND BELIEF.

William C. Jung 6/27/03
Signature Date



Seal