


21707050000

## U. S. PUBLIC LAND SURVEY MONUMENT RECORD

SECTION 9 T 17 N, R 7 W, TOWN OF ONALASKA

LA CROSSE COUNTY

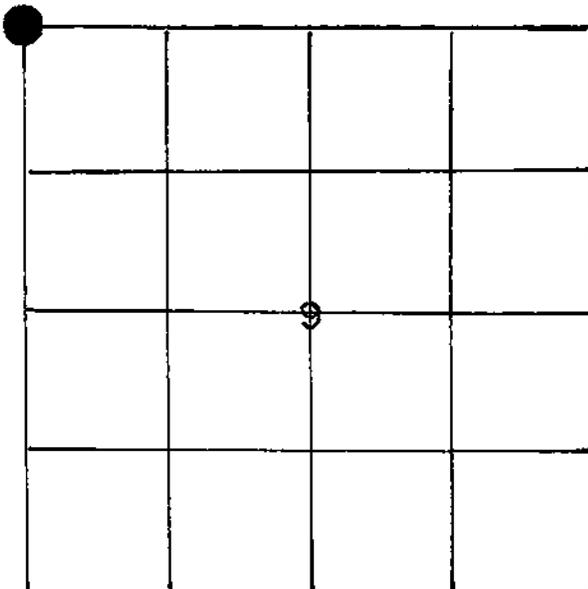

LOCATION OF LANDMARK

Crew: William Jung  
Perry Dahl

3/28/85

Describe any record evidence, monument evidence, testimonial evidence or any other material evidence you considered and whether the monument was found or restored through acceptance of an obliterated evidence location.

In August of 1982 Dick Berg shows a spike at this corner. He used this as the corner for work in Sections 8 and 9. I accepted this point as the best available evidence of the original government corner, removed the nail, and set a Berntsen on the North side of a post where the old post used to be. Howard Erickson, a local resident, agreed that this old occupied corner was the accepted section corner.

Describe or show any material discrepancy between the location of the restored corner and that of the corner previously restored or reestablished.

None known.

WISCONSIN COORDINATE SYSTEM

North

East

Theta Angle

Horiz. Order

Vert. Order

TYPE OF LANDMARK


Berntsen monument

BEARINGS ARE REFERENCED TO


Assumed

RECORD OF DURABLE WITNESS MONUMENTS

NO	DESCRIPTION	BEARING	DISTANCE
1	Set a 1 1/4" iron pipe	West $\pm$	15.63
2	Set a 1 1/4" iron pipe	East $\pm$	17.66
3	Set a 1 1/4" iron pipe	South $\pm$	16.85
4			

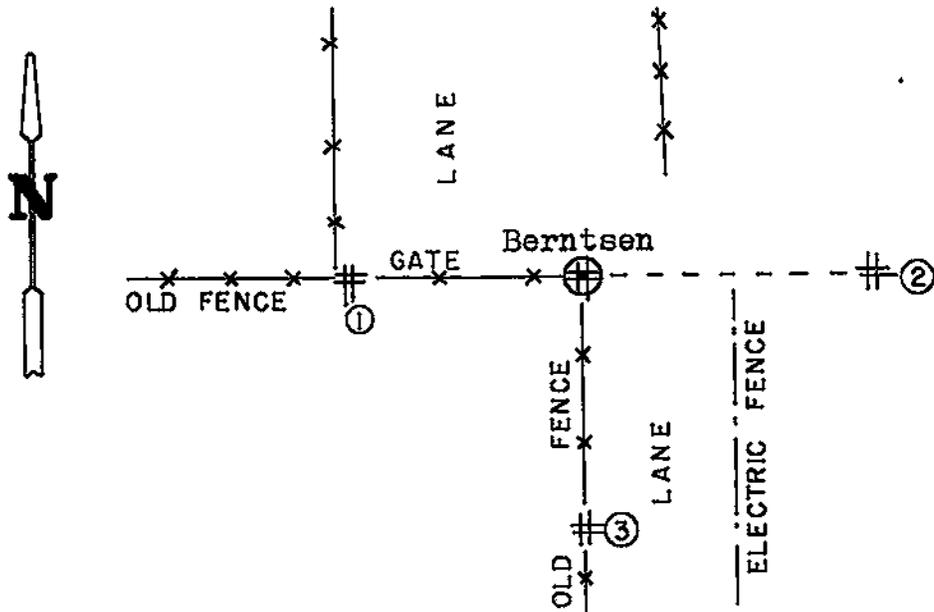


PLAN VIEW DRAWING OF REFERENCE TIES

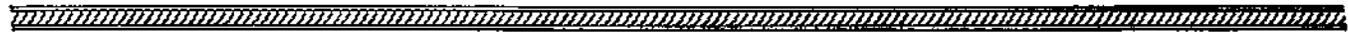

MAP SHOWING DISTANCE AND DIRECTION TO OTHER PUBLIC LAND SURVEY CORNERS USED FOR REESTABLISHING THE CORNER

(Not to scale)

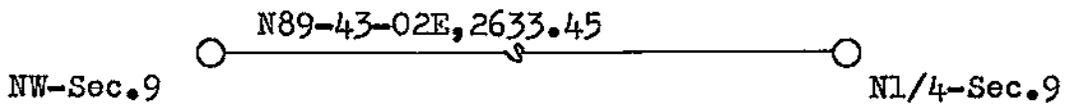

I, William C. Jung, Deputy County Surveyor,  
 HEREBY CERTIFY THAT THE CORNER LOCATION SHOWN ON THIS RECORD  
 WAS DETERMINED BY ME OR UNDER MY DIRECTION AND CONTROL AND  
 THAT THIS U. S. PUBLIC LAND SURVEY MONUMENT RECORD IS CORRECT  
 AND COMPLETE TO THE BEST OF MY KNOWLEDGE AND BELIEF.

William C. Jung  
 Signature

2/4/86  
 Date



Seal