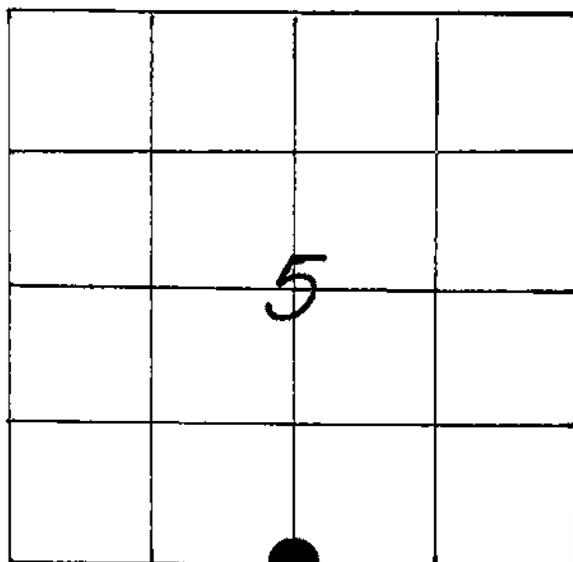


21707050020

U. S. PUBLIC LAND SURVEY MONUMENT RECORD

SECTION 5 T 17 N, R 7 W, TOWN OF ONALASKA

LA CROSSE COUNTY

LAT. = 43°58'13.89801" N
LONG. = 91°14'26.22420" W

LOCATION OF LANDMARK

CREW: WILLIAM C. JUNG
PETER F. FOLLANSBEE
DATE: 5/13/2008

WISCONSIN COORDINATE SYSTEM	
North	720,644.573
East	1,641,896.316
Theta Angle	
Horiz. Order	
Vert. Order	
DATUM:	1983('91)
TYPE OF LANDMARK	
1-1/4" IRON BAR	
BEARINGS ARE REFERENCED TO GRID NORTH AS PER SECTION DATA.	

Describe any record evidence, monument evidence, testimonial evidence or any other material evidence you considered and whether the monument was found or restored through acceptance of an obliterated evidence location.


There was a pipe on record at this corner that had been used as the corner in several previous surveys. I did not find a pipe but found an iron bar that fits the corner location. I accepted the bar as the correct corner.

Describe or show any material discrepancy between the location of the restored corner and that of the corner previously restored or reestablished.

NONE KNOWN.


RECORD OF DURABLE WITNESS MONUMENTS

NO	DESCRIPTION	GRID BEARINGS	GROUND DISTANCES
		BEARING	DISTANCE
1	SET A 3/4" x 30" IRON BAR WITH A RED PLASTIC CAP	N 21°36'03" W	714.78 FT.
2	SET A 3/4" x 30" IRON BAR WITH A RED PLASTIC CAP	N 15°47'32" W	691.58 FT.
3	SET A 3/4" x 30" IRON BAR WITH A RED PLASTIC CAP	N 07°31'22" W	674.00 FT.
4	SET A 3/4" x 30" IRON BAR WITH A RED PLASTIC CAP	N 00°09'22" E	670.09 FT.

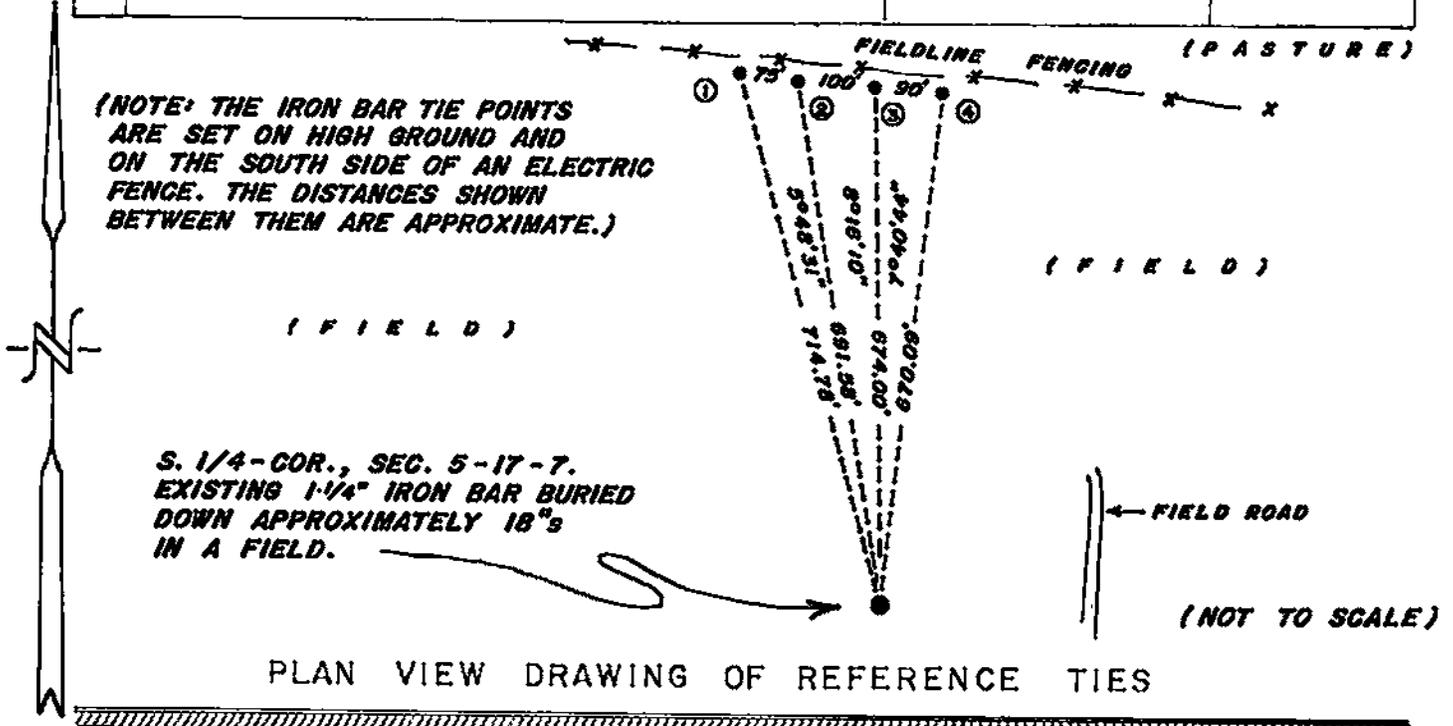


MAP SHOWING DISTANCE AND DIRECTION TO OTHER PUBLIC LAND SURVEY CORNERS USED FOR REESTABLISHING THE CORNER

(GRID BEARINGS AND DISTANCES)
(GRID FACTOR: 0.999948)
(NOT TO SCALE)

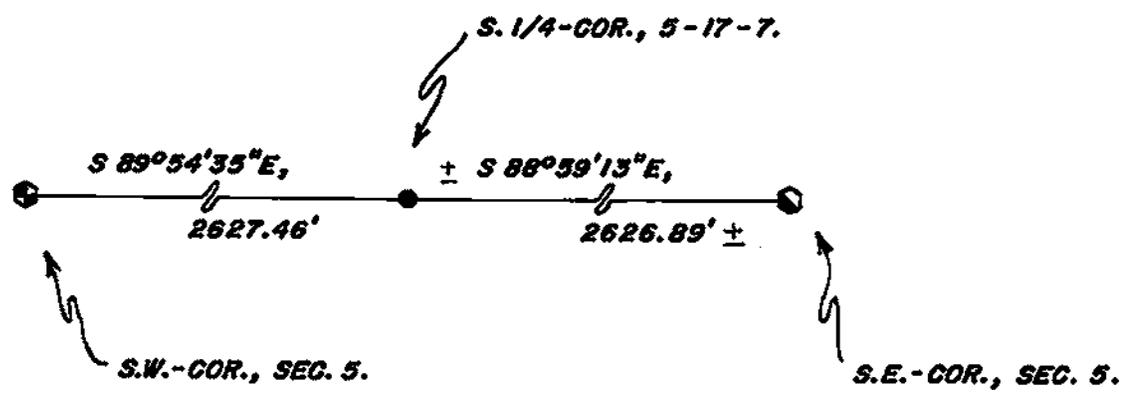

I, WILLIAM C. JUNG, COUNTY SURVEYOR
HEREBY CERTIFY THAT THE CORNER LOCATION SHOWN ON THIS RECORD WAS DETERMINED BY ME OR UNDER MY DIRECTION AND CONTROL AND THAT THIS U. S. PUBLIC LAND SURVEY MONUMENT RECORD IS CORRECT AND COMPLETE TO THE BEST OF MY KNOWLEDGE AND BELIEF.

William C. Jung 6/12/08
Signature Date

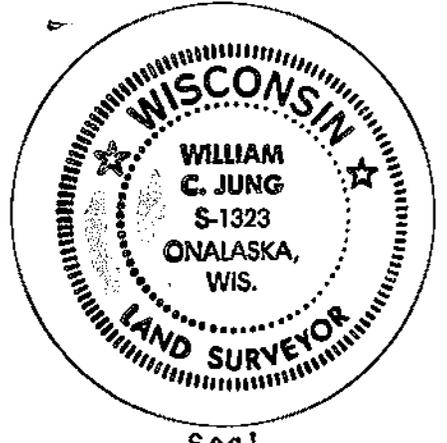

Seal