


21707052000

## U. S. PUBLIC LAND SURVEY MONUMENT RECORD

SECTION 4 T 17 N, R 7 W, TOWN OF HOLLAND/ONALASKA  
 LA CROSSE COUNTY

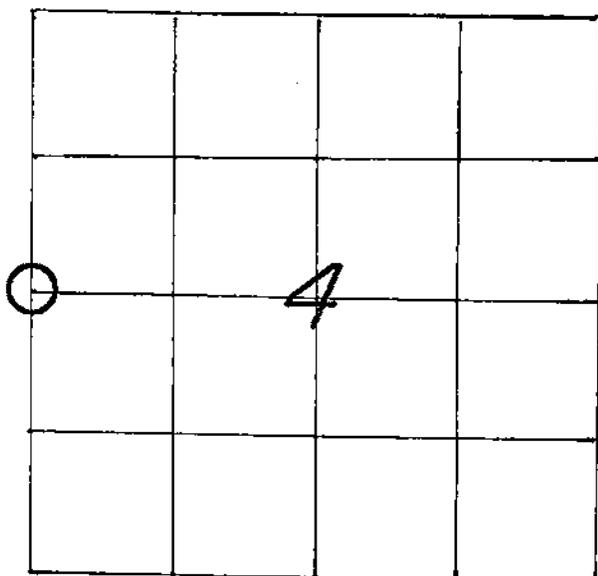

LOCATION OF LANDMARK

CREW: **WILLIAM C. JUNG**  
**PETER F. FOLLANSBEE**  
 DATE: **1/09/2004**

WISCONSIN COORDINATE SYSTEM

North

East

Theta Angle

Horiz. Order

Vert. Order

TYPE OF LANDMARK

**2" IRON PIPE, UP 1.8 FEET.**

BEARINGS ARE REFERENCED TO

Describe any record evidence, monument evidence, testimonial evidence or any other material evidence you considered and whether the monument was found or restored through acceptance of an obliterated evidence location.

I found an iron pipe at the corner that had been used in previous survey work and accepted it as the best available evidence of the original government corner location. Also, I found the original bearing tree to the Northeast. It consisted of the rotted old stump and part of the body of the tree on the ground, also rotted and long dead. The original call fits from the pipe to the tree.

Describe or show any material discrepancy between the location of the restored corner and that of the corner previously restored or reestablished.

**NONE KNOWN.**

