


U. S. PUBLIC LAND SURVEY MONUMENT RECORD

SECTION 7 T 17 N, R 7 W, ~~TOWN OF~~ VILLAGE OF HOLMEN  
 LA CROSSE COUNTY

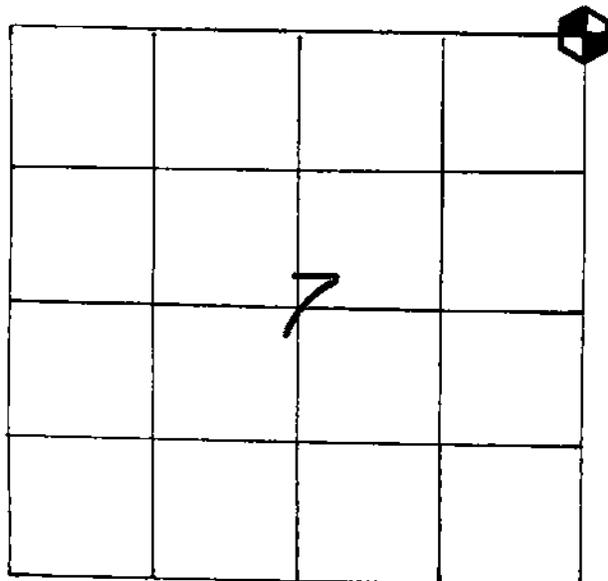

WISCONSIN COORDINATE SYSTEM
North
East
Theta Angle
Horiz. Order
Vert. Order
TYPE OF LANDMARK
<b>BRASS CAP LUNDE MARKER.</b>

BEARINGS ARE REFERENCED TO  
 ASSUMED NORTH AS RECORDED ON  
 THE PLAT OF "LEE ESTATES".

LOCATION OF LANDMARK  
 CREW: WILLIAM C. JUNG  
 PETER F. FOLLANSBEE  
 DATE: 8/01/2007

Describe any record evidence, monument evidence, testimonial evidence or any other material evidence you considered and whether the monument was found or restored through acceptance of an obliterated evidence location.

**WE LOCATED THE LUNDE MARKER WE SET IN 1993 AND TOOK NEW TIE DISTANCES AND BEARINGS.**


Describe or show any material discrepancy between the location of the restored corner and that of the corner previously restored or reestablished.

**NONE KNOWN.**


RECORD OF DURABLE WITNESS MONUMENTS

ASSUMED BEARINGS

NO	DESCRIPTION	BEARING	DISTANCE
1	EXISTING 1-1/4" IRON BAR	S 57°46'41"W	136.48 FT.
2	EXISTING 1-1/4" IRON BAR	S 88°15'37"W	95.07 FT.
3	EXISTING 1-1/4" IRON BAR	S 88°10'33"W	31.94 FT.
4	EXISTING 1" IRON PIPE AT EDGE OF A FIELD	N 44°18'38"W	34.96 FT.

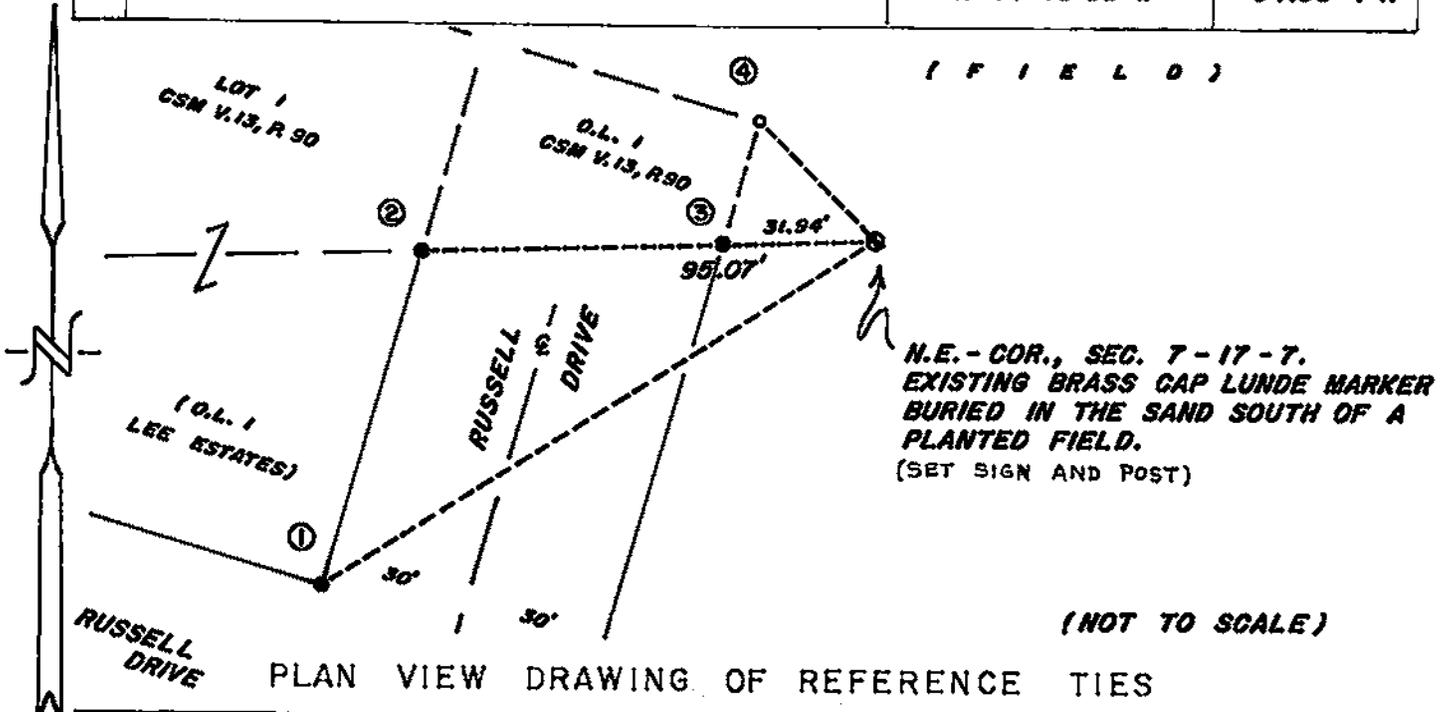

MAP SHOWING DISTANCE AND DIRECTION TO OTHER PUBLIC LAND SURVEY CORNERS USED FOR REESTABLISHING THE CORNER  
(ASSUMED BEARINGS AND DISTANCES AS SHOWN ON THE PLAT OF "LEE ESTATES".)  
(NOT TO SCALE)

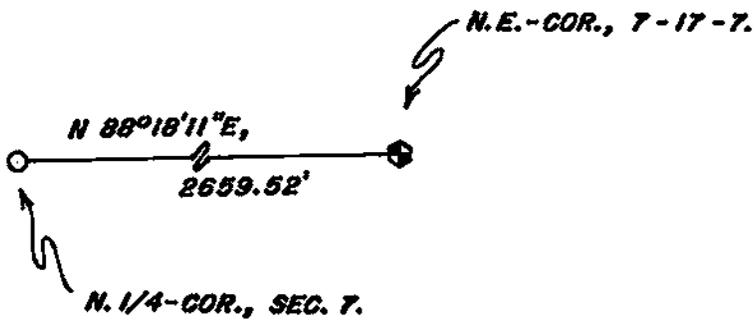

I, WILLIAM C. JUNG, COUNTY SURVEYOR  
HEREBY CERTIFY THAT THE CORNER LOCATION SHOWN ON THIS RECORD WAS DETERMINED BY ME OR UNDER MY DIRECTION AND CONTROL AND THAT THIS U. S. PUBLIC LAND SURVEY MONUMENT RECORD IS CORRECT AND COMPLETE TO THE BEST OF MY KNOWLEDGE AND BELIEF.


William C. Jung 9/10/07  
Signature Date



Seal

U. S. PUBLIC LAND SURVEY MONUMENT RECORD

SECTION 7 T 17 N, R 7 W, TOWN OF VILLAGE OF HOLMEN  
 LA CROSSE COUNTY

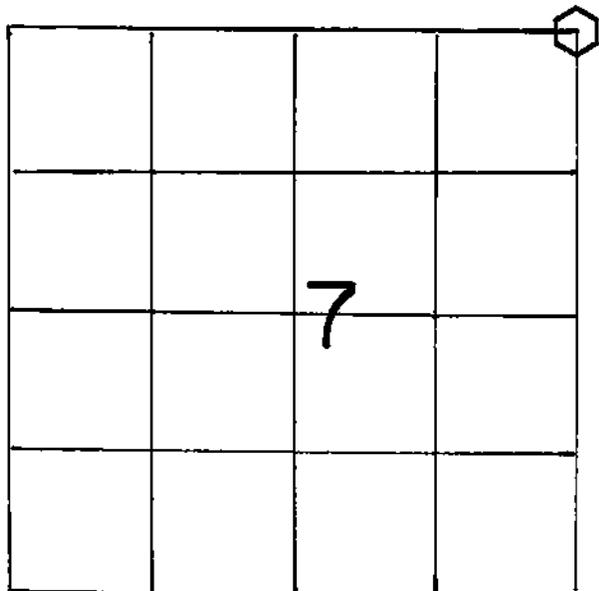

LOCATION OF LANDMARK

WISCONSIN COORDINATE SYSTEM
North
East
Theta Angle
Horiz. Order
Vert. Order
TYPE OF LANDMARK
Brass capped Lunde marker
BEARINGS ARE REFERENCED TO

Crew: William C. Jung  
 Peter F. Follansbee

Date: July 26, 1993

Describe any record evidence, monument evidence, testimonial evidence or any other material evidence you considered and whether the monument was found or restored through acceptance of an obliterated evidence location.

Dave Malak, in his survey for Bethany Heights, set a nail at this corner. This location agrees with Scholze's location and Murphy's old location too. I removed the nail and replaced it with a "breakaway" Lunde marker. I searched the field for other markers but found none.

Describe or show any material discrepancy between the location of the restored corner and that of the corner previously restored or reestablished.

This location falls about 10' East and 12' South of Berg's computed corner. Solberg also used Berg's computed corner.

