


U. S. PUBLIC LAND SURVEY MONUMENT RECORD

SECTION 7 T 17 N, R 7 W, ~~TOWN OF~~ VILLAGE OF HOLMEN
 LA CROSSE COUNTY

Note: These coordinates are from a hwy. plan and were not confirmed by me. Shown (1927 Datum) for informational purposes.

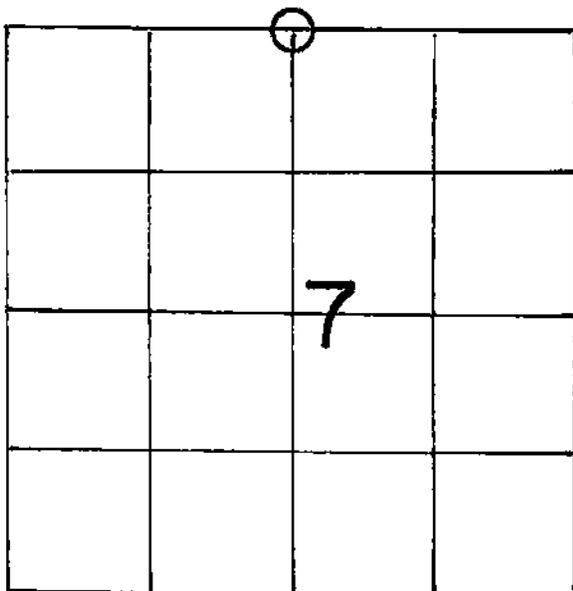

LOCATION OF LANDMARK

WISCONSIN COORDINATE SYSTEM	
North	720,612.932
East	1,668,134.279
Theta Angle	
Horiz. Order	
Vert. Order	
TYPE OF LANDMARK	
Existing 2" Iron Pipe.	
BEARINGS ARE REFERENCED TO	

Crew: WILLIAM C. JUNG
 PETER F. FOLLANSBEE

Date: 7/26/1993

Describe any record evidence, monument evidence, testimonial evidence or any other material evidence you considered and whether the monument was found or restored through acceptance of an obliterated evidence location.


I found an iron pipe that had been used as the corner in previous surveys and accepted it as the best available evidence of the original government corner position. I did not replace it with a Lunde marker because of the close proximity of the utility box.

Describe or show any material discrepancy between the location of the restored corner and that of the corner previously restored or reestablished.

None Known

RECORD OF DURABLE WITNESS MONUMENTS

NO	DESCRIPTION	BEARING	DISTANCE
1	Existing 2 $\frac{1}{4}$ " Iron Pipe (down 10")	West \pm	18.40 Ft.
2	Center of top of 4 $\frac{1}{2}$ " x 4 $\frac{1}{2}$ " Telep. Box(up 9")	Northwesterly \pm	8.22 Ft.
3	Set P.K. Nail in SE-side 17" Cottonwood(unblazed)	North \pm	1.52 Ft.
4	Distance to NE-Cor. 8" x 12" Telephone Box	South \pm	0.61 Ft.

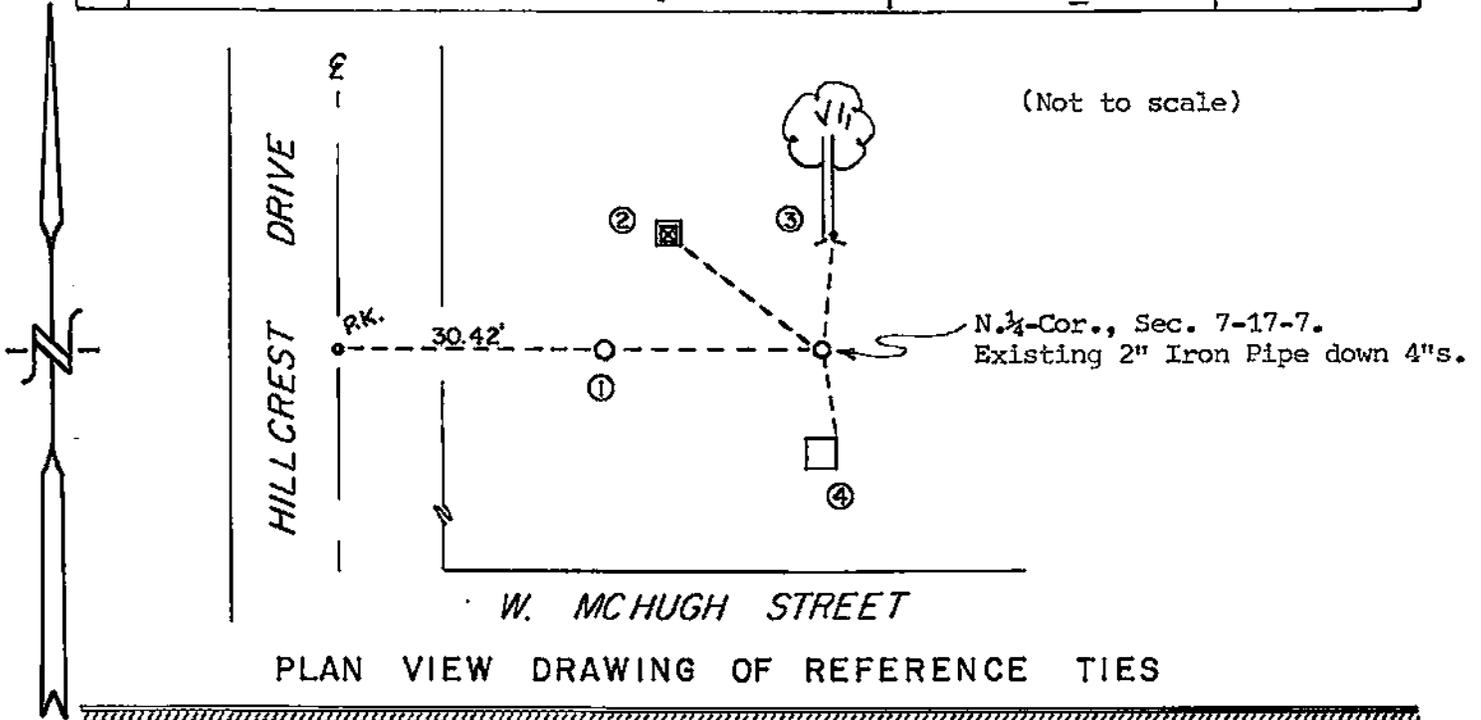

MAP SHOWING DISTANCE AND DIRECTION TO OTHER PUBLIC LAND SURVEY CORNERS USED FOR REESTABLISHING THE CORNER

No section measurements made by me at this time. Position confirmed by previous survey measurement.

I, William C. Jung, County Surveyor
 HEREBY CERTIFY THAT THE CORNER LOCATION SHOWN ON THIS RECORD
 WAS DETERMINED BY ME OR UNDER MY DIRECTION AND CONTROL AND
 THAT THIS U. S. PUBLIC LAND SURVEY MONUMENT RECORD IS CORRECT
 AND COMPLETE TO THE BEST OF MY KNOWLEDGE AND BELIEF.

William C. Jung 1/13/94
 Signature Date



Seal