


21707062000

U. S. PUBLIC LAND SURVEY MONUMENT RECORD

SECTION 6 T 17 N, R 7 W, TOWN OF HOLLAND

LA CROSSE COUNTY

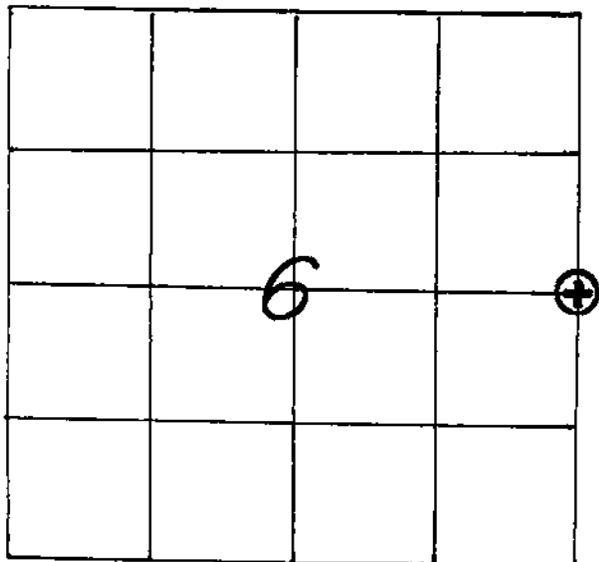

LOCATION OF LANDMARK

CREW: WILLIAM C. JUNG
 PETER F. FOLLANSBEE
 DATE: 4/01/2004

WISCONSIN COORDINATE SYSTEM	
North	723,315.423
East	1,639,318.722
Theta Angle	
Horiz. Order	
Vert. Order	
DATUM:	1983('91)
TYPE OF LANDMARK	
3/4" x 30" IRON BAR WITH AN ALUMINUM CAP.	
BEARINGS ARE REFERENCED TO	
GRID NORTH AS PER SECTION DATA.	

Describe any record evidence, monument evidence, testimonial evidence or any other material evidence you considered and whether the monument was found or restored through acceptance of an obliterated evidence location.


I found a 1 1/4" iron pipe at the corner. It was on the West side of the old corner post. This pipe had been used as the corner in previous surveys. I accepted the pipe as the best available evidence of the original government corner position. I set an iron bar with a cap inside of the existing iron pipe.

Describe or show any material discrepancy between the location of the restored corner and that of the corner previously restored or reestablished.

NONE KNOWN.


RECORD OF DURABLE WITNESS MONUMENTS

NO	DESCRIPTION	BEARING	DISTANCE
1	SET A 3/4" x 30" IRON BAR WITH RED PLASTIC CAP	WEST ±	16.51 FT.
2	BURIED A 3/4" x 30" IRON BAR WITH A RED PLASTIC CAP	NORTH ±	16.54 FT.
3	SET A 3/4" x 30" IRON BAR WITH RED PLASTIC CAP	EAST ±	16.47 FT.
4	BURIED A 3/4" x 30" IRON BAR WITH A RED PLASTIC CAP	SOUTH ±	16.37 FT.

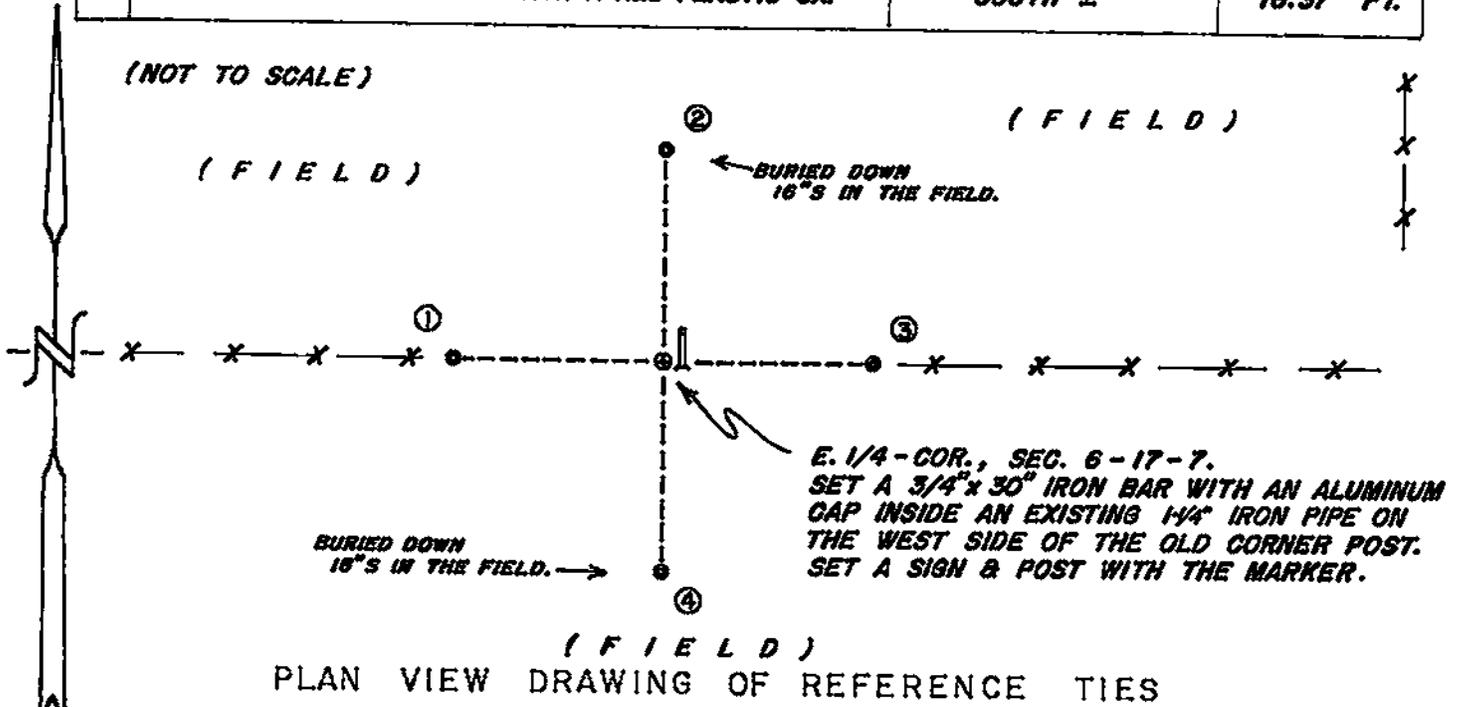

MAP SHOWING DISTANCE AND DIRECTION TO OTHER PUBLIC LAND SURVEY CORNERS USED FOR REESTABLISHING THE CORNER

(GRID BEARINGS AND DISTANCES)
(GRID FACTOR: 0.999948451)
(NOT TO SCALE)

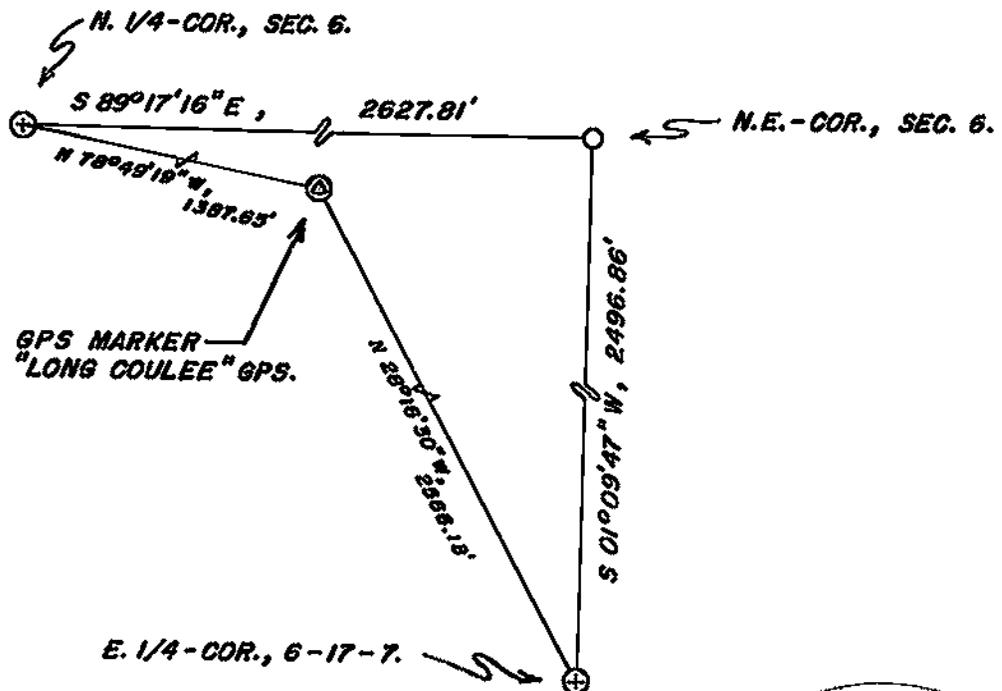

I, WILLIAM C. JUNG, COUNTY SURVEYOR
HEREBY CERTIFY THAT THE CORNER LOCATION SHOWN ON THIS RECORD WAS DETERMINED BY ME OR UNDER MY DIRECTION AND CONTROL AND THAT THIS U. S. PUBLIC LAND SURVEY MONUMENT RECORD IS CORRECT AND COMPLETE TO THE BEST OF MY KNOWLEDGE AND BELIEF.

William C. Jung 11/15/04
Signature Date



Seal