


U. S. PUBLIC LAND SURVEY MONUMENT RECORD

SECTION 18 T 17 N, R 7 W, ~~TOWN~~ OF Holmen Village

LA CROSSE COUNTY

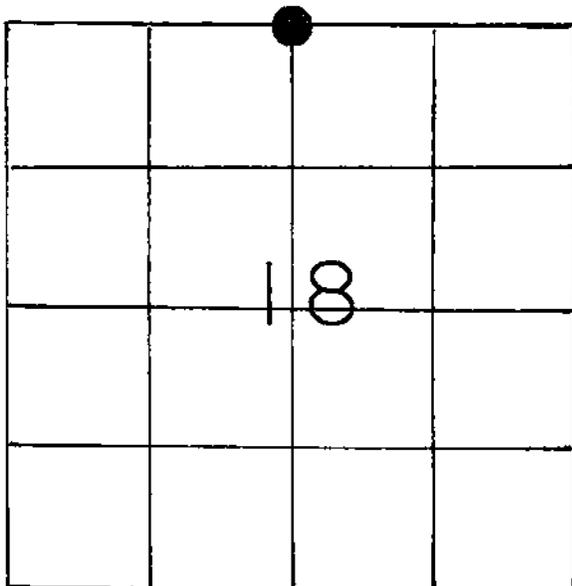

LOCATION OF LANDMARK

Crew: William C. Jung
Peter F. Follansbee

Date: September 6, 1990

WISCONSIN COORDINATE SYSTEM	
North	715,359.326 (as per D.O.T., 1927 datum)
East	1,668,103.652
Theta Angle	
Horiz. Order	
Vert. Order	
TYPE OF LANDMARK	
Brass capped Lunde marker	
BEARINGS ARE REFERENCED TO	
Grid	

Crew: William C. Jung
Peter F. Follansbee

Date: July 30, 1991

Describe any record evidence, monument evidence, testimonial evidence or any other material evidence you considered and whether the monument was found or restored through acceptance of an obliterated evidence location.

On November 19, 1984, I found an existing iron pipe that had been used as the corner in previous surveys. I accepted this iron pipe as the best available evidence of the original government corner position. I set a Berntsen top in the pipe. This corner was destroyed during construction. The D.O.T. then set an iron bar back at the corner. I removed the iron bar and replaced it with a Lunde marker. I buried a bottle with a shell casing on the West side of the Lunde. A post with signs was set to the North. The corner is on a slope.

Describe or show any material discrepancy between the location of the restored corner and that of the corner previously restored or reestablished.


None known.

***** Revision:

On June 24th I removed the Lunde because of pending construction. On July 30th, I reset the Lunde at the corner, reburied the bottle with the shell casing, and also reset the sign and post.

RECORD OF DURABLE WITNESS MONUMENTS


NO	DESCRIPTION	BEARING	DISTANCE
1	D.O.T. monument by post with sign	Grid - N16°09'54"W	Ground - 146.0
2	To the top nut of a fire hydrant	-----	14.43
3	To the bottom bolt of the "yield sign"	-----	48.92
4	To the center of the water shut-off	-----	42.27
5	To DOT R/W marker	-----	131.53

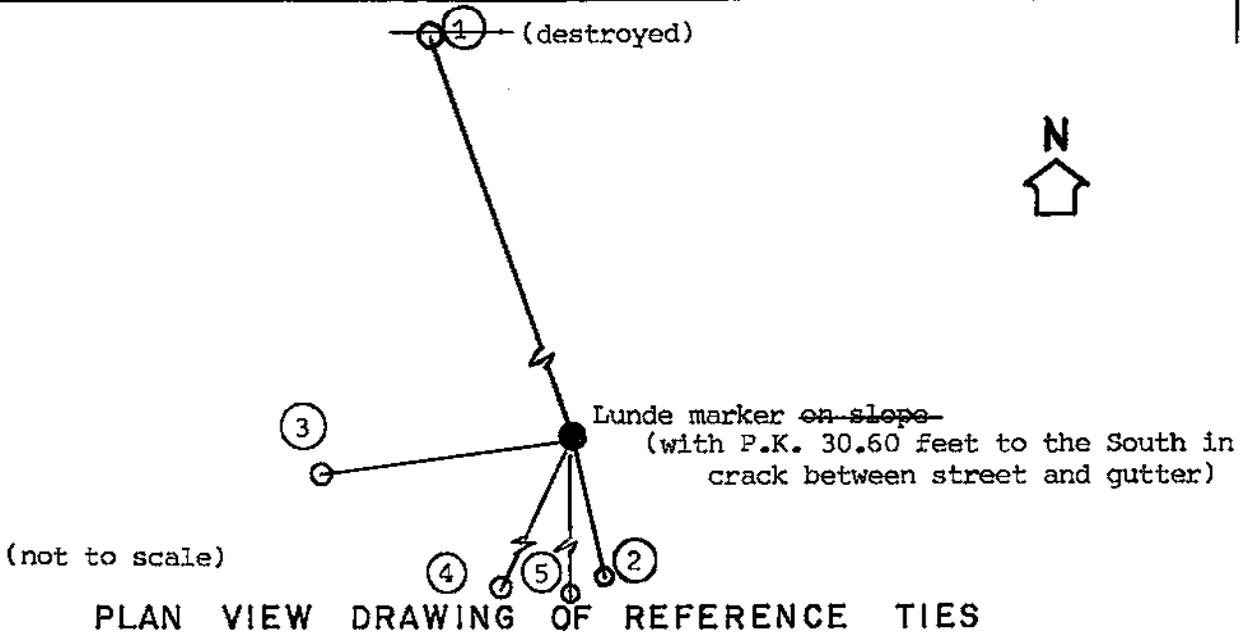

MAP SHOWING DISTANCE AND DIRECTION TO OTHER PUBLIC LAND SURVEY CORNERS USED FOR REESTABLISHING THE CORNER

(not to scale)


Grid bearings and distances as per hwy. plans and Ron Hayden
Grid factor = 0.9999433

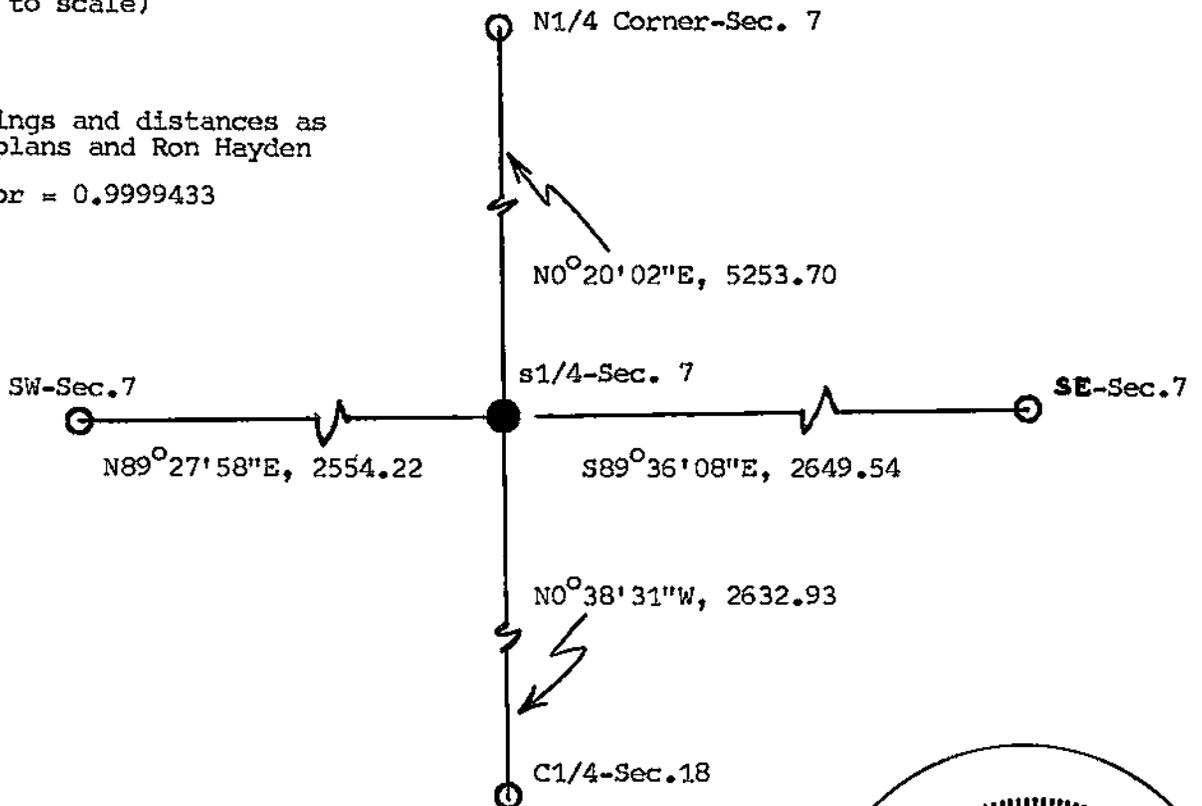

I, William C. Jung, Deputy County Surveyor,
HEREBY CERTIFY THAT THE CORNER LOCATION SHOWN ON THIS RECORD WAS DETERMINED BY ME OR UNDER MY DIRECTION AND CONTROL AND THAT THIS U. S. PUBLIC LAND SURVEY MONUMENT RECORD IS CORRECT AND COMPLETE TO THE BEST OF MY KNOWLEDGE AND BELIEF.

William C. Jung February 13, 1991
Signature Date


Revised: November 7, 1991

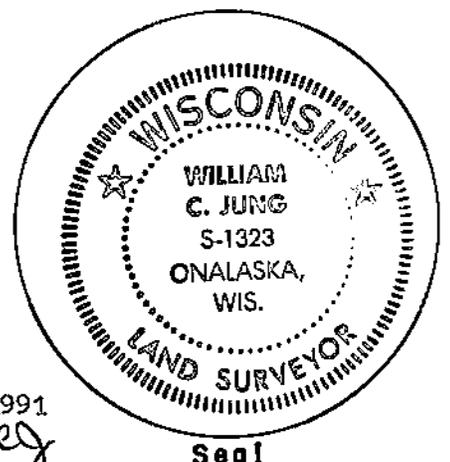

U. S. PUBLIC LAND SURVEY MONUMENT RECORD

SECTION 18 T 17 N, R 7 W, ^{Village} ~~TOWN~~ OF Holmen

LA CROSSE COUNTY

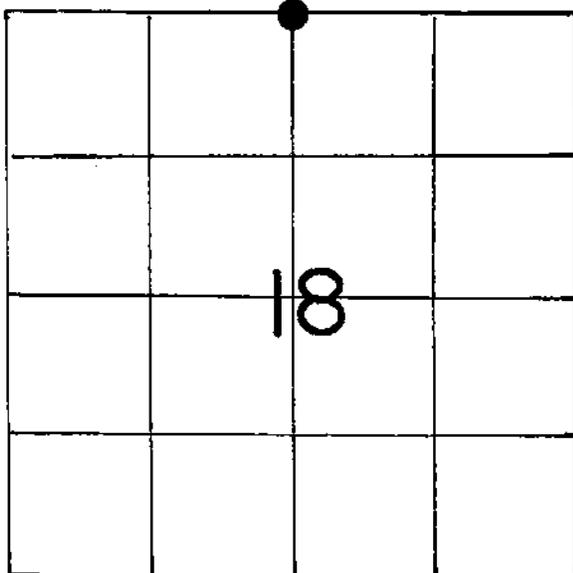

LOCATION OF LANDMARK

Crew: William Jung
 Perry Dahl
 11/19/84

WISCONSIN COORDINATE SYSTEM
North
East
Theta Angle
Horiz. Order
Vert. Order
TYPE OF LANDMARK
<u>Berntsen in pipe</u>
BEARINGS ARE REFERENCED TO
True

Describe any record evidence, monument evidence, testimonial evidence or any other material evidence you considered and whether the monument was found or restored through acceptance of an obliterated evidence location.

I found an existing iron pipe that has been used as the corner in previous surveys. I accepted this iron pipe as the best available evidence of the original government corner position. I set a Berntsen top in the pipe.


Describe or show any material discrepancy between the location of the restored corner and that of the corner previously restored or reestablished.

None known.

VOID


RECORD OF DURABLE WITNESS MONUMENTS

NO	DESCRIPTION	BEARING	DISTANCE
1	Existing 1" Iron Pipe (back of R/W post)	West±	50.6'±
2	Existing 1 1/4" Iron Pipe	South±	150.13'
3	Existing 1" Iron Pipe	East±	120.13'
4	Set P.K. Nail in 19" Single-Blazed Oak	West±	00.55'

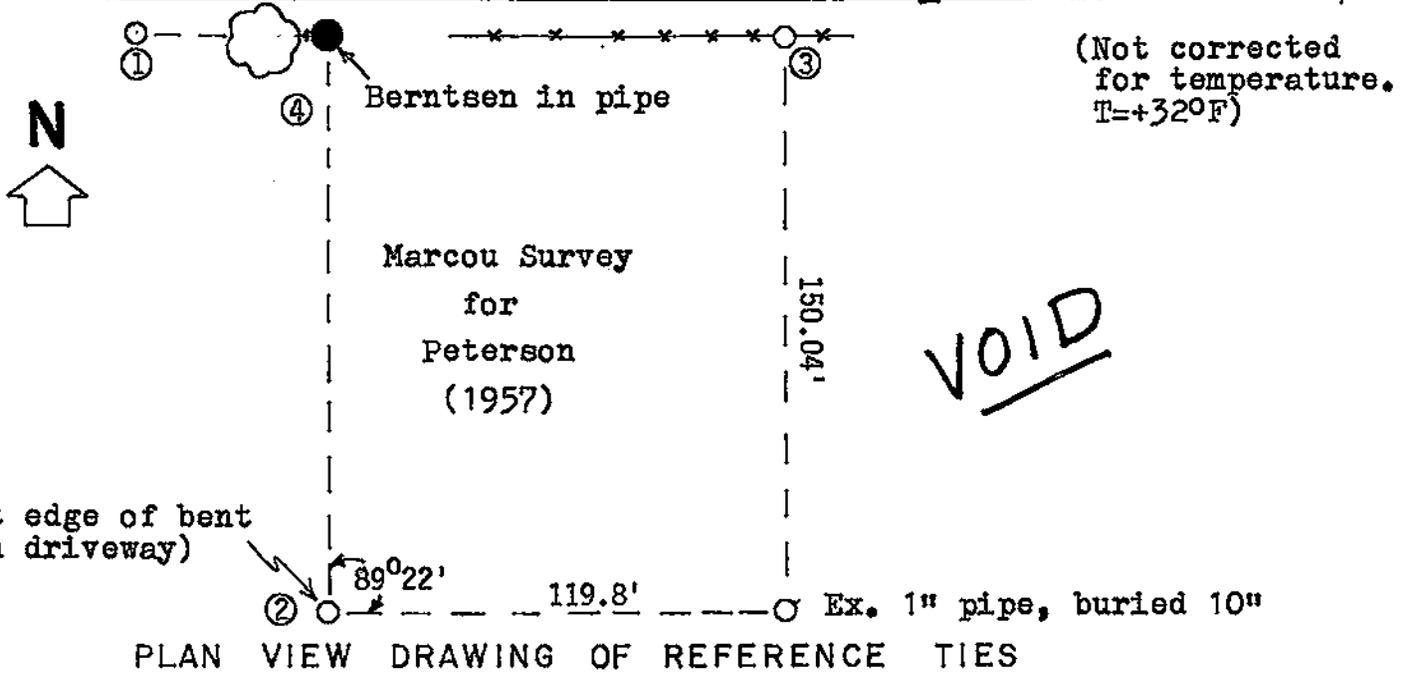

MAP SHOWING DISTANCE AND DIRECTION TO OTHER PUBLIC LAND SURVEY CORNERS USED FOR REESTABLISHING THE CORNER


(not to scale)

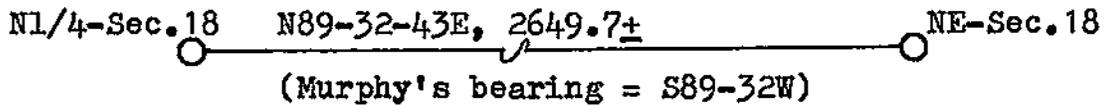

I, William C. Jung, Deputy County Surveyor,
 HEREBY CERTIFY THAT THE CORNER LOCATION SHOWN ON THIS RECORD
 WAS DETERMINED BY ME OR UNDER MY DIRECTION AND CONTROL AND
 THAT THIS U. S. PUBLIC LAND SURVEY MONUMENT RECORD IS CORRECT
 AND COMPLETE TO THE BEST OF MY KNOWLEDGE AND BELIEF.

William C. Jung
 Signature

3/19/86
 Date

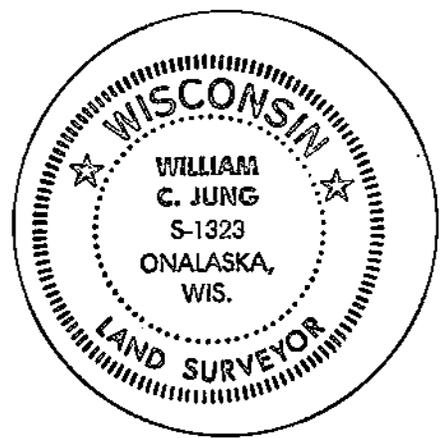

Seal