


21707080000

## U. S. PUBLIC LAND SURVEY MONUMENT RECORD

SECTION 16 T 17 N, R 7 W, TOWN OF ONALASKA  
 LA CROSSE COUNTY

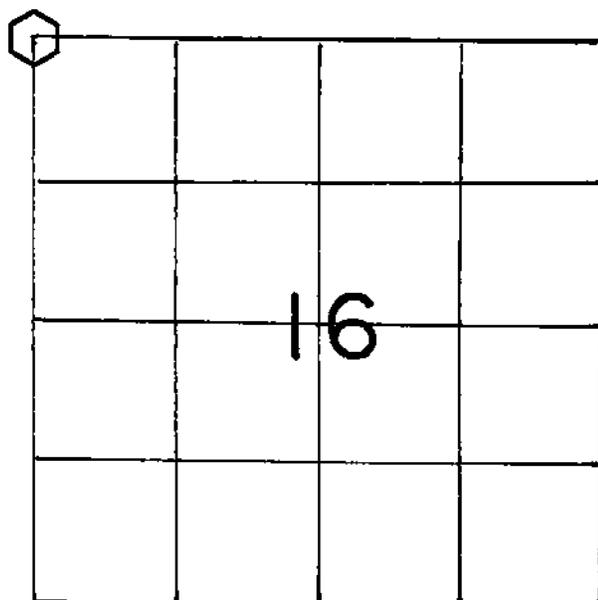

LOCATION OF LANDMARK

Crew: WILLIAM C. JUNG  
 PETER F. FOLLANSBEE

Date: 10/29/1993

Describe any record evidence, monument evidence, testimonial evidence or any other material evidence you considered and whether the monument was found or restored through acceptance of an obliterated evidence location.

An old corner post, with wire tied off North-South, was found at the corner. Paul Fairchild, RLS, and I agree that this post is the best available evidence of the original government corner position. It has been my experience over the years that at a government corner where ownership was only one direction, such as North-South or East-West and no ownership the other direction, landowners normally maintained the old corner post position and tied off their wire at this point. The old post position was monumented with a Lunde marker.

Describe or show any material discrepancy between the location of the restored corner and that of the corner previously restored or reestablished.

6.37' North is an existing nail. The fence to the East is in my opinion a pasture fence, not a line fence. Ownership North and South of this fence has been by one owner for decades. This nail has been used as the section corner in previous survey work. I do not agree that the nail is at the section corner.

WISCONSIN COORDINATE SYSTEM

North

East

Theta Angle

Horiz. Order

Vert. Order

TYPE OF LANDMARK

Set brass cap Lunde marker.

BEARINGS ARE REFERENCED TO

