


21707080020

U. S. PUBLIC LAND SURVEY MONUMENT RECORD

SECTION 8 T 17 N, R 7 W, ~~TOWN OF~~ VILLAGE OF HOLMEN
 LA CROSSE COUNTY

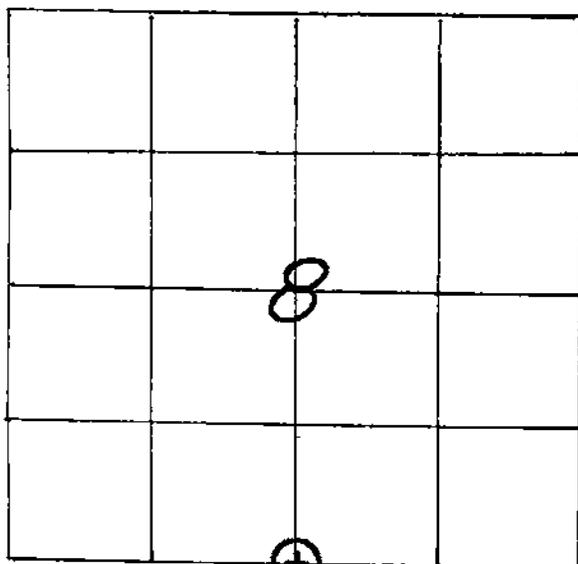

LOCATION OF LANDMARK

CREW: **WILLIAM G. JUNG**
PETER F. FOLLANSBEE
 DATE: **6/30/2006**

WISCONSIN COORDINATE SYSTEM

North

East

Theta Angle

Horiz. Order

Vert. Order

TYPE OF LANDMARK

3/4" x 30" IRON BAR WITH AN ALUMINUM CAP.

BEARINGS ARE REFERENCED TO

ASSUMED NORTH AS PER SECTION DATA.

Describe any record evidence, monument evidence, testimonial evidence or any other material evidence you considered and whether the monument was found or restored through acceptance of an obliterated evidence location.

I found an iron pipe in the old North-South fence. This pipe was of record and had been used as the corner in previous survey work. It is also being used as the corner for the new plat to the Northwest. I accepted the corner by "common report" and set an iron bar with a cap inside of the pipe.


Describe or show any material discrepancy between the location of the restored corner and that of the corner previously restored or reestablished.

NONE KNOWN.

RECORD OF DURABLE WITNESS MONUMENTS

MAGNETIC


NO	DESCRIPTION	BEARING	DISTANCE
1	SET A NAIL IN N.E.-SIDE OF A 12" BASSWOOD	N 55° W	36.80 FT.
2	SET A NAIL IN N.W.-SIDE OF AN 11" HICKORY	S 77° W	SLOPE= 48.13'
3	SET A NAIL IN W.-SIDE OF A 13" WHITE OAK	S 35° W	SLOPE= 39.36'
4	SET A NAIL IN S.W.-SIDE OF AN 11" NUT TREE	S 08° E	32.98 FT.

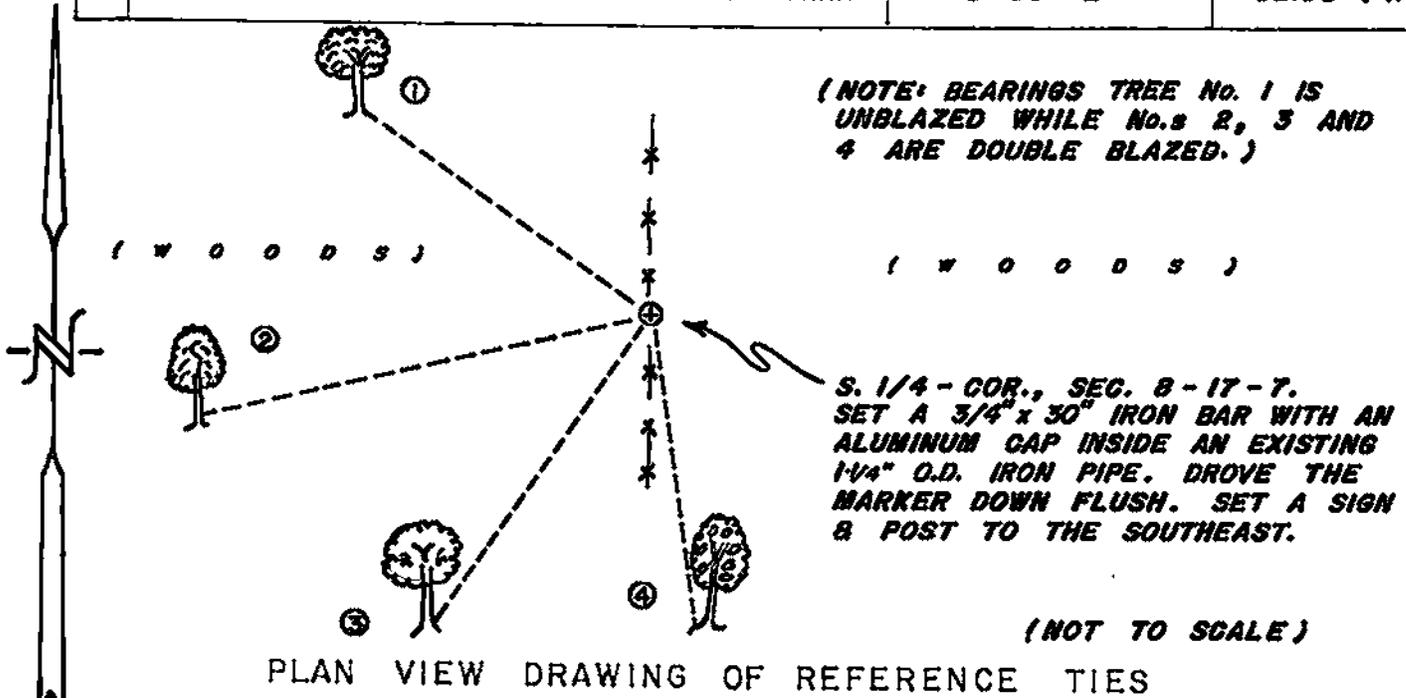

MAP SHOWING DISTANCE AND DIRECTION TO OTHER PUBLIC LAND SURVEY CORNERS USED FOR REESTABLISHING THE CORNER

(NOT TO SCALE)

REG. AS: FROM HOFFMEISTER AND MAXWELL SURVEYS. (ASSUMED NORTH)

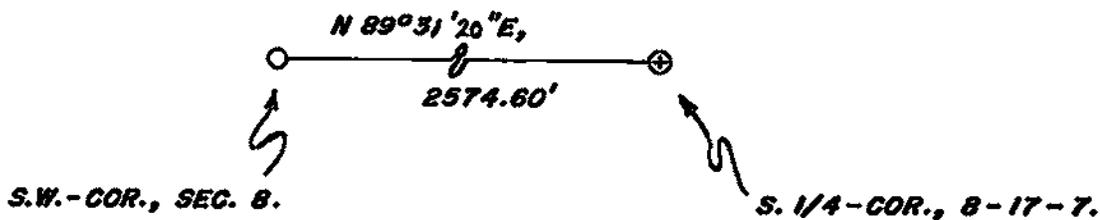

I, WILLIAM C. JUNG, COUNTY SURVEYOR
 HEREBY CERTIFY THAT THE CORNER LOCATION SHOWN ON THIS RECORD WAS DETERMINED BY ME OR UNDER MY DIRECTION AND CONTROL AND THAT THIS U. S. PUBLIC LAND SURVEY MONUMENT RECORD IS CORRECT AND COMPLETE TO THE BEST OF MY KNOWLEDGE AND BELIEF.

William C. Jung 8/2/06
 Signature Date



Seal