


21707082000

U. S. PUBLIC LAND SURVEY MONUMENT RECORD

SECTION 9 T 17 N, R 7 W, TOWN OF ONALASKA
 LA CROSSE COUNTY

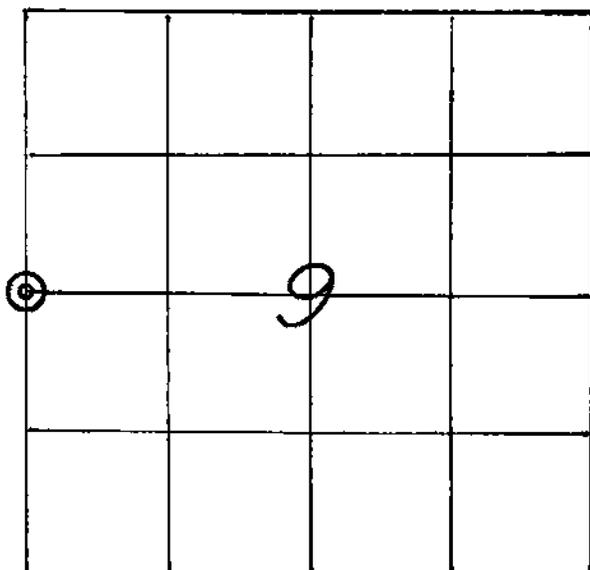

LOCATION OF LANDMARK

Crew: WILLIAM C. JUNG
 PETER F. FOLLANSBEE
 Date: 5/12/1997

Describe any record evidence, monument evidence, testimonial evidence or any other material evidence you considered and whether the monument was found or restored through acceptance of an obliterated evidence location.

Phil Scholze and I discussed this corner at great length and agreed that it should be set by single proportionate measurement. Phil set a p.k. nail at the corner. Pete and I then tied it off.


Describe or show any material discrepancy between the location of the restored corner and that of the corner previously restored or reestablished.

None Known, but it may disagree with a previous corner set or computed by Dick Berg.


WISCONSIN COORDINATE SYSTEM
North
East
Theta Angle
Horiz. Order
Vert. Order
TYPE OF LANDMARK
P.K. Nail in roadway.
BEARINGS ARE REFERENCED TO
TRUE NORTH.

RECORD OF DURABLE WITNESS MONUMENTS

NO	DESCRIPTION	BEARING	DISTANCE
1	Ex. iron bar set by Phil Scholze	Southwesterly ₊	30.01 Ft.
2	Ex. iron bar set by Phil Scholze	North ₊	20.01 Ft.
3	Ex. iron pipe set by Phil Scholze	North ₊	44.95 Ft.
4	Ex. iron bar set by Phil Scholze	Southeasterly ₊	29.99 Ft.

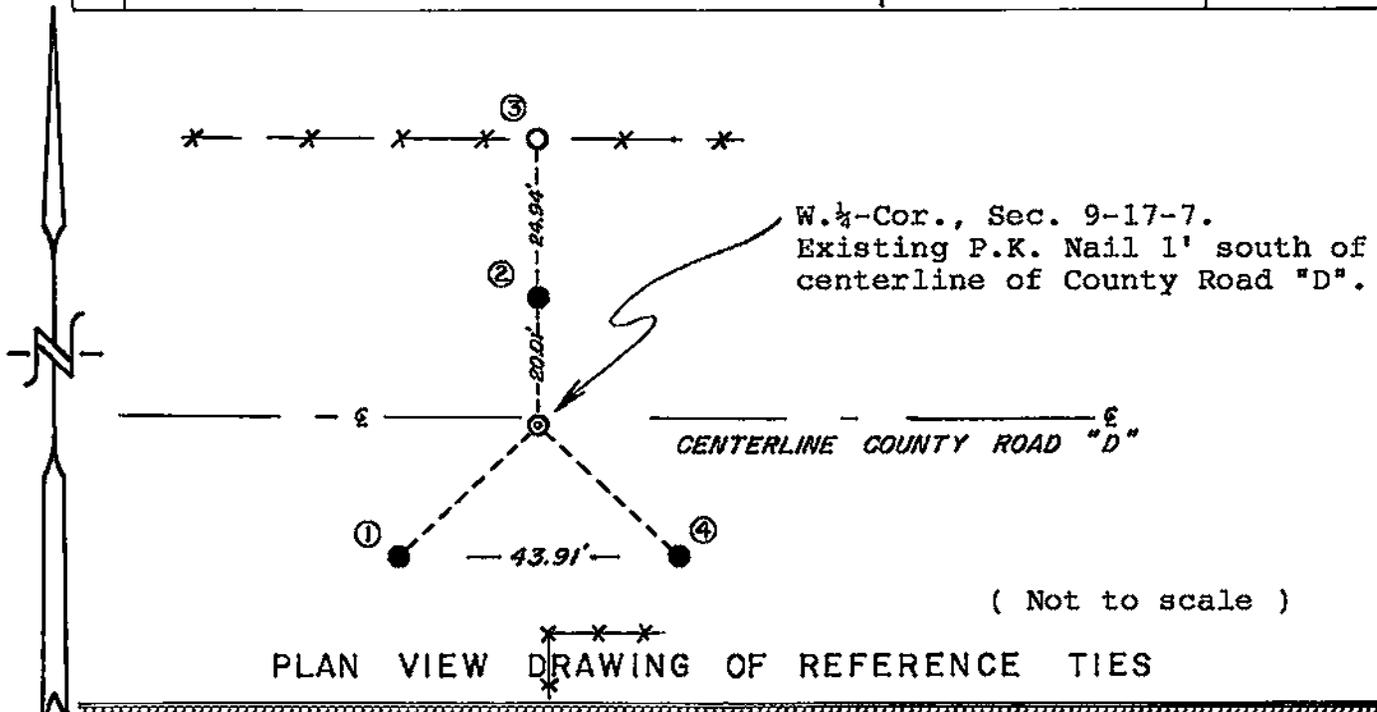


MAP SHOWING DISTANCE AND DIRECTION TO OTHER PUBLIC LAND SURVEY CORNERS USED FOR REESTABLISHING THE CORNER

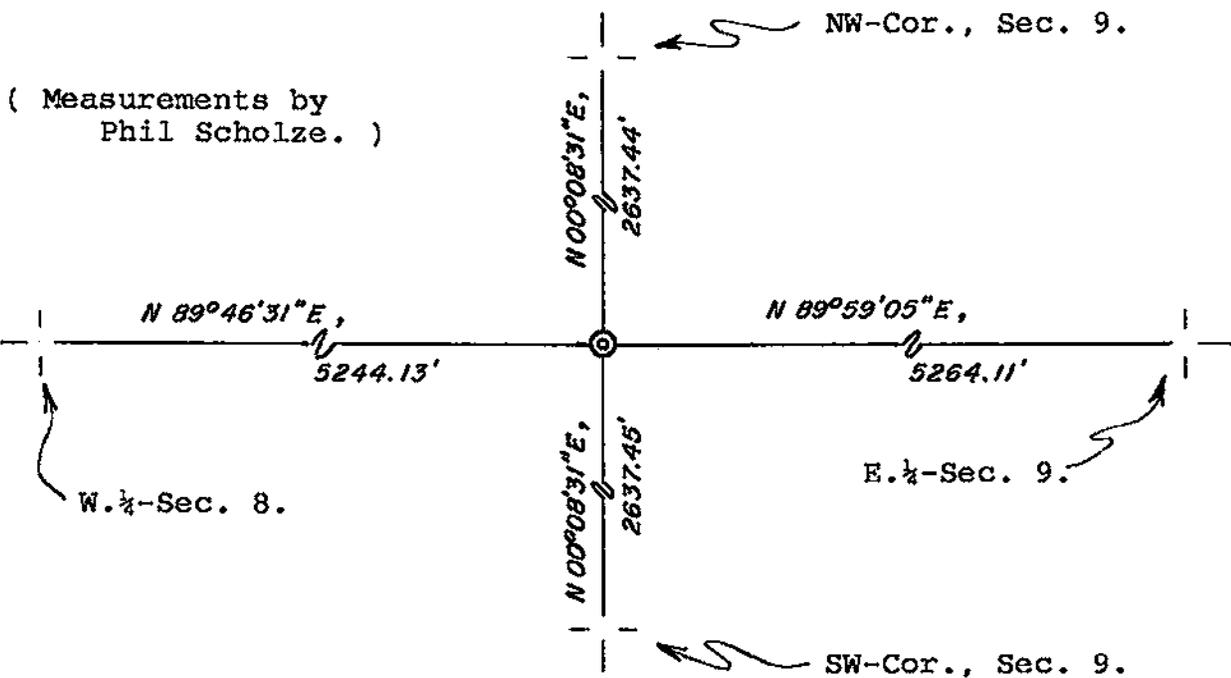

I, William C. Jung, County Surveyor
HEREBY CERTIFY THAT THE CORNER LOCATION SHOWN ON THIS RECORD WAS DETERMINED BY ME OR UNDER MY DIRECTION AND CONTROL AND THAT THIS U. S. PUBLIC LAND SURVEY MONUMENT RECORD IS CORRECT AND COMPLETE TO THE BEST OF MY KNOWLEDGE AND BELIEF.

William C. Jung 1/9/98
Signature Date

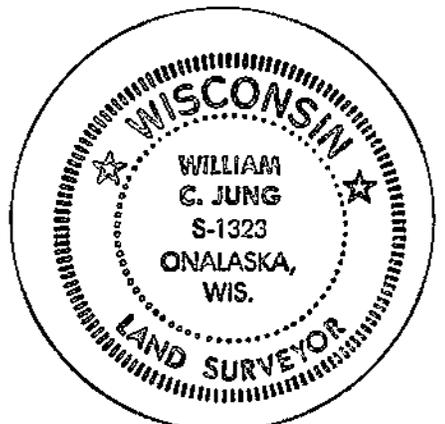

Seal