


21707092000

U. S. PUBLIC LAND SURVEY MONUMENT RECORD

SECTION 10 T 17 N, R 7 W, TOWN OF Onalaska

LA CROSSE COUNTY

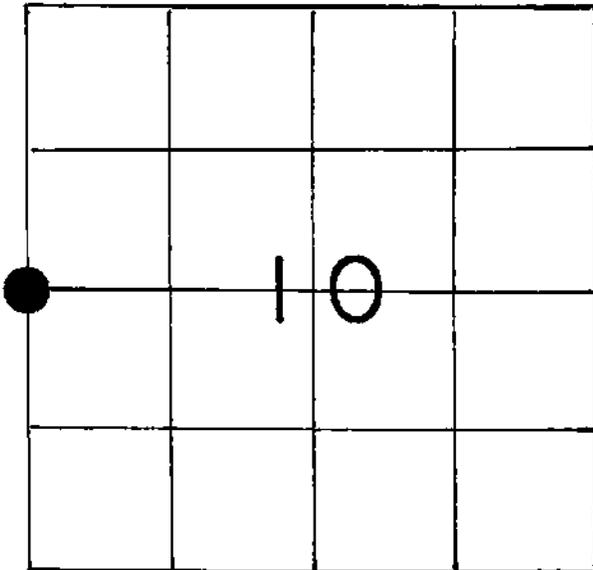

LOCATION OF LANDMARK

Crew: William C. Jung

Date: 5/13/93

WISCONSIN COORDINATE SYSTEM

North

East

Theta Angle

Horiz. Order

Vert. Order

TYPE OF LANDMARK

Brass capped Lunde marker

BEARINGS ARE REFERENCED TO

Describe any record evidence, monument evidence, testimonial evidence or any other material evidence you considered and whether the monument was found or restored through acceptance of an obliterated evidence location.


I found an iron pipe at the old occupied fence corner and accepted it as the best available evidence of the original government corner position. This pipe had been used as the corner by at least three surveyors that I know of. I removed the pipe and replaced it with a Lunde marker. I buried a liquor bottle with a shell casing on the East side and set a post with sign, and steel post, to the Northeast.

Describe or show any material discrepancy between the location of the restored corner and that of the corner previously restored or reestablished.

None known.

RECORD OF DURABLE WITNESS MONUMENTS
Magnetic

NO	DESCRIPTION	BEARING	DISTANCE
1	P.K. in single blazed 22" white oak	N2°W	slope= 40.53
2	" double white oak c=9'4" @ base	N35°E	25.68
3	" 14" white oak	N56°E	28.14
4	" 12" "	S83°E	slope= 38.09

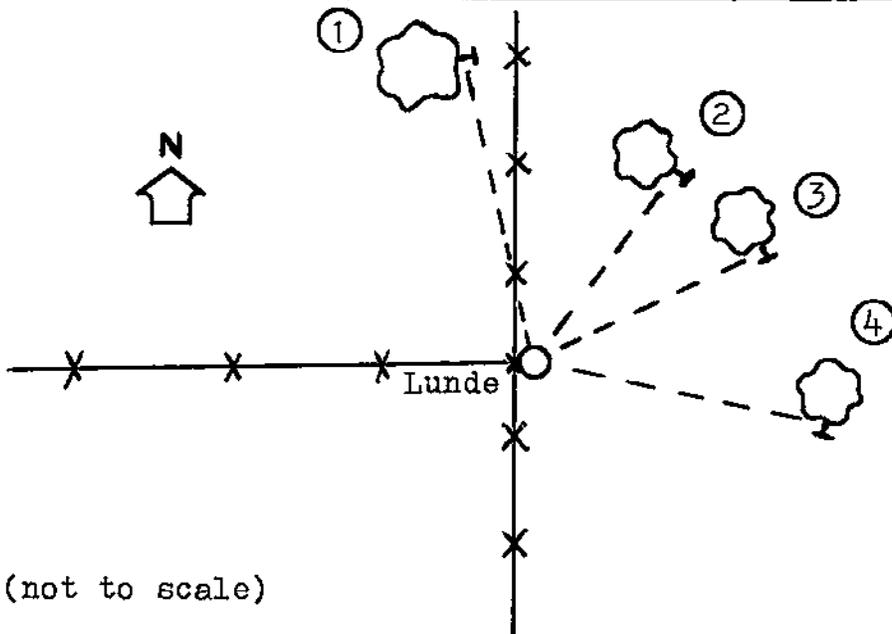

(not to scale)


PLAN VIEW DRAWING OF REFERENCE TIES

MAP SHOWING DISTANCE AND DIRECTION TO OTHER PUBLIC LAND SURVEY CORNERS USED FOR REESTABLISHING THE CORNER

No section measurements made by me at this time. Position confirmed by previous work.

I, William C. Jung, County Surveyor,
HEREBY CERTIFY THAT THE CORNER LOCATION SHOWN ON THIS RECORD
WAS DETERMINED BY ME OR UNDER MY DIRECTION AND CONTROL AND
THAT THIS U. S. PUBLIC LAND SURVEY MONUMENT RECORD IS CORRECT
AND COMPLETE TO THE BEST OF MY KNOWLEDGE AND BELIEF.

William C. Jung 6/8/93
Signature Date

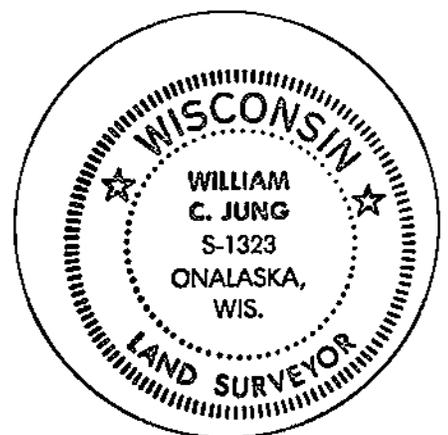

Seal