


21707100000

## U. S. PUBLIC LAND SURVEY MONUMENT RECORD

SECTION 11 T 17 N, R 7 W, TOWN OF ONALASKA

LA CROSSE COUNTY

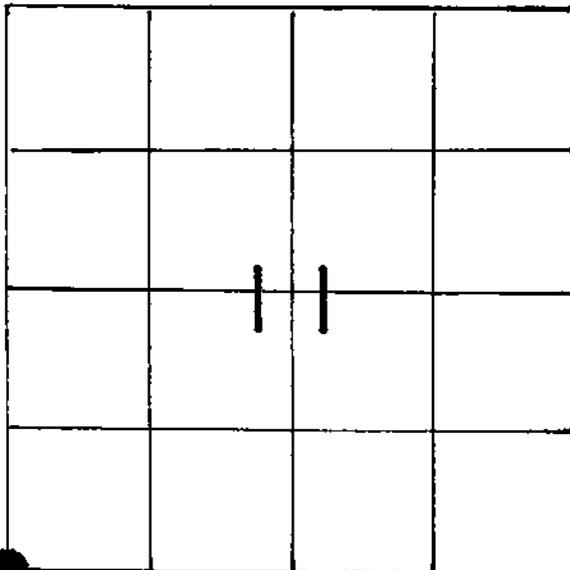

LOCATION OF LANDMARK

Crew: WILLIAM C. JUNG

Date: 5/21/1993

Describe any record evidence, monument evidence, testimonial evidence or any other material evidence you considered and whether the monument was found or restored through acceptance of an obliterated evidence location.

I found a 1/2"x16 1/2" rebar at the old occupied corner location. I found three strands of wire to the South and three strands to the NE as per deed. Found also were the old wire loops indicating that there had been a post here. I accepted the old occupied corner as the best available evidence of the original government corner position. I removed the iron bar and replaced it with a brass capped Lunde marker.

Describe or show any material discrepancy between the location of the restored corner and that of the corner previously restored or reestablished.

S11°16'21"W, 33.42 feet I found a 1 1/4"x38" iron pipe with another pipe 1.82' to the N-NW. The first pipe had been used as the corner in previous surveys. I disagree with this location as my section measurements show it to be way too far South. I removed both pipes. The location appears to be only the SE corner of a pine grove. There was no sign of any East-West occupation, only North. There was nothing to the South.

WISCONSIN COORDINATE SYSTEM

North

East

Theta Angle

Horiz. Order

Vert. Order

TYPE OF LANDMARK

Set brass cap Lunde marker.


BEARINGS ARE REFERENCED TO

True North

RECORD OF DURABLE WITNESS MONUMENTS


NO	DESCRIPTION	MAGNETIC	
		BEARING	DISTANCE
1	Set P.K. Nail in SW-side 8" White Pine	N 39° W	25.51 Ft.
2	Set P.K. Nail in E.-side 7" White Pine	N 04° W	7.23 Ft.
3	Set P.K. Nail in SE-side 9" White Pine	N 24° E	23.37 Ft.
4	Set P.K. Nail in NW-side 16" Box Elder	S 37° W	5.15 Ft.

(slope)

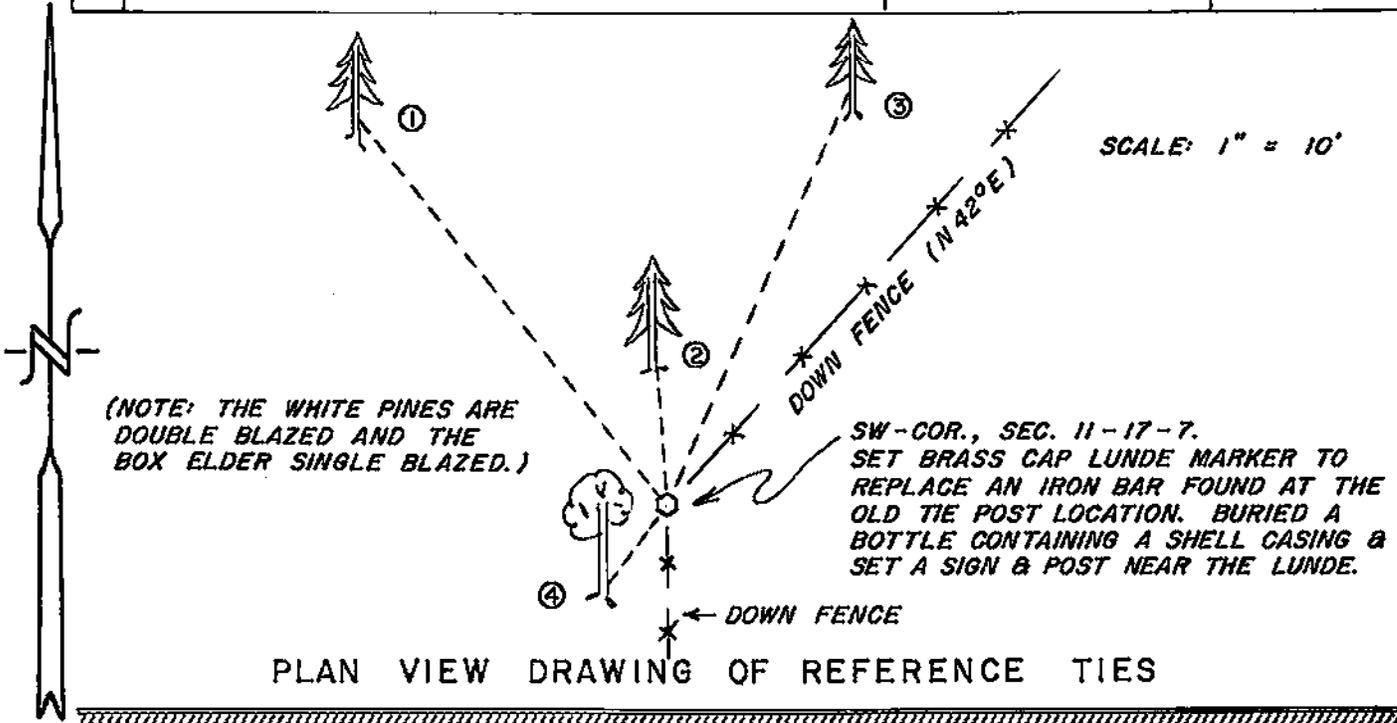

MAP SHOWING DISTANCE AND DIRECTION TO OTHER PUBLIC LAND SURVEY CORNERS USED FOR REESTABLISHING THE CORNER

(not to scale)

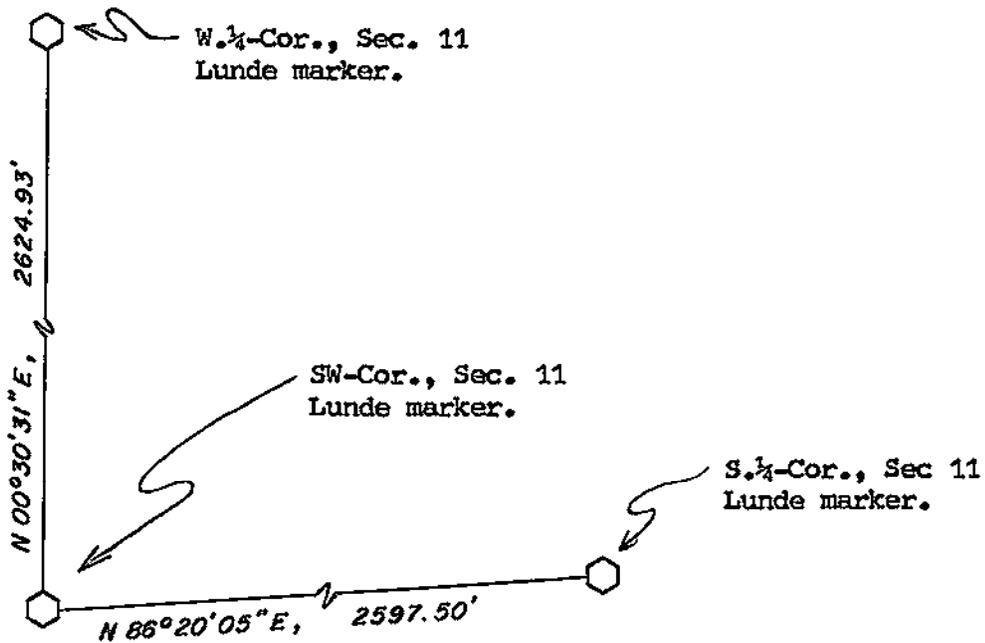

I, William C. Jung, County Surveyor  
HEREBY CERTIFY THAT THE CORNER LOCATION SHOWN ON THIS RECORD WAS DETERMINED BY ME OR UNDER MY DIRECTION AND CONTROL AND THAT THIS U. S. PUBLIC LAND SURVEY MONUMENT RECORD IS CORRECT AND COMPLETE TO THE BEST OF MY KNOWLEDGE AND BELIEF.

William C. Jung  
Signature

2/11/99  
Date



Seal